




ABELL SURVEYING & MAPPING

1140 SEQUOIA STREET • DELAVAN, WISCONSIN 53115
262-728-6737

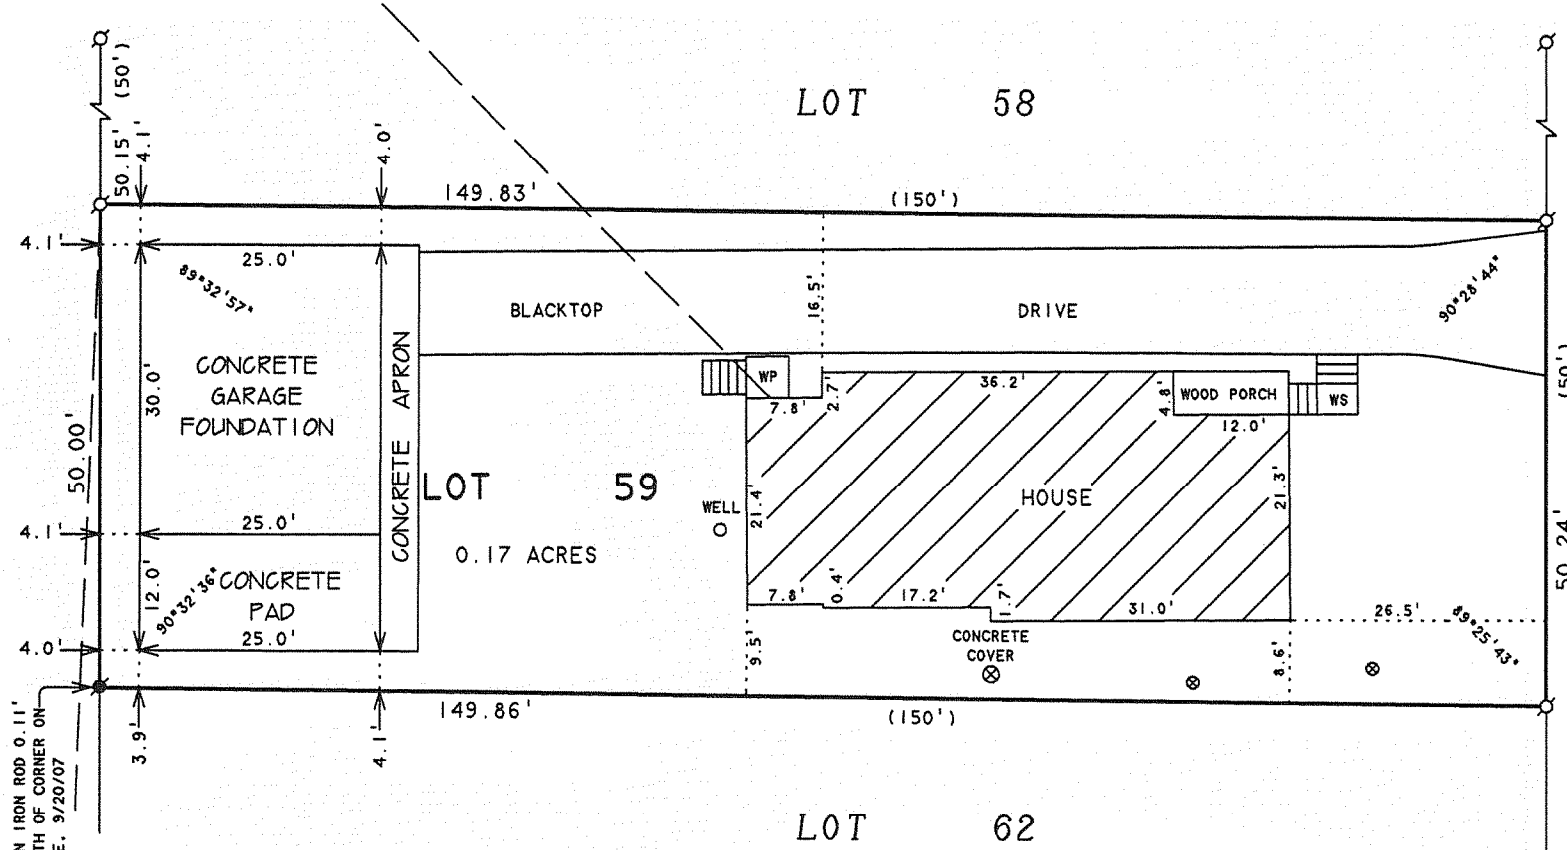

SCALE 1"=20'

LEGEND

- ⊙ - IRON PIPE FOUND
- ⊗ - IRON ROD FOUND
- ⊗ - METAL COVER
- WP - WOOD PORCH
- WS - WOOD STEPS
- - OVERHEAD UTILITY LINES
- () - RECORDED AS

PLAT OF SURVEY OF

LOT 59, LAKE GENEVA BEACH, LOCATED IN
TIN. RIZE, WALWORTH COUNTY, WISCONSIN.

REVISED DATE: SEPTEMBER 20, 2007
REVISED TO SHOW LOCATION OF GARAGE
FOUNDATION, GARAGE APRON AND CONCRETE
PAD.

ORDERED BY: TOM LASKIE
N1727 SPRING ROAD
LAKE GENEVA, WI 53147

I HEREBY CERTIFY THAT I HAVE SURVEYED THE ABOVE DESCRIBED PROPERTY AND THAT THE ABOVE MAP IS A TRUE REPRESENTATION THEREOF AND SHOWS THE SIZE AND LOCATION OF THE PROPERTY, ITS EXTERIOR BOUNDARIES, THE LOCATION OF ALL VISIBLE STRUCTURES AND DIMENSIONS OF ALL PRINCIPAL BUILDINGS THEREON, BOUNDARY FENCES, APPARENT EASEMENTS, ROADWAYS AND VISIBLE ENCROACHMENTS, IF ANY, TO THE BEST OF MY KNOWLEDGE AND BELIEF.


THIS SURVEY IS MADE FOR THE USE OF THE PRESENT OWNERS OF THE PROPERTY, AND ALSO THOSE WHO PURCHASE, MORTGAGE, OR GUARANTEE THE TITLE THERETO WITHIN ONE (1) YEAR FROM DATE HEREON.

David F. Abell

DAVID F. ABELL
WISCONSIN REGISTERED LAND SURVEYOR, S-1596

July 26, 2007

DATE: JOB NUMBER - 93133B
NOTE: THIS IS NOT A CERTIFIED COPY UNLESS SEALED.

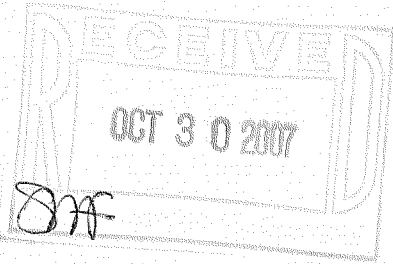

ILGB - 53

117-2865