
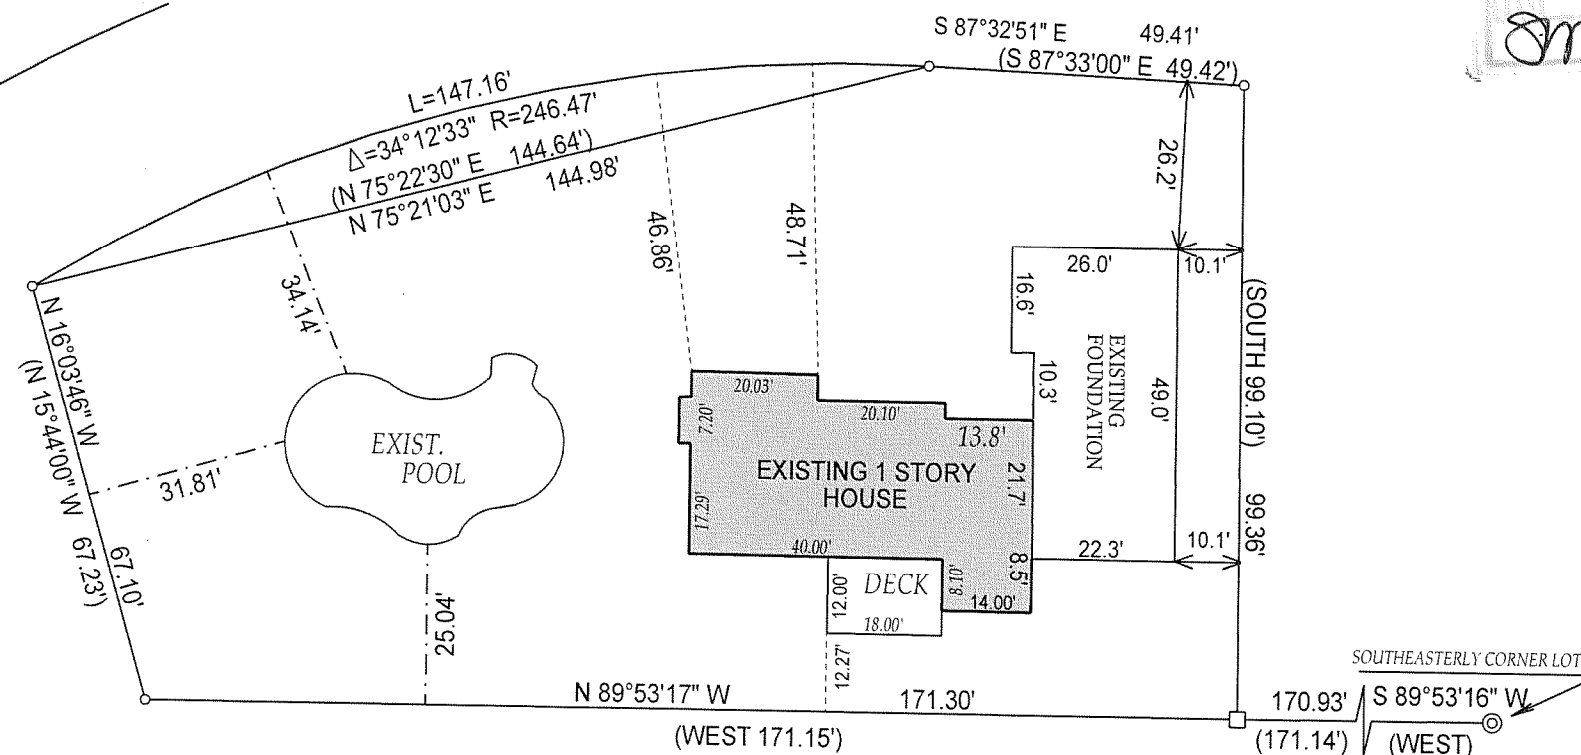


PLAT OF SURVEY

- OF -


PART OF LOT 6, BLOCK 2, IN TRINKE ESTATES, LOCATED IN GOVERNMENT LOT 1, WHICH LOT IS THE SOUTHEAST 1/4 OF THE SOUTHEAST 1/4 AND THE NORTHEAST 1/4 OF THE SOUTHEAST 1/4 OF SECTION 10, TOWNSHIP 1 NORTH, RANGE 17 EAST, TOWN OF LINN, WALWORTH COUNTY, WISCONSIN, BEGINNING AT A POINT IN THE SOUTHERLY BOUNDARY LINE OF LOT NUMBERED 6 OF BLOCK 2, WHICH IS 171.14 FEET IN A WESTERLY DIRECTION FROM THE SOUTHEAST CORNER OF SAID LOT 6, THENCE NORTHERLY AT RIGHT ANGLES TO THE SOUTHERLY BOUNDARY LINE OF SAID LOT 6 TO THE NORTHERLY BOUNDARY LINE OF SAID LOT 6; THENCE SOUTHWESTERLY ALONG THE NORTHERLY BOUNDARY LINE OF SAID LOT 6 TO THE NORTHWESTERLY CORNER OF SAID LOT 6; THENCE SOUTHEASTERLY TO THE SOUTHERLY BOUNDARY LINE OF SAID LOT 6; THENCE EASTERLY ALONG THE SOUTHERLY BOUNDARY LINE OF SAID LOT 6 TO THE PLACE OF BEGINNING.

WILDWOOD DRIVE
(60.00' WIDE)

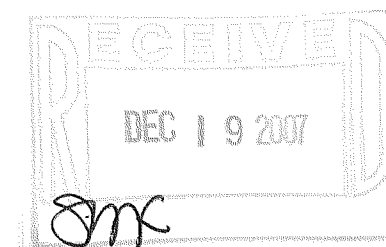

TAX ID # 1-17-ITE-19A

DATED THIS 4 TH, DAY OF APRIL 20 01

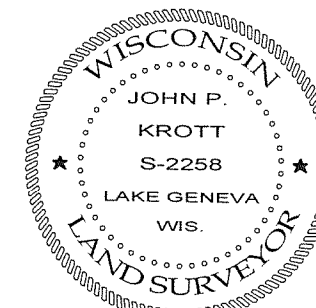

John P. Kne

JOHN KROTT S - 2258
Wisconsin Registered Land Surveyor
(original if signed in red)

117-2885