



59-6

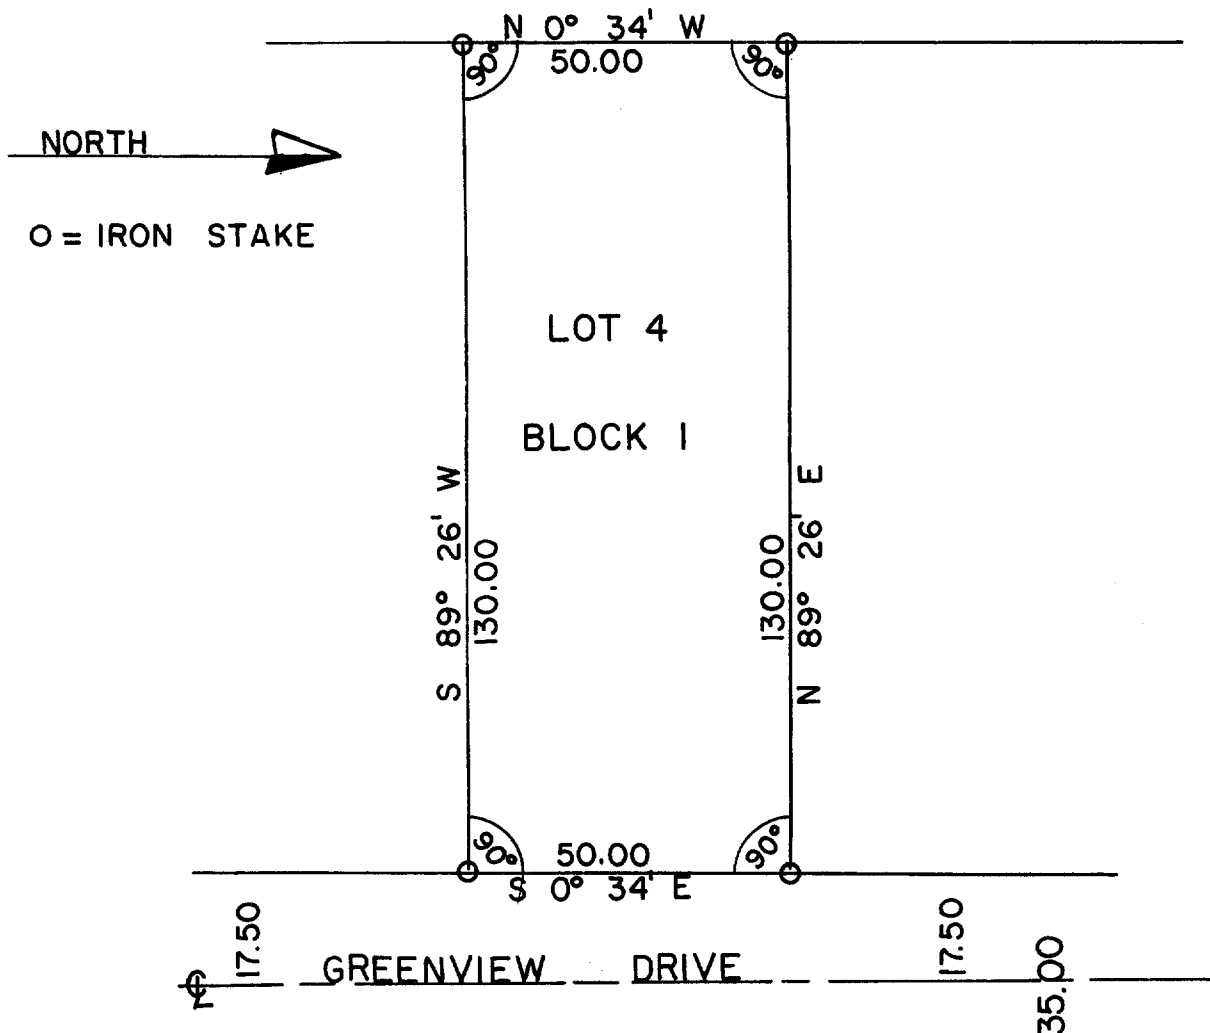

DESCRIPTION: Lot 4 of Block 1 of Sunset Hills Subdivision located in Town 1 North, Range 17 East, in Linn Township, Walworth County, Wisconsin.

CERTIFICATE: I, James F. Biagi, surveyor, hereby certify that I have surveyed the property hereon described on this 10th day of November, 1959.

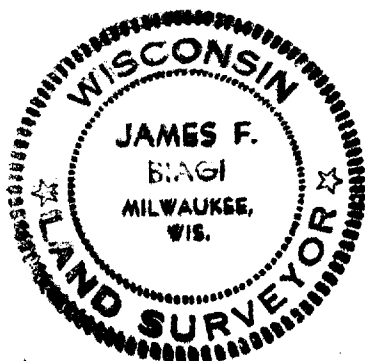

SIGNED

SURVEYOR

*James F. Biagi*

154-4

117-28 B