


Lot 84 of Robinson's Second Subdivision,
located in the Northwest 1/4 of Section 14, Town 1 North, Range
17 East, Town of Linn, Walworth County, Wisconsin.

Surveyed for: **Sam DeSimone**
184 South Street
Elmhurst, Illinois. 60126

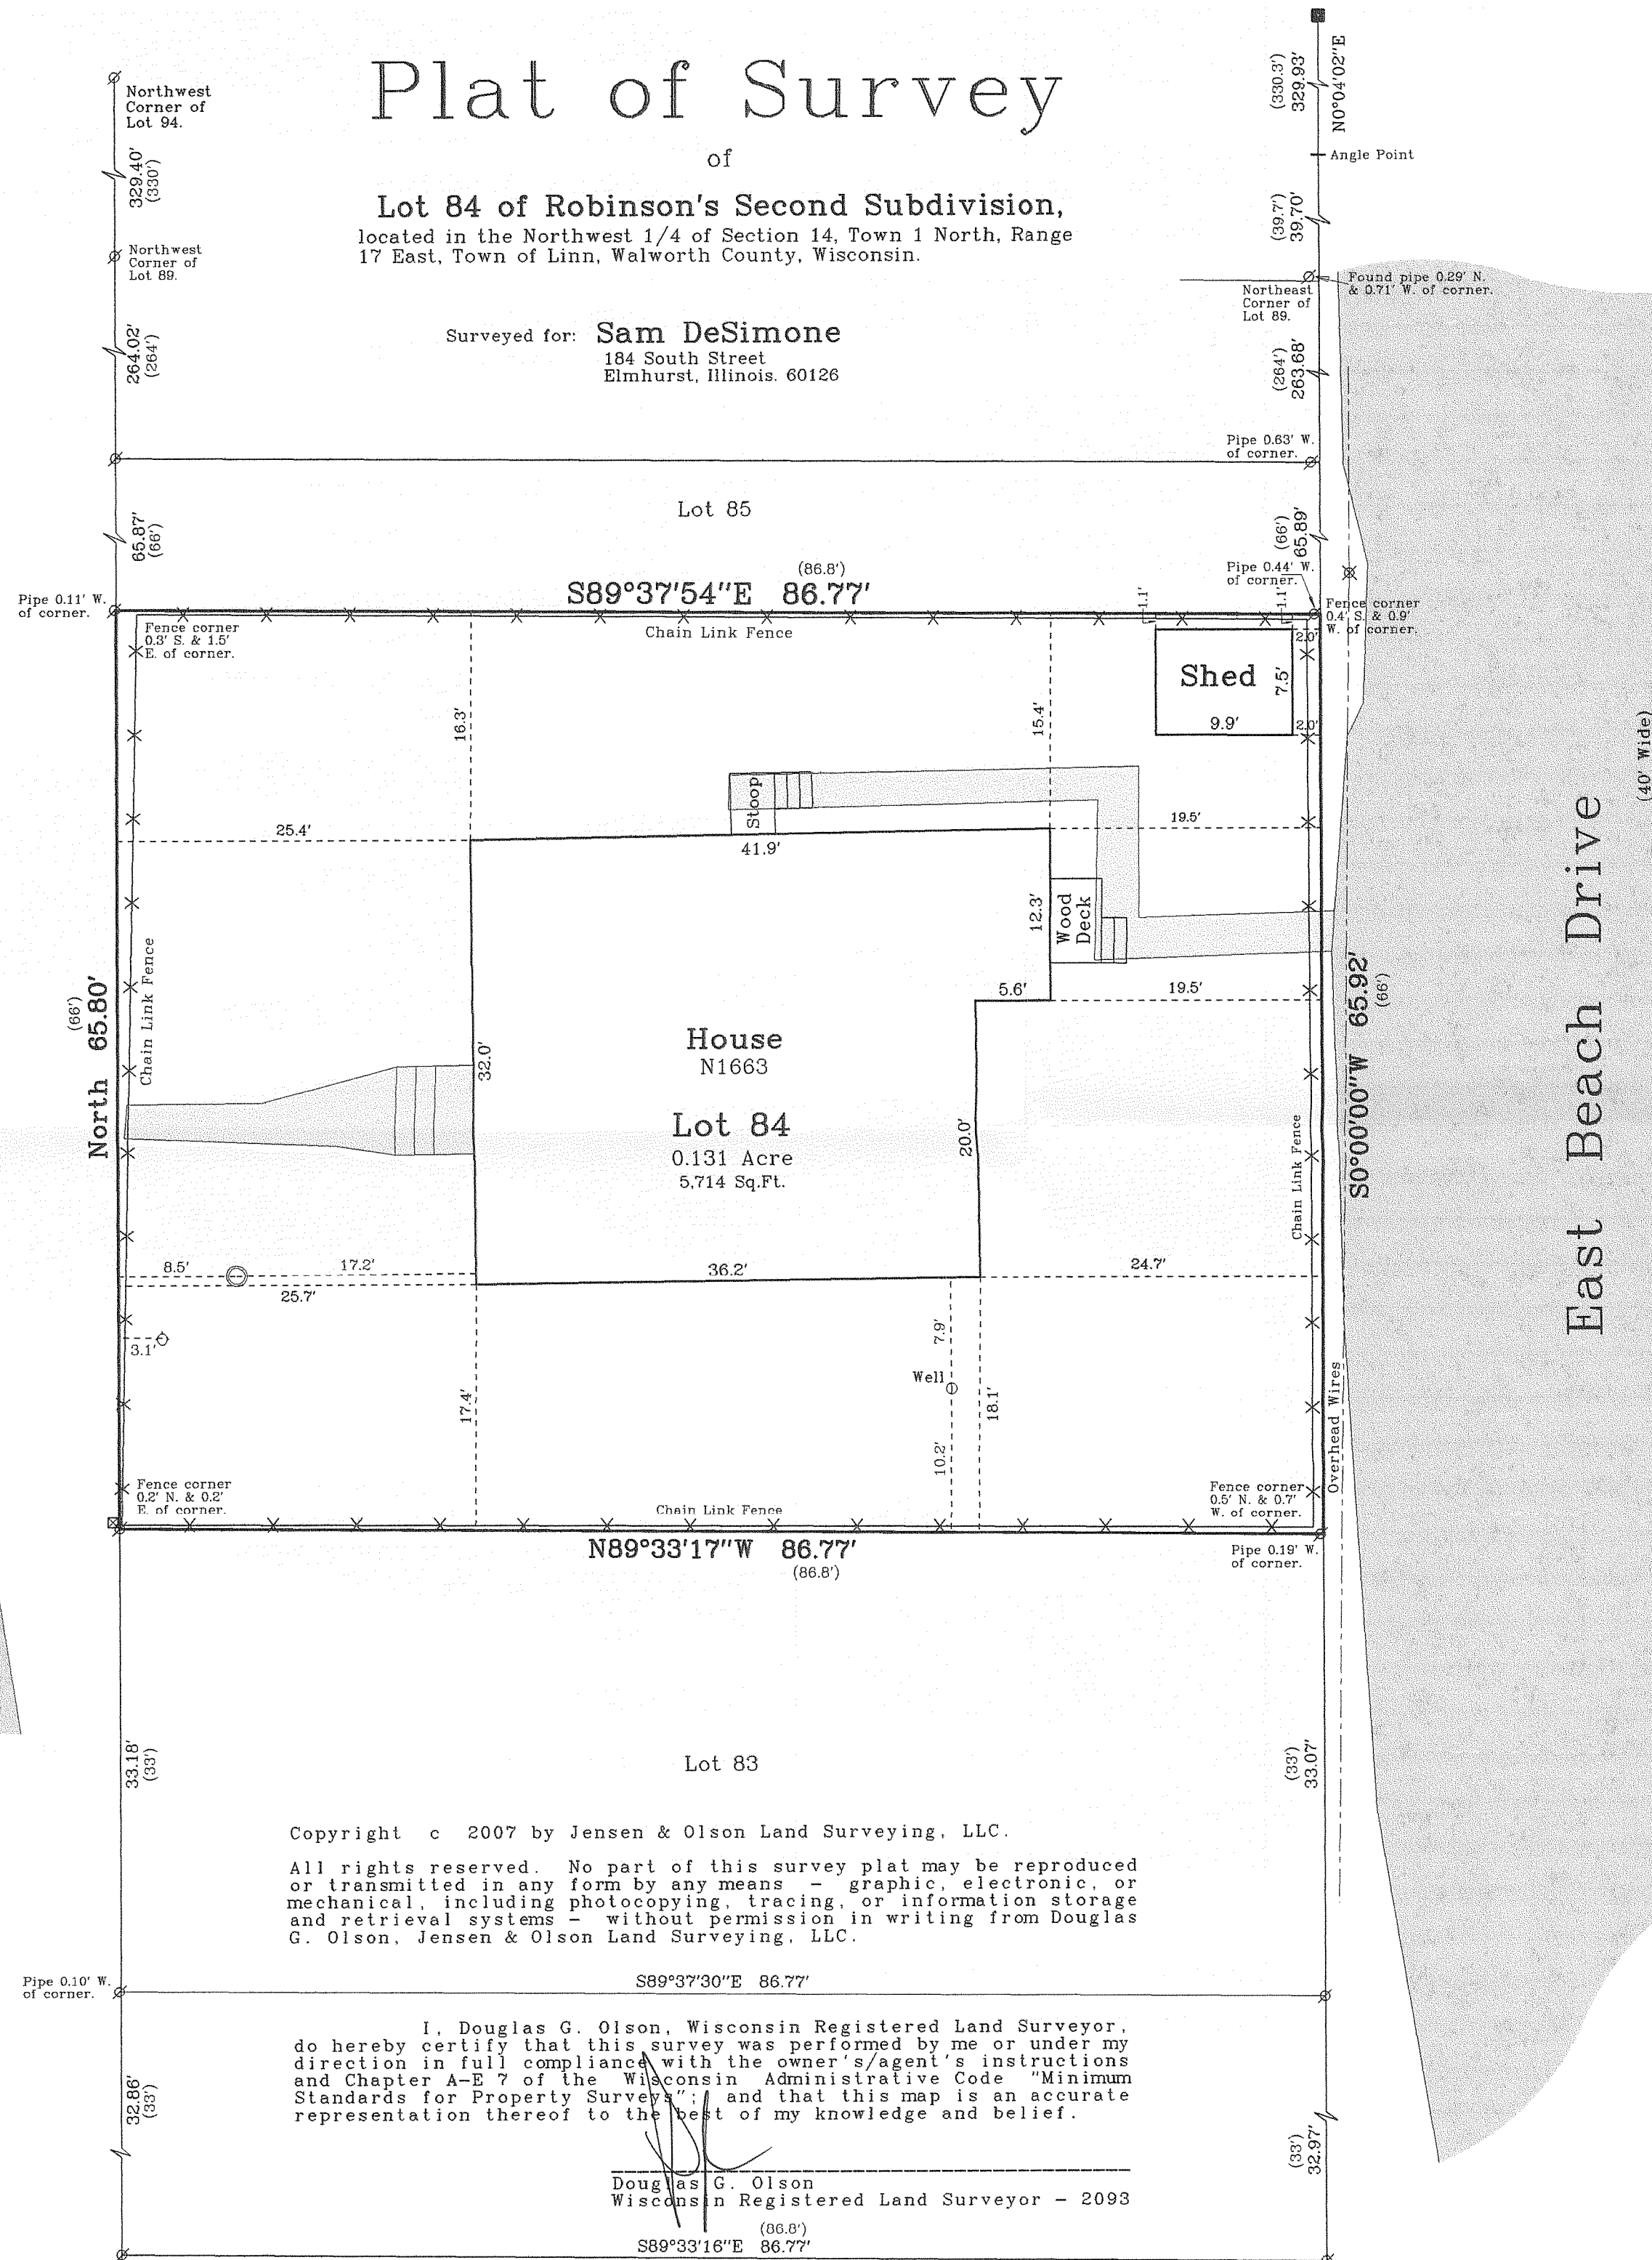


Copyright c 2007 by Jensen & Olson Land Surveying, LLC.

All rights reserved. No part of this survey plat may be reproduced or transmitted in any form by any means - graphic, electronic, or mechanical, including photocopying, tracing, or information storage and retrieval systems - without permission in writing from Douglas G. Olson, Jensen & Olson Land Surveying, LLC.

I, Douglas G. Olson, Wisconsin Registered Land Surveyor, do hereby certify that this survey was performed by me or under my direction in full compliance with the owner's/agent's instructions and Chapter A-E 7 of the Wisconsin Administrative Code "Minimum Standards for Property Surveys"; and that this map is an accurate representation thereof to the best of my knowledge and belief.

Douglas G. Olson
Wisconsin Registered Land Surveyor - 2093

S89°33'16"E 86.77'

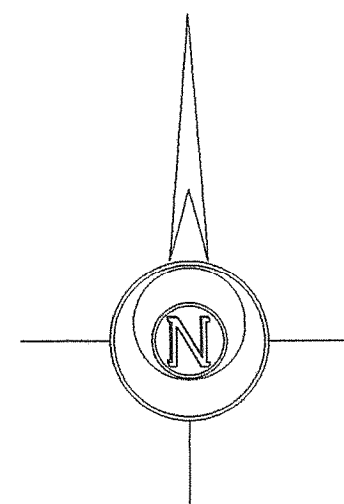

Bearings are assumed.

Survey Date: May 25, 2007.
Revisions: No. 1 - More pipe

Scale in Feet
1" = 10'

Jensen & Olson Land Surveying, LLC

445 South Wisconsin Street P.O. Box 322

Wisconsin Street

Elkhorn, Wisconsin. 53121
Telephone (262) 723-3434

Telephone (262) 723-3434

Legend

Legend

- Found Stone Monument
- Found Iron Pipe
- Recorded Information
- Utility Pedestal
- Utility Pole
- Concrete Cover
- Septic Vent
- Concrete Surface

Sheet 1 of 1 Sheets

Job Reference Number
00000000

2007.066

Notes:

- 1) This survey plat is not certified unless signed and sealed in red ink.
- 2) This survey is subject to Wisconsin lien laws. This Plat of Survey is the notice of intent to file lien. Lien waiver required.

IRB2-68

117-2902