
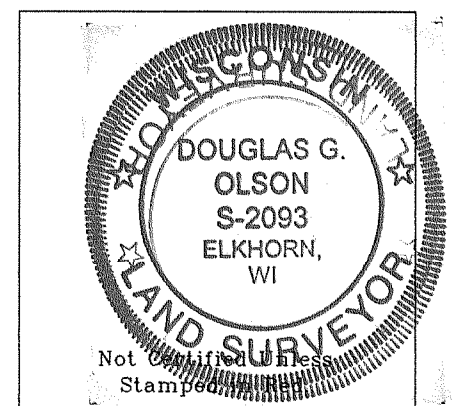


Plat of Survey


of
Lot 84 of Robinson's Second Subdivision,
located in the Northwest 1/4 of Section 14, Town 1 North, Range
17 East, Town of Linn, Walworth County, Wisconsin.

Surveyed for: **Sam DeSimone**
184 South Street
Elmhurst, Illinois. 60126

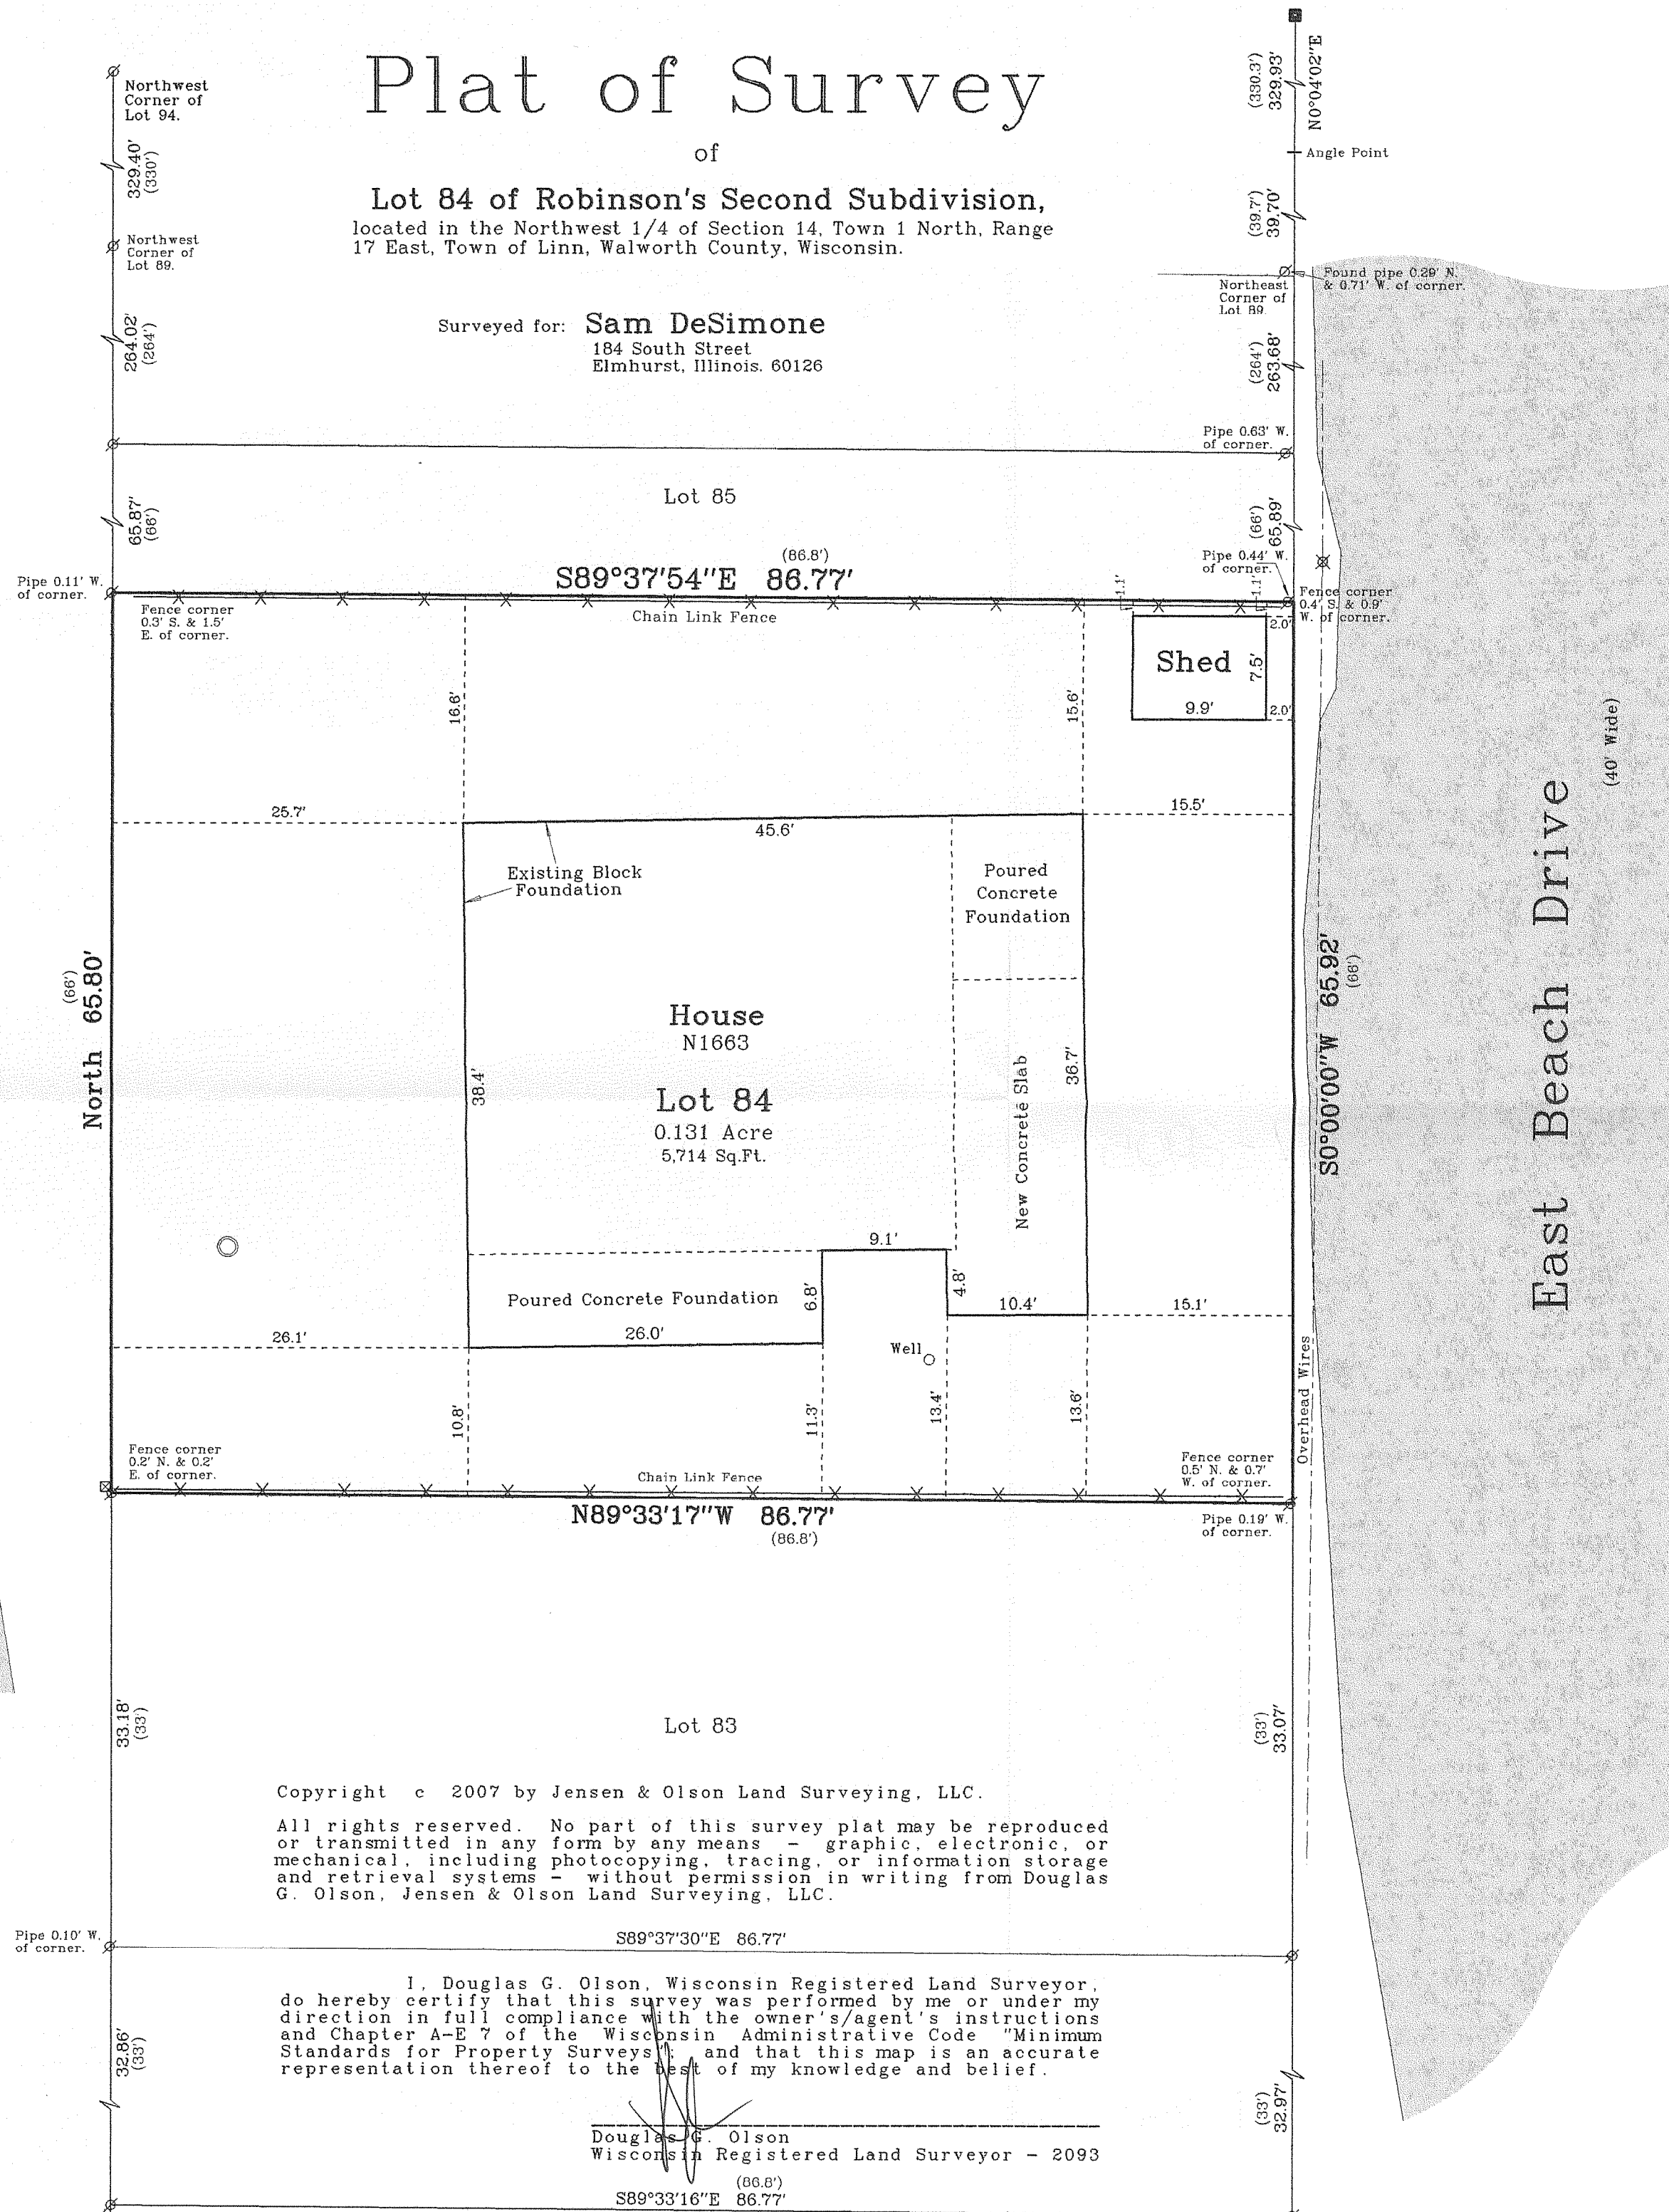

- Notes:
- 1) This survey plat is not certified unless signed and sealed in red ink.
 - 2) This survey is subject to Wisconsin lien laws. This Plat of Survey is the notice of intent to file lien. Lien waiver required.


Survey Date: May 25, 2007.
Revisions: No. 1 - More pipe
No. 2 - Proposed
No. 3 - Foundation

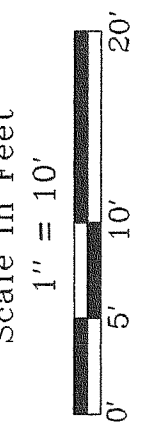

Jensen & Olson Land Surveying, LLC
45 South Wisconsin Street P.O. Box 322
Elkhorn, Wisconsin. 53121
Telephone (262) 723-3434
Facsimile (262) 723-8044

- Legend
- Found Stone Monument
 - Found Iron Pipe
 - Found Information
 - Utility Pole
 - Concrete Surface
 - Asphalt Surface

Sheet 1 of 1 Sheets
Job Reference Number 2007.066
2007.066

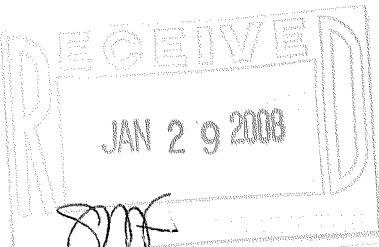

IRB2-68

117-2905 11-8000