

DEGEN - FOAT SURVEYING, INC.


071202  
071202S2.DWG

100 SOUTH SECOND STREET  
WATERFORD, WISCONSIN 53185  
(262)534-5404 (FAX)534-2022

PLAT OF SURVEY


LOTS 30, 31 AND 32, BLOCK 3, WOODDALE ADDITION, LOCATED IN SECTIONS 9 AND 16,  
TOWN 1 NORTH, RANGE 17 EAST, TOWN OF LINN, WALWORTH COUNTY, WISCONSIN.

\* REFER TO A CURRENT TITLE REPORT FOR EASEMENTS, RESTRICTIONS OR COVENANTS OF RECORD THAT MAY AFFECT THIS LAND. \*

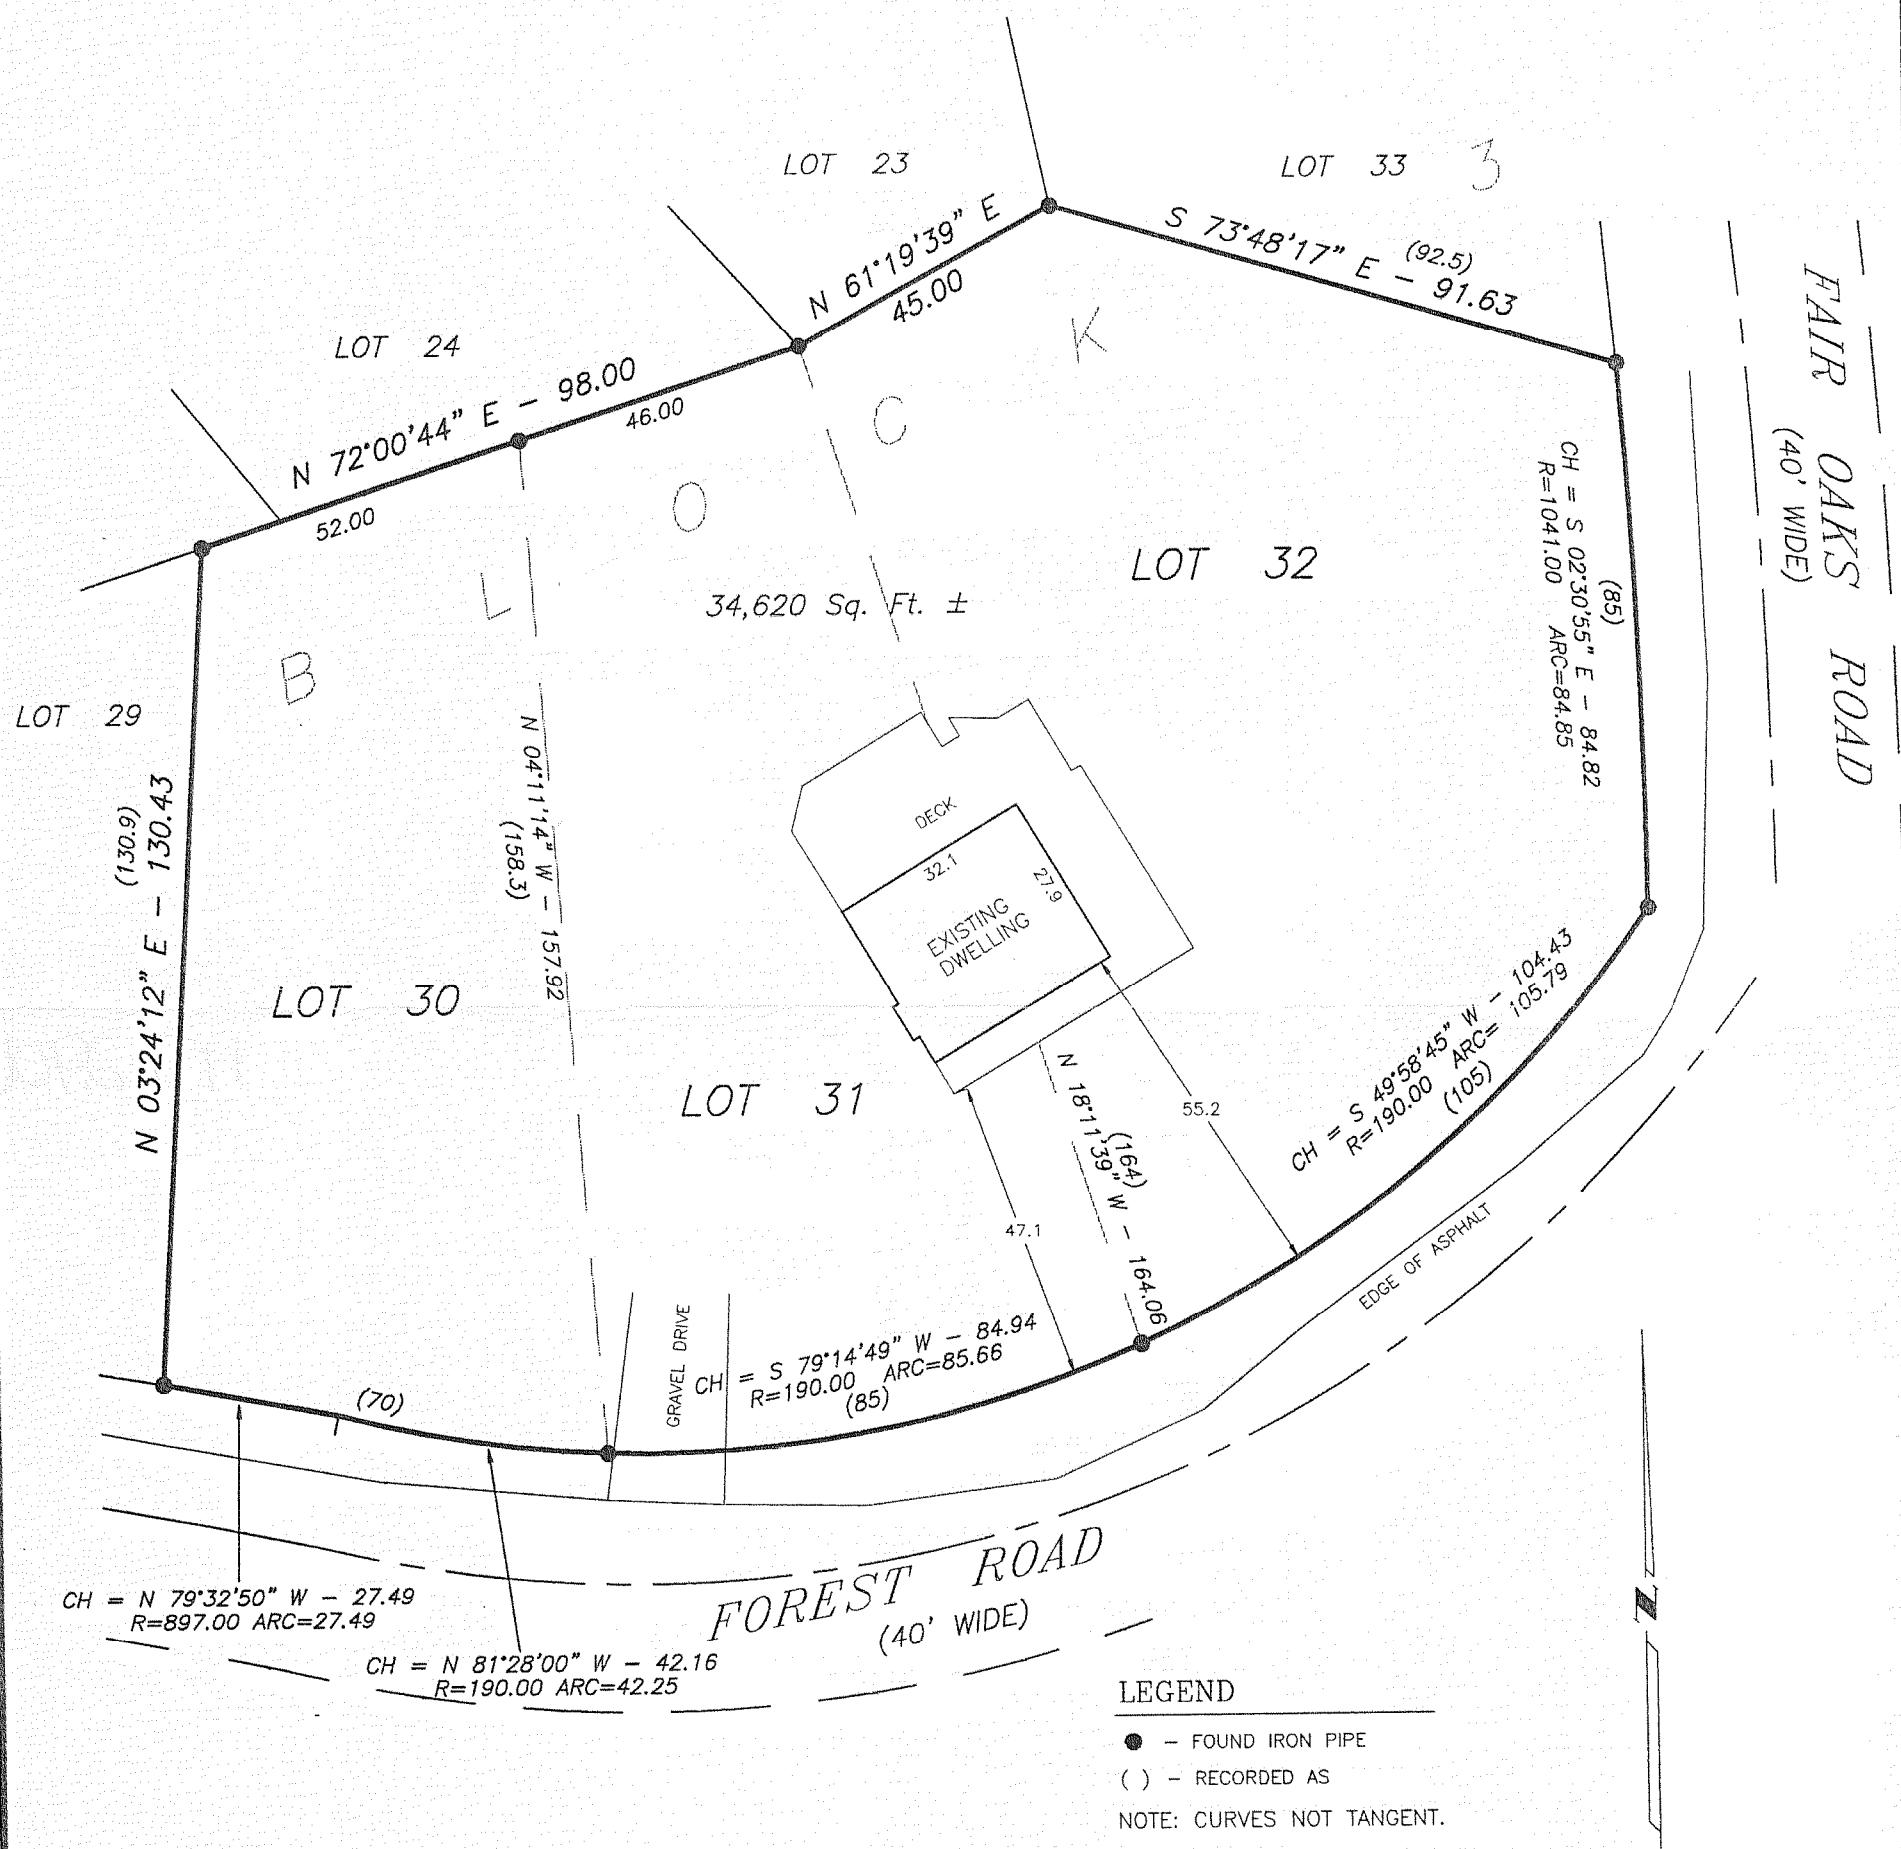

SURVEY ORDERED BY: JACK BAKER  
COLDWELL BANKER - PRIMUS  
226 BROAD STREET  
LAKE GENEVA, WI 53147

SCALE: 1" = 30'  
BEARINGS BASED ON THE EAST LINE OF  
BLOCK 3, WOODDALE ADDITION, WHICH  
IS USED AS NORTH ON PREVIOUS SURVEYS.

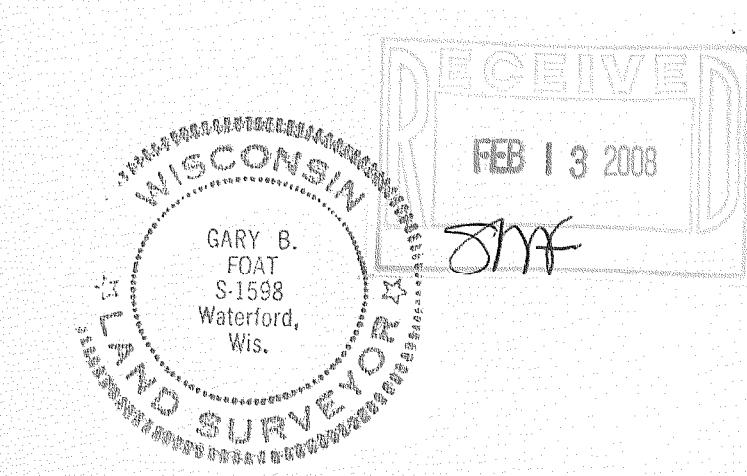

IW 41 IW 42

117-290de