

PREPARED FOR  
BEAA SHEEHAN  
KEEFE REALESTATE  
751 GENEVA PARKWAY  
LAKE GENEVA WI. 53147


PLAT OF SURVEY

-OF-

LOT 21, BLOCK 4 LAKE GENEVA TERRACE,  
A SUBDIVISION LOCATED IN SECTION 15, TOWN 1 NORTH,  
RANGE 17 EAST, WALWORTH COUNTY, WISCONSIN.

KROTT SURVEYING INC.

N3705 WILLOW BEND LANE  
LAKE GENEVA WI. 53147  
PHONE # (262)248-3697  
FAX # (262)249-0639

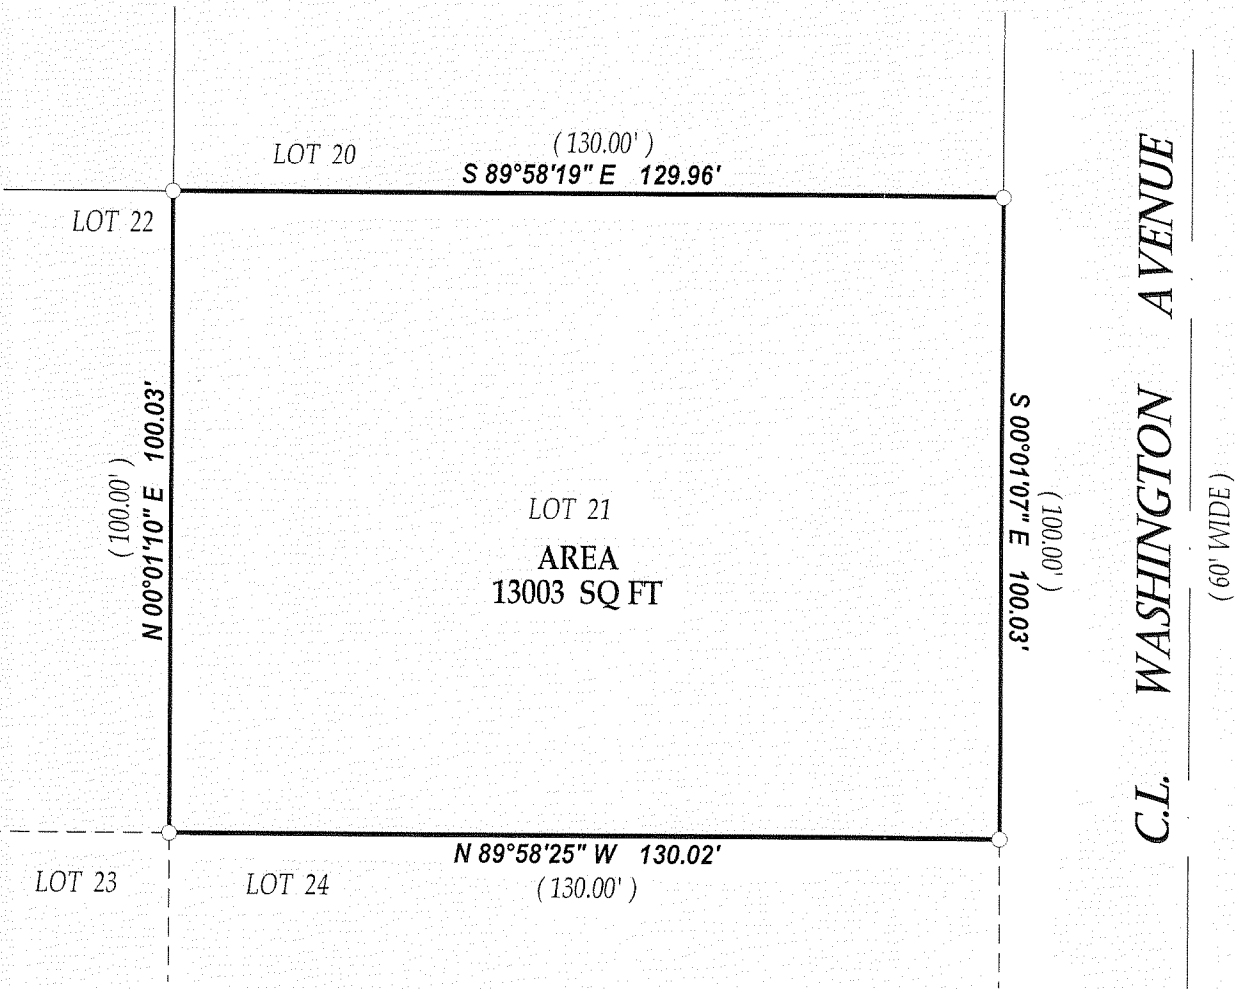


LEGEND

- FOUND IRON PIPE
- ∅ POWER POLE
- OVERHEAD WIRES
- (XX) RECORDED AS


COMPARE LEGAL DESCRIPTION ABOVE AND DRAWING WITH DEED.  
FOR BUILDING RESTRICTIONS AND EASEMENTS NOT SHOWN, REFER  
TO DEED, ABSTRACT SOURCES AND LOCAL MUNICIPAL CODES. NOTIFY  
THE SURVEYOR IMMEDIATELY OF ANY DISCREPANCY.

"I hereby certify that I have surveyed the above described property and that  
the above map is a true representation thereof and shows the size and  
location of all visible structures, apparent easements and encroachments  
if any."

This survey is made for the present owners of the property, and those who  
purchase, mortgage, or guarantee the title thereto, within one year from  
the date hereof.

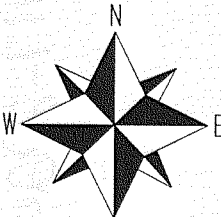

SCALE 1"=30'

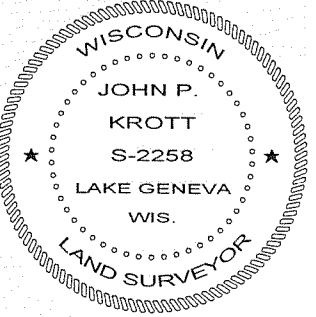

*John P. Krott*

JOHN KROTT S - 2258  
Wisconsin Registered Land Surveyor  
(original if signed in red)

JOB # 08-061 TAX ID # ILGT00018B  
DATED THIS THE 31st DAY OF MARCH 2008.

ILGT-18B

117-2924