


ABELL
SURVEYING & MAPPING

1140 SEQUOIA STREET • DELAVAN, WISCONSIN 53115
414-728-6737

VIEWCREST DRIVE

60 FEET WIDE

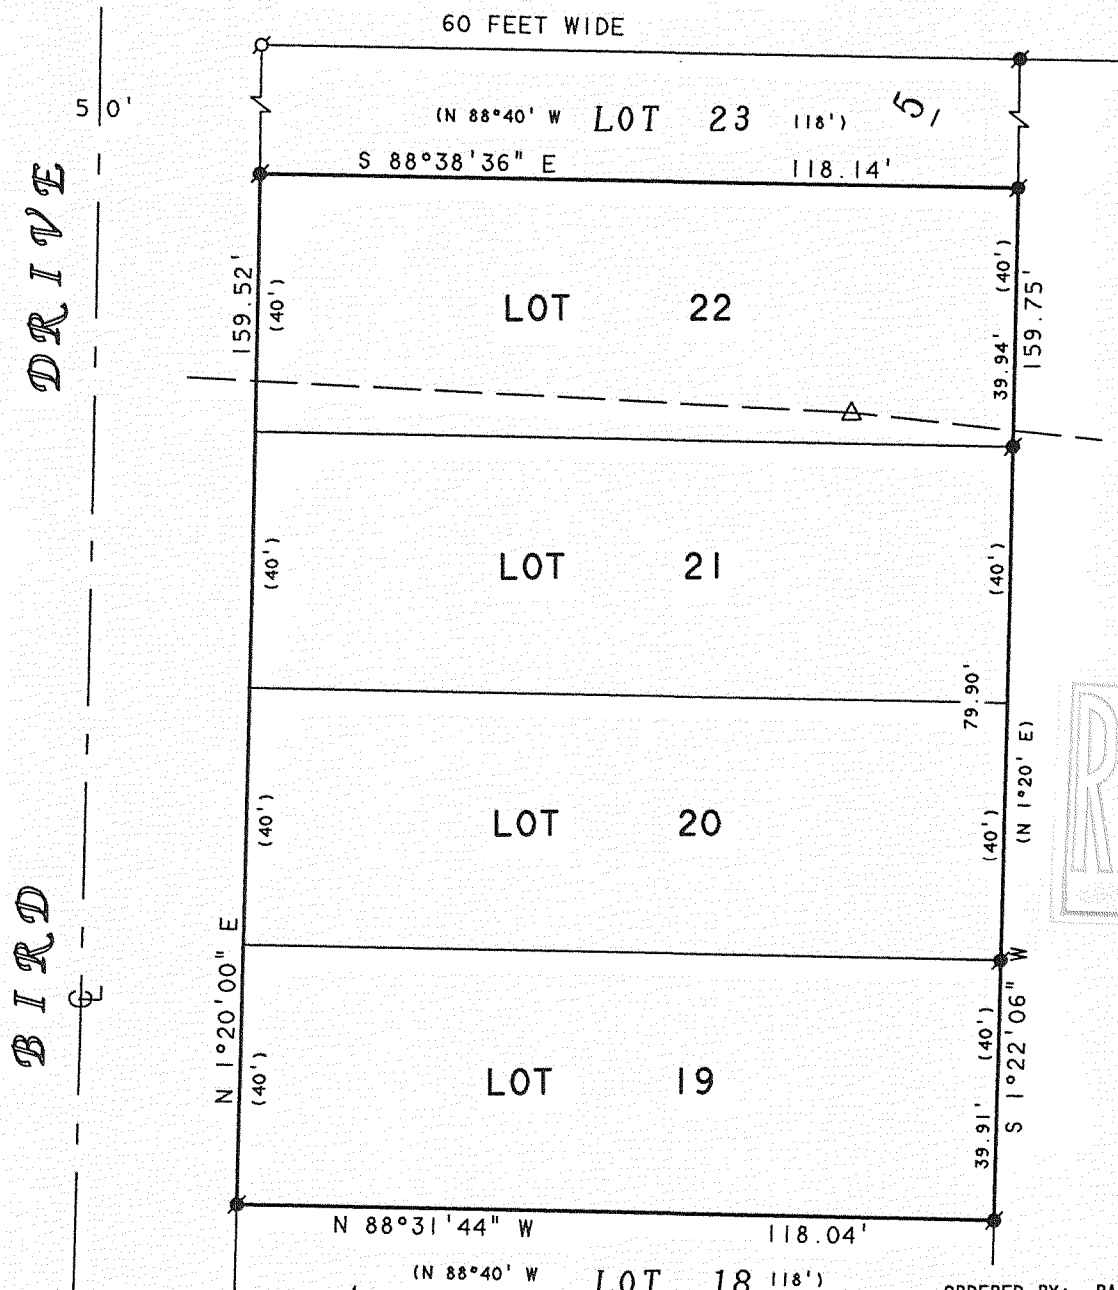

RECEIVED
APR 29 2008
SMF

BLOCK

LOT 18

ORDERED BY: PAULINE WILLARD
641 QUINCY BRIDGE LANE
GLENVIEW, IL 60025

PLAT OF SURVEY OF

LOTS 19-22, BLOCK 5, MAPLE HILLS
"A" SUBDIVISION, LOCATED IN T1N.
R17E, WALWORTH COUNTY, WISCONSIN.

NOTE: BEARINGS ARE REFERENCED TO THE
RECORDED SUBDIVISION PLAT.

JANUARY 25, 2008 - THE CORNERS OF LOTS 19-22, BLOCK 5 WERE REMARKED
WITH WOOD LATH AND FLAGS. NO OTHER IMPROVEMENTS WERE LOCATED AS
REQUESTED BY JOHN WENDT.

ORDERED BY: JOHN WENDT
N1703 WOODDALE ROAD
LAKE GENEVA, WI 53147



SCALE 1"=30'

LEGEND

- -IRON PIPE FOUND
- -IRON ROD FOUND
- △ -UTILITY POLE
- -OVERHEAD UTILITY LINES
- () -RECORDED AS

I HEREBY CERTIFY THAT I HAVE SURVEYED THE ABOVE DESCRIBED PROPERTY AND THAT THE
ABOVE MAP IS A TRUE REPRESENTATION THEREOF AND SHOWS THE SIZE AND LOCATION OF
THE PROPERTY, ITS EXTERIOR BOUNDARIES, THE LOCATION OF ALL VISIBLE STRUCTURES
AND DIMENSIONS OF ALL PRINCIPAL BUILDINGS THEREON, BOUNDARY FENCES, APPARENT
EASEMENTS, ROADWAYS AND VISIBLE ENCROACHMENTS, IF ANY, TO THE BEST OF MY
KNOWLEDGE AND BELIEF.

THIS SURVEY IS MADE FOR THE USE OF THE PRESENT OWNERS OF THE PROPERTY, AND ALSO
THOSE WHO PURCHASE, MORTGAGE, OR GUARANTEE THE TITLE THERETO WITHIN ONE (1) YEAR
FROM DATE HEREON.

David F. Abell

DAVID F. ABELL
WISCONSIN REGISTERED LAND SURVEYOR, S-1596

June 12, 1997

DATE: THIS IS NOT A CERTIFIED COPY UNLESS SEALED. JOB NUMBER - 97110C

EMH-114

117-2937