




PLAT OF SURVEY
LOT 1 OF CERTIFIED SURVEY MAP NO. 1803
LOCATED IN THE NE 1/4 OF SECTION 18, TOWN 1 NORTH, RANGE 17 EAST,
WALWORTH COUNTY, WISCONSIN

NOTE: RESIDENCE ON THIS
PARCEL IS 47.4' FROM TOP
OF STREAM BANK

BENCH MARK: TOP OF IRON PIPE
ASSUMED ELEVATION=971.07'

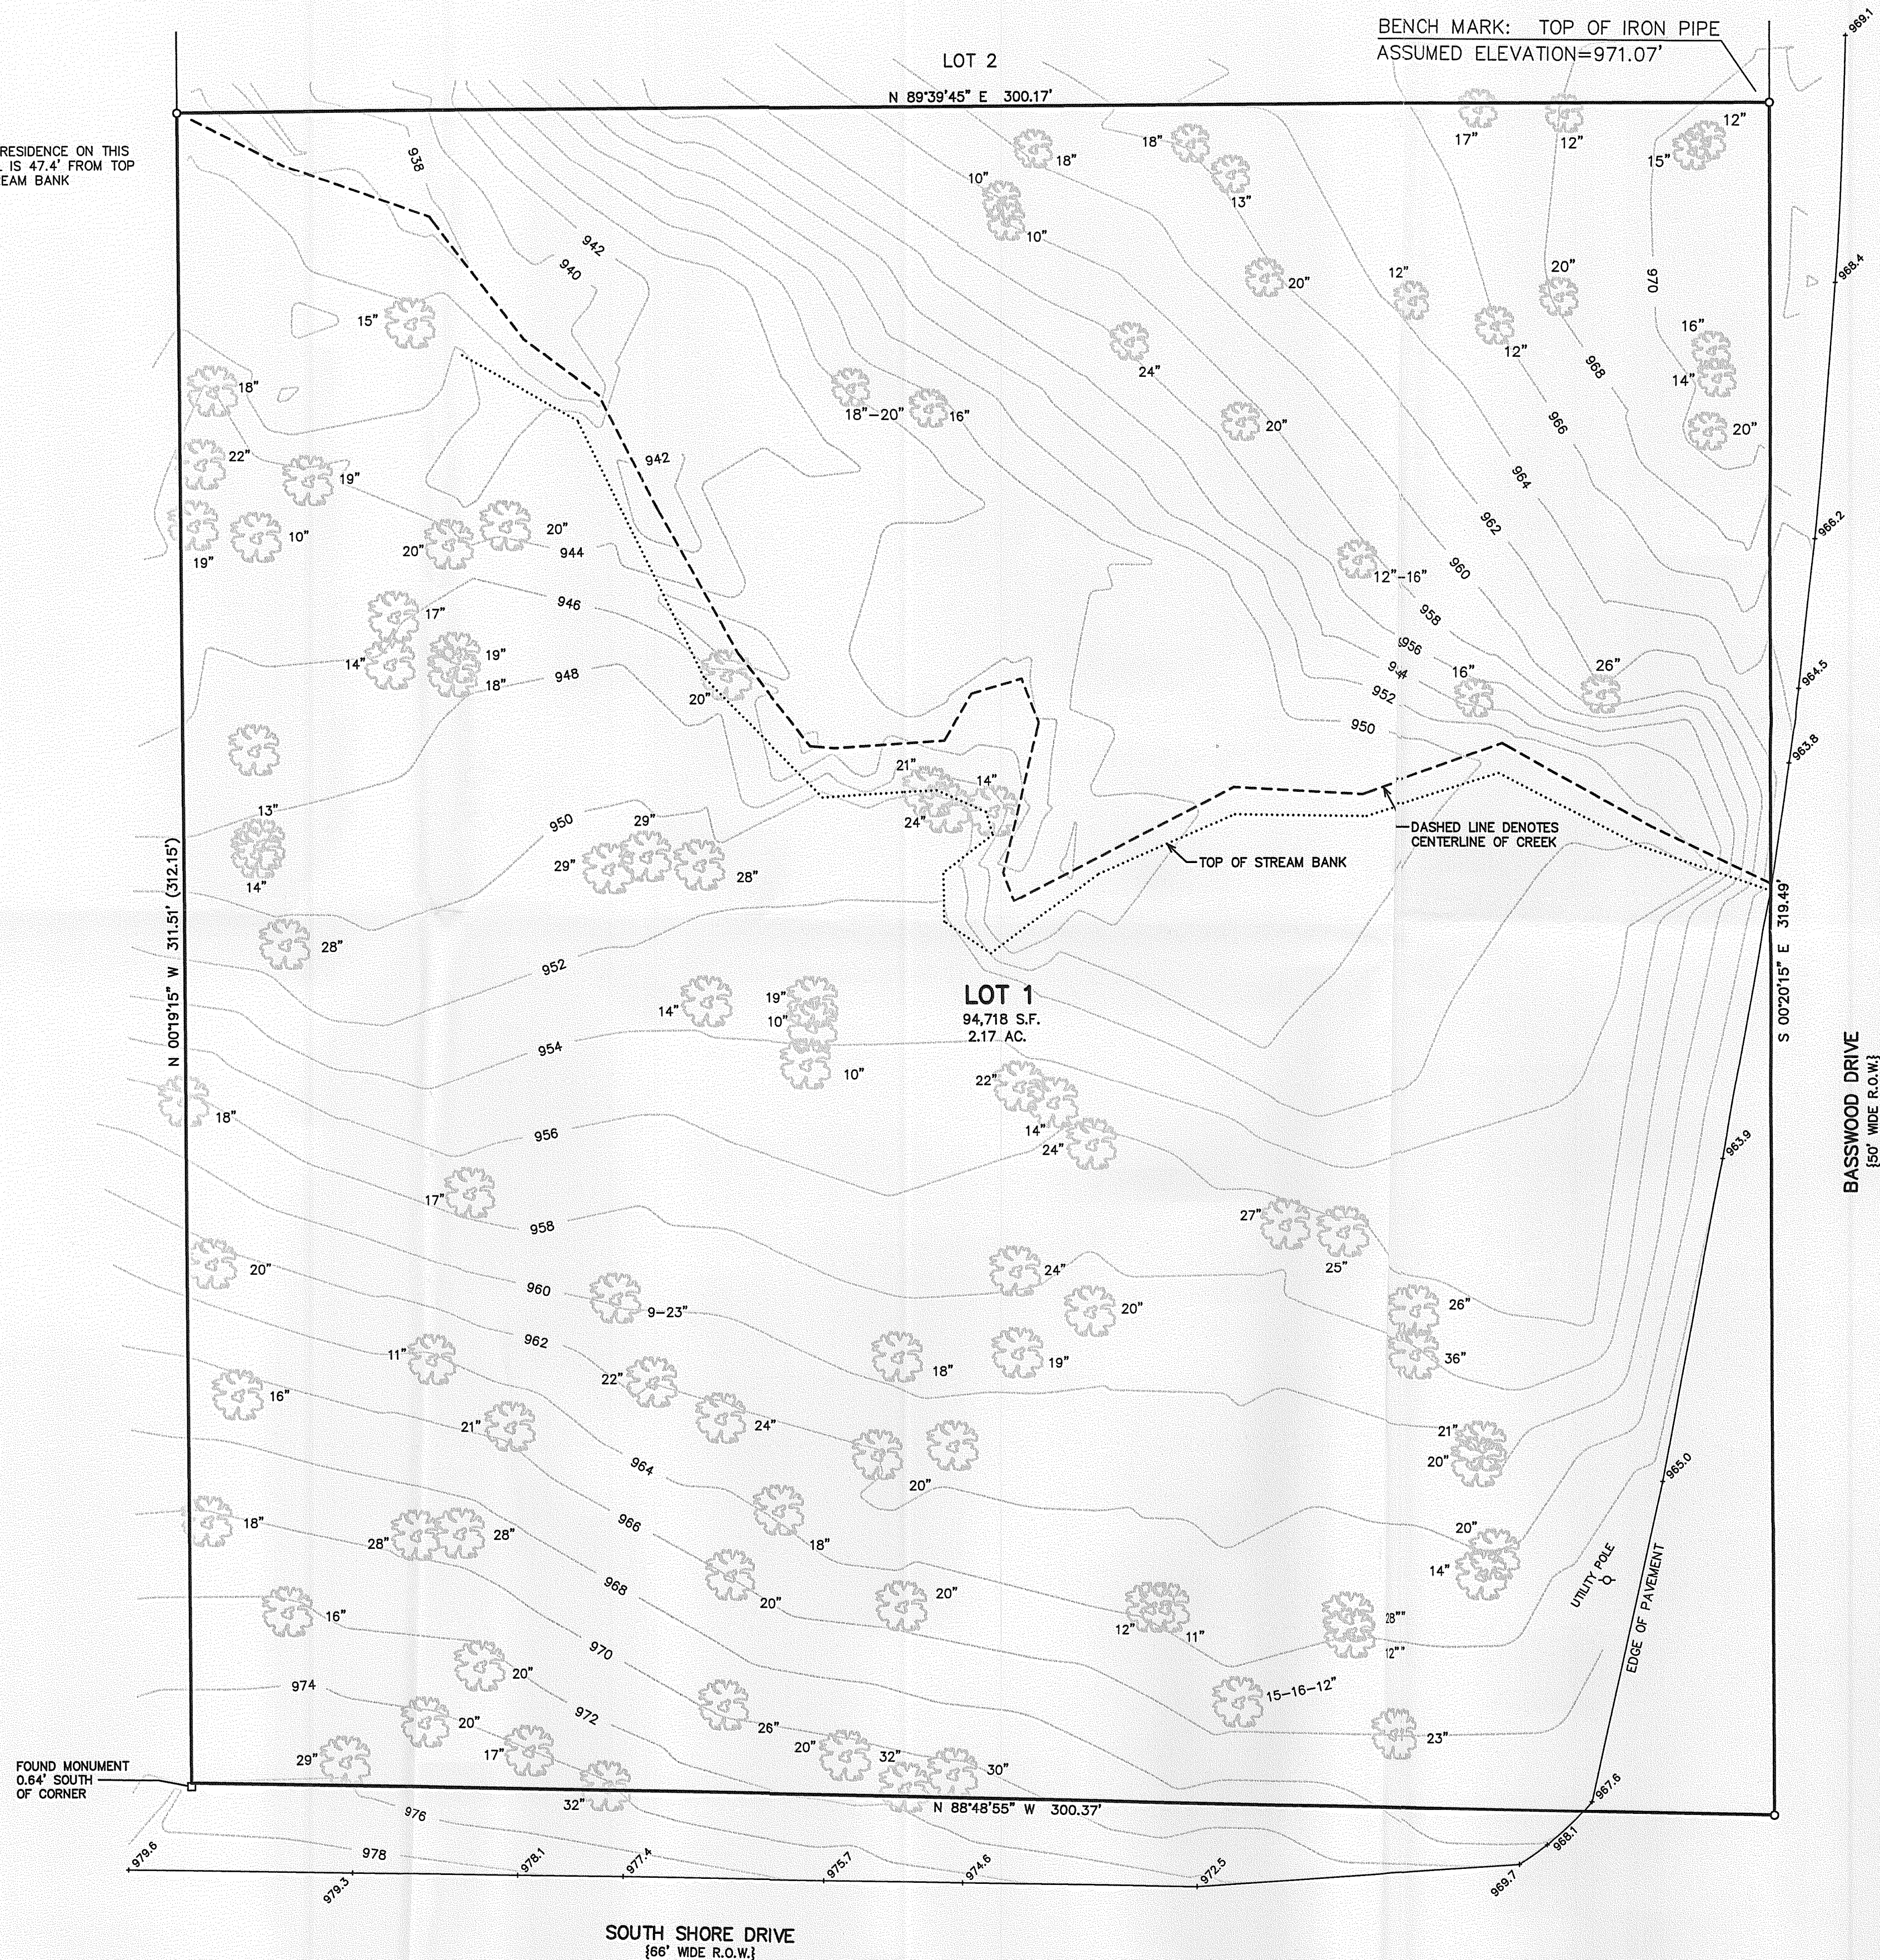

- LEGEND
- = FOUND IRON PIPE STAKE
 - = FOUND GRANITE MONUMENT
 - {XXX} = RECORDED AS

NOTE: RECORD CSM IS 0.64' OUT OF CLOSURE
WEST LINE LOT 1 RECORDED AS 312.51'
SHOULD BE 311.51'




NOTE: COPIES OF THIS MAP TO WHICH THE FOLLOWING CERTIFICATE WILL APPLY SHOW
THE SURVEYOR'S ORIGINAL SEAL AND SIGNATURE IN RED INK. COPIES BY ANY OTHER
MEANS MAY HAVE ALTERATIONS WHICH DO NOT REPRESENT THE SURVEYOR'S WORK
PRODUCT.

I HEREBY CERTIFY THAT THE ABOVE DESCRIBED PROPERTY HAS BEEN SURVEYED UNDER
MY DIRECTION AND THAT THE ABOVE MAP IS A TRUE REPRESENTATION THEREOF AND
SHOWS THE SIZE AND LOCATION OF THE PROPERTY, ITS EXTERIOR BOUNDARIES, THE
LOCATION OF ALL VISIBLE STRUCTURES, AND DIMENSIONS OF ALL PRINCIPLE
BUILDINGS THEREON, BOUNDARY FENCES, APPARENT EASEMENTS, ROADWAYS, AND
VISIBLE ENCROACHMENTS, IF ANY. THIS SURVEY IS MADE FOR THE USE OF THE
PRESENT OWNERS OF THE PROPERTY, AND ALSO THOSE WHO PURCHASE, MORTGAGE, OR
GUARANTEE THE TITLE THERETO WITHIN ONE YEAR FROM THE DATE HEREOF.

DATED: 5/8/2008

Peter S. Gordon
PETER S. GORDON

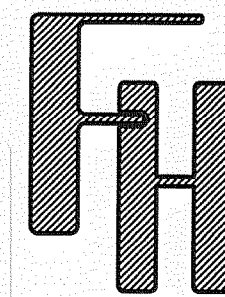


WORK ORDERED BY:
DAVID UMBGAUGH
1830 LOMA STREET
SARASOTA, FL 34239

FARRIS, HANSEN & ASSOCIATES, INC.
ENGINEERING - ARCHITECTURE - SURVEYING
7 RIDGWAY COURT P.O. BOX 437
ELKHORN, WISCONSIN 53121
OFFICE: (262) 723-2098 FAX: (262) 723-5886

REVISIONS

PROJECT NO.
7513
DATE
05/08/2008
SHEET NO.
1 OF 1

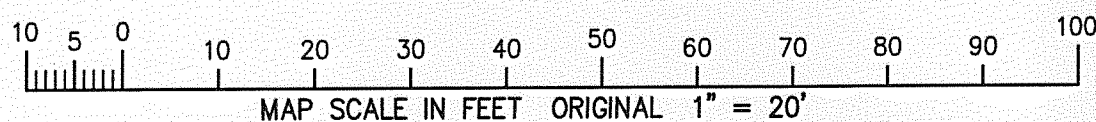

IA1803 -1

117-2140