


# HAROLD H. KOLB

REGISTERED PROFESSIONAL LAND SURVEYOR  
LAKE GENEVA, WISCONSIN  
16' PRIVATE ROAD

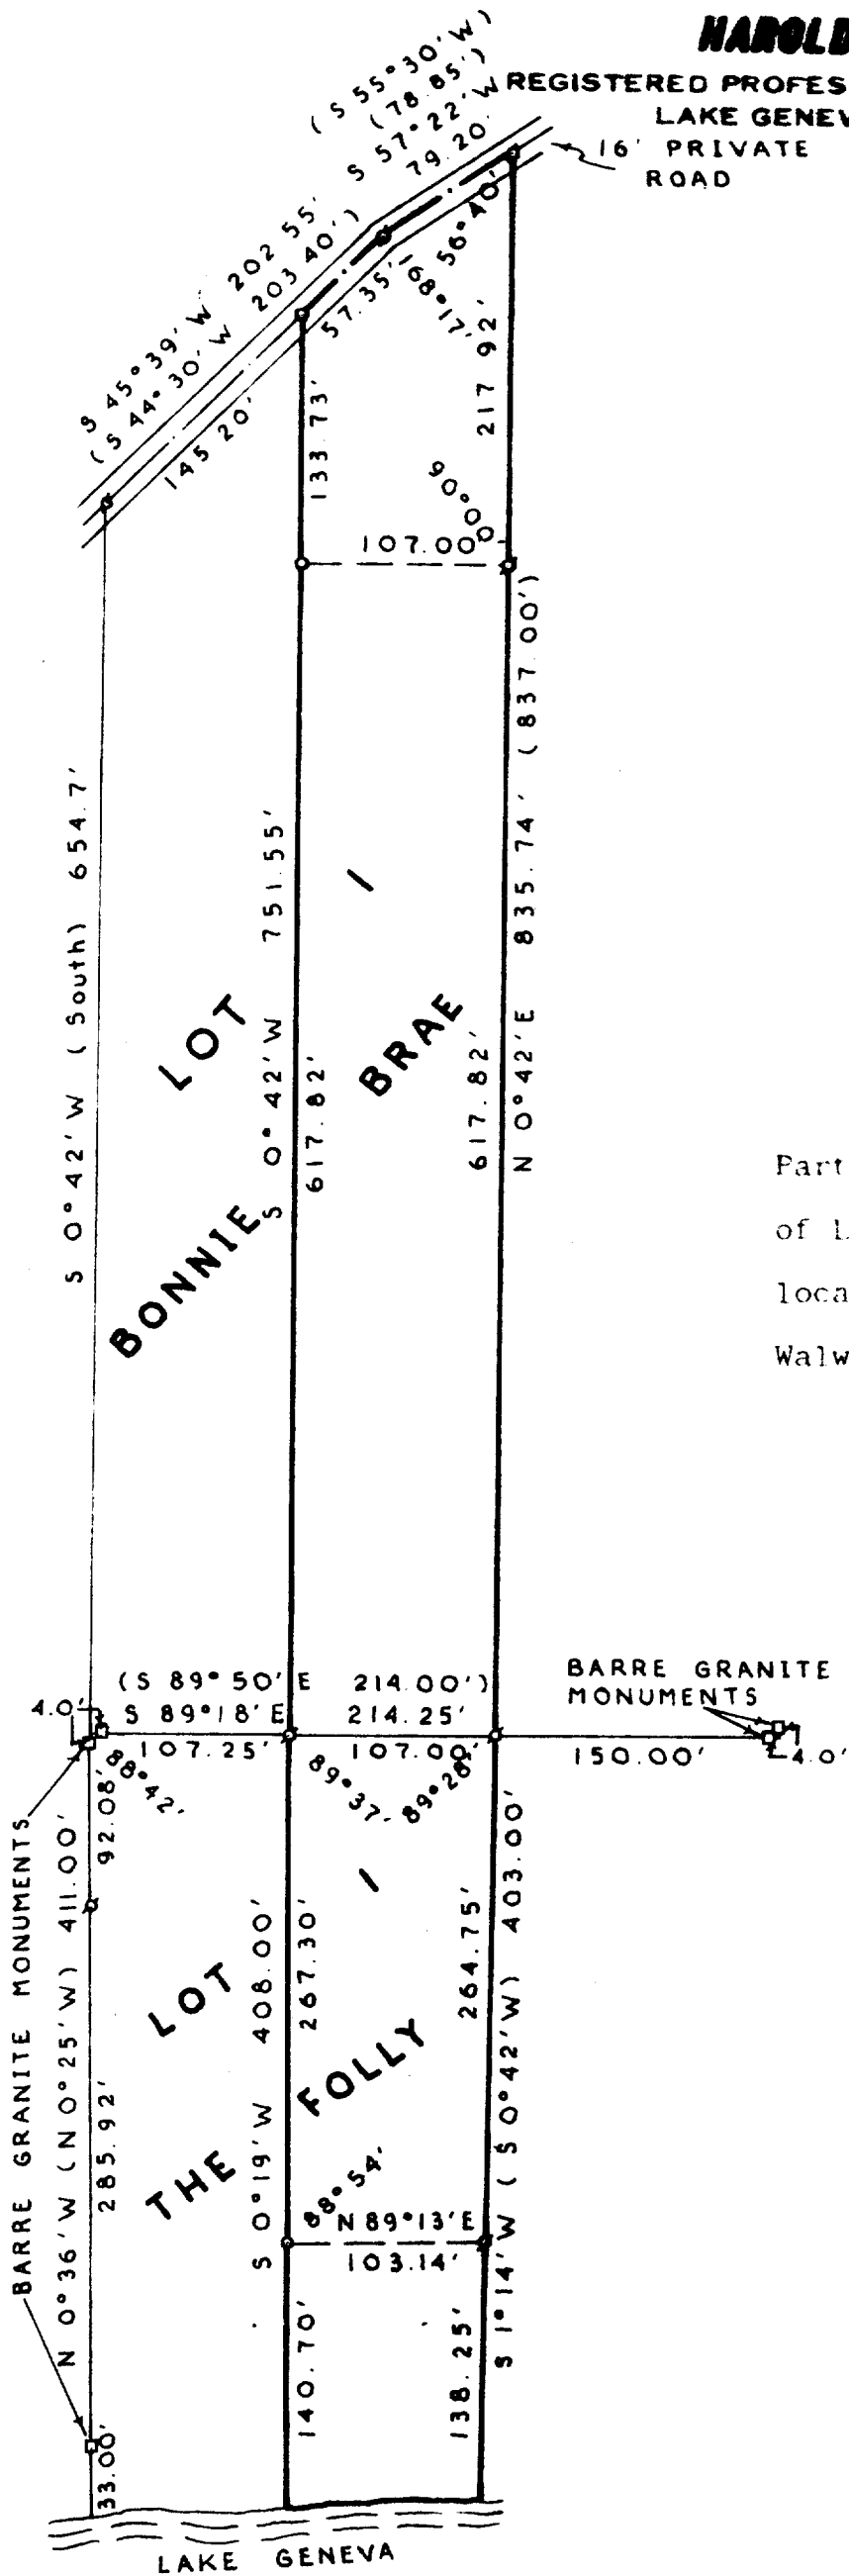

## PLAT OF SURVEY OF

Part of Lot 1, Bonnie Brae, and part  
of Lot 1, "The Folly," subdivisions  
located in Section 3, T 1 N, R 17 E,  
Walworth County, Wisconsin.



I, HAROLD H. KOLB, DO HEREBY CERTIFY THAT I HAVE  
SURVEYED THE PROPERTY HEREON DESCRIBED ACCORDING  
TO THE OFFICIAL RECORDS, AND THAT THE PLAT HEREON  
IS A CORRECT REPRESENTATION OF THE LOT LINES.

*Harold H. Kolb*  
HAROLD H. KOLB

WISCONSIN REGISTERED LAND SURVEYOR, S-187  
DATE October 7, 1971

BB-5  
F-1A

117-295