
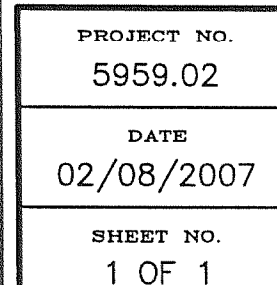
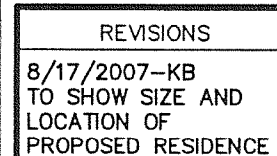


WORK ORDERED BY -
FISCHER FINE HOMES
PO BOX 500
FONTANA, WI. 53125

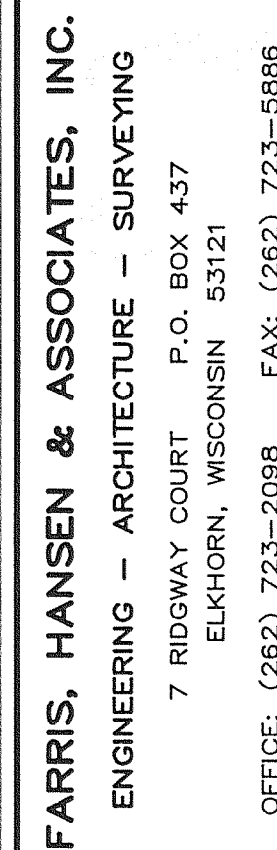

NOTE: COPIES OF THIS MAP TO WHICH THE FOLLOWING CERTIFICATE WILL APPLY SHOW THE SURVEYOR'S ORIGINAL SEAL AND SIGNATURE IN RED INK. COPIES BY ANY OTHER MEANS MAY HAVE ALTERATIONS WHICH DO NOT REPRESENT THE SURVEYOR'S WORK PRODUCT.

I HEREBY CERTIFY THAT THE ABOVE DESCRIBED PROPERTY HAS BEEN SURVEYED UNDER MY DIRECTION AND THAT THE ABOVE MAP IS A TRUE REPRESENTATION THEREOF AND SHOWS THE SIZE AND LOCATION OF THE PROPERTY, ITS EXTERIOR BOUNDARIES, THE LOCATION OF ALL VISIBLE STRUCTURES, AND THE DIMENSIONS OF ALL PERMISSIBLE BUILDINGS THEREON, BOUNDARY FENCES, APPARENT EASEMENTS, ROADWAYS, AND VISIBLE ENCROACHMENTS, IF ANY. THIS SURVEY IS MADE FOR THE USE OF THE PRESENT OWNERS OF THE PROPERTY, AND ALSO THOSE WHO PURCHASE, MORTGAGE, OR GUARANTEE THE TITLE THERETO WITHIN ONE YEAR FROM THE DATE HEREOF.

DATED: FEBRUARY 9, 2007

REVISED 07-22-2008
TO SHOW SIZE & LOCATION OF
AS BUILT RESIDENCE & DECKS

PETER S. GORDON

Peter S. Gordon
PETER S. GORDON

117-2955

MAP SCALE IN FEET ORIGINAL 1" = 40'

RECEIVED
JUL 29 2008
SMF

1/22/2008 X:\Projects\5959\PERMIT_LOT2

IA3518-2