

PREPARED FOR:
JULIE BUSH
COLDWELL BANKER PRIMUS
226 BROAD ST.
LAKE GENEVA, WI 53147


PLAT OF SURVEY

-OF-

LOTS 1, 2 AND 23, BLOCK 9 OF WOODDALE ADDITION, LOCATED IN
TOWN 1 NORTH, RANGE 17 EAST, WALWORTH COUNTY, WISCONSIN.

KROTT SURVEYING INC.

N3705 WILLOW BEND LANE
LAKE GENEVA WI. 53147
PHONE # (262)248-3697
FAX # (262)249-0639

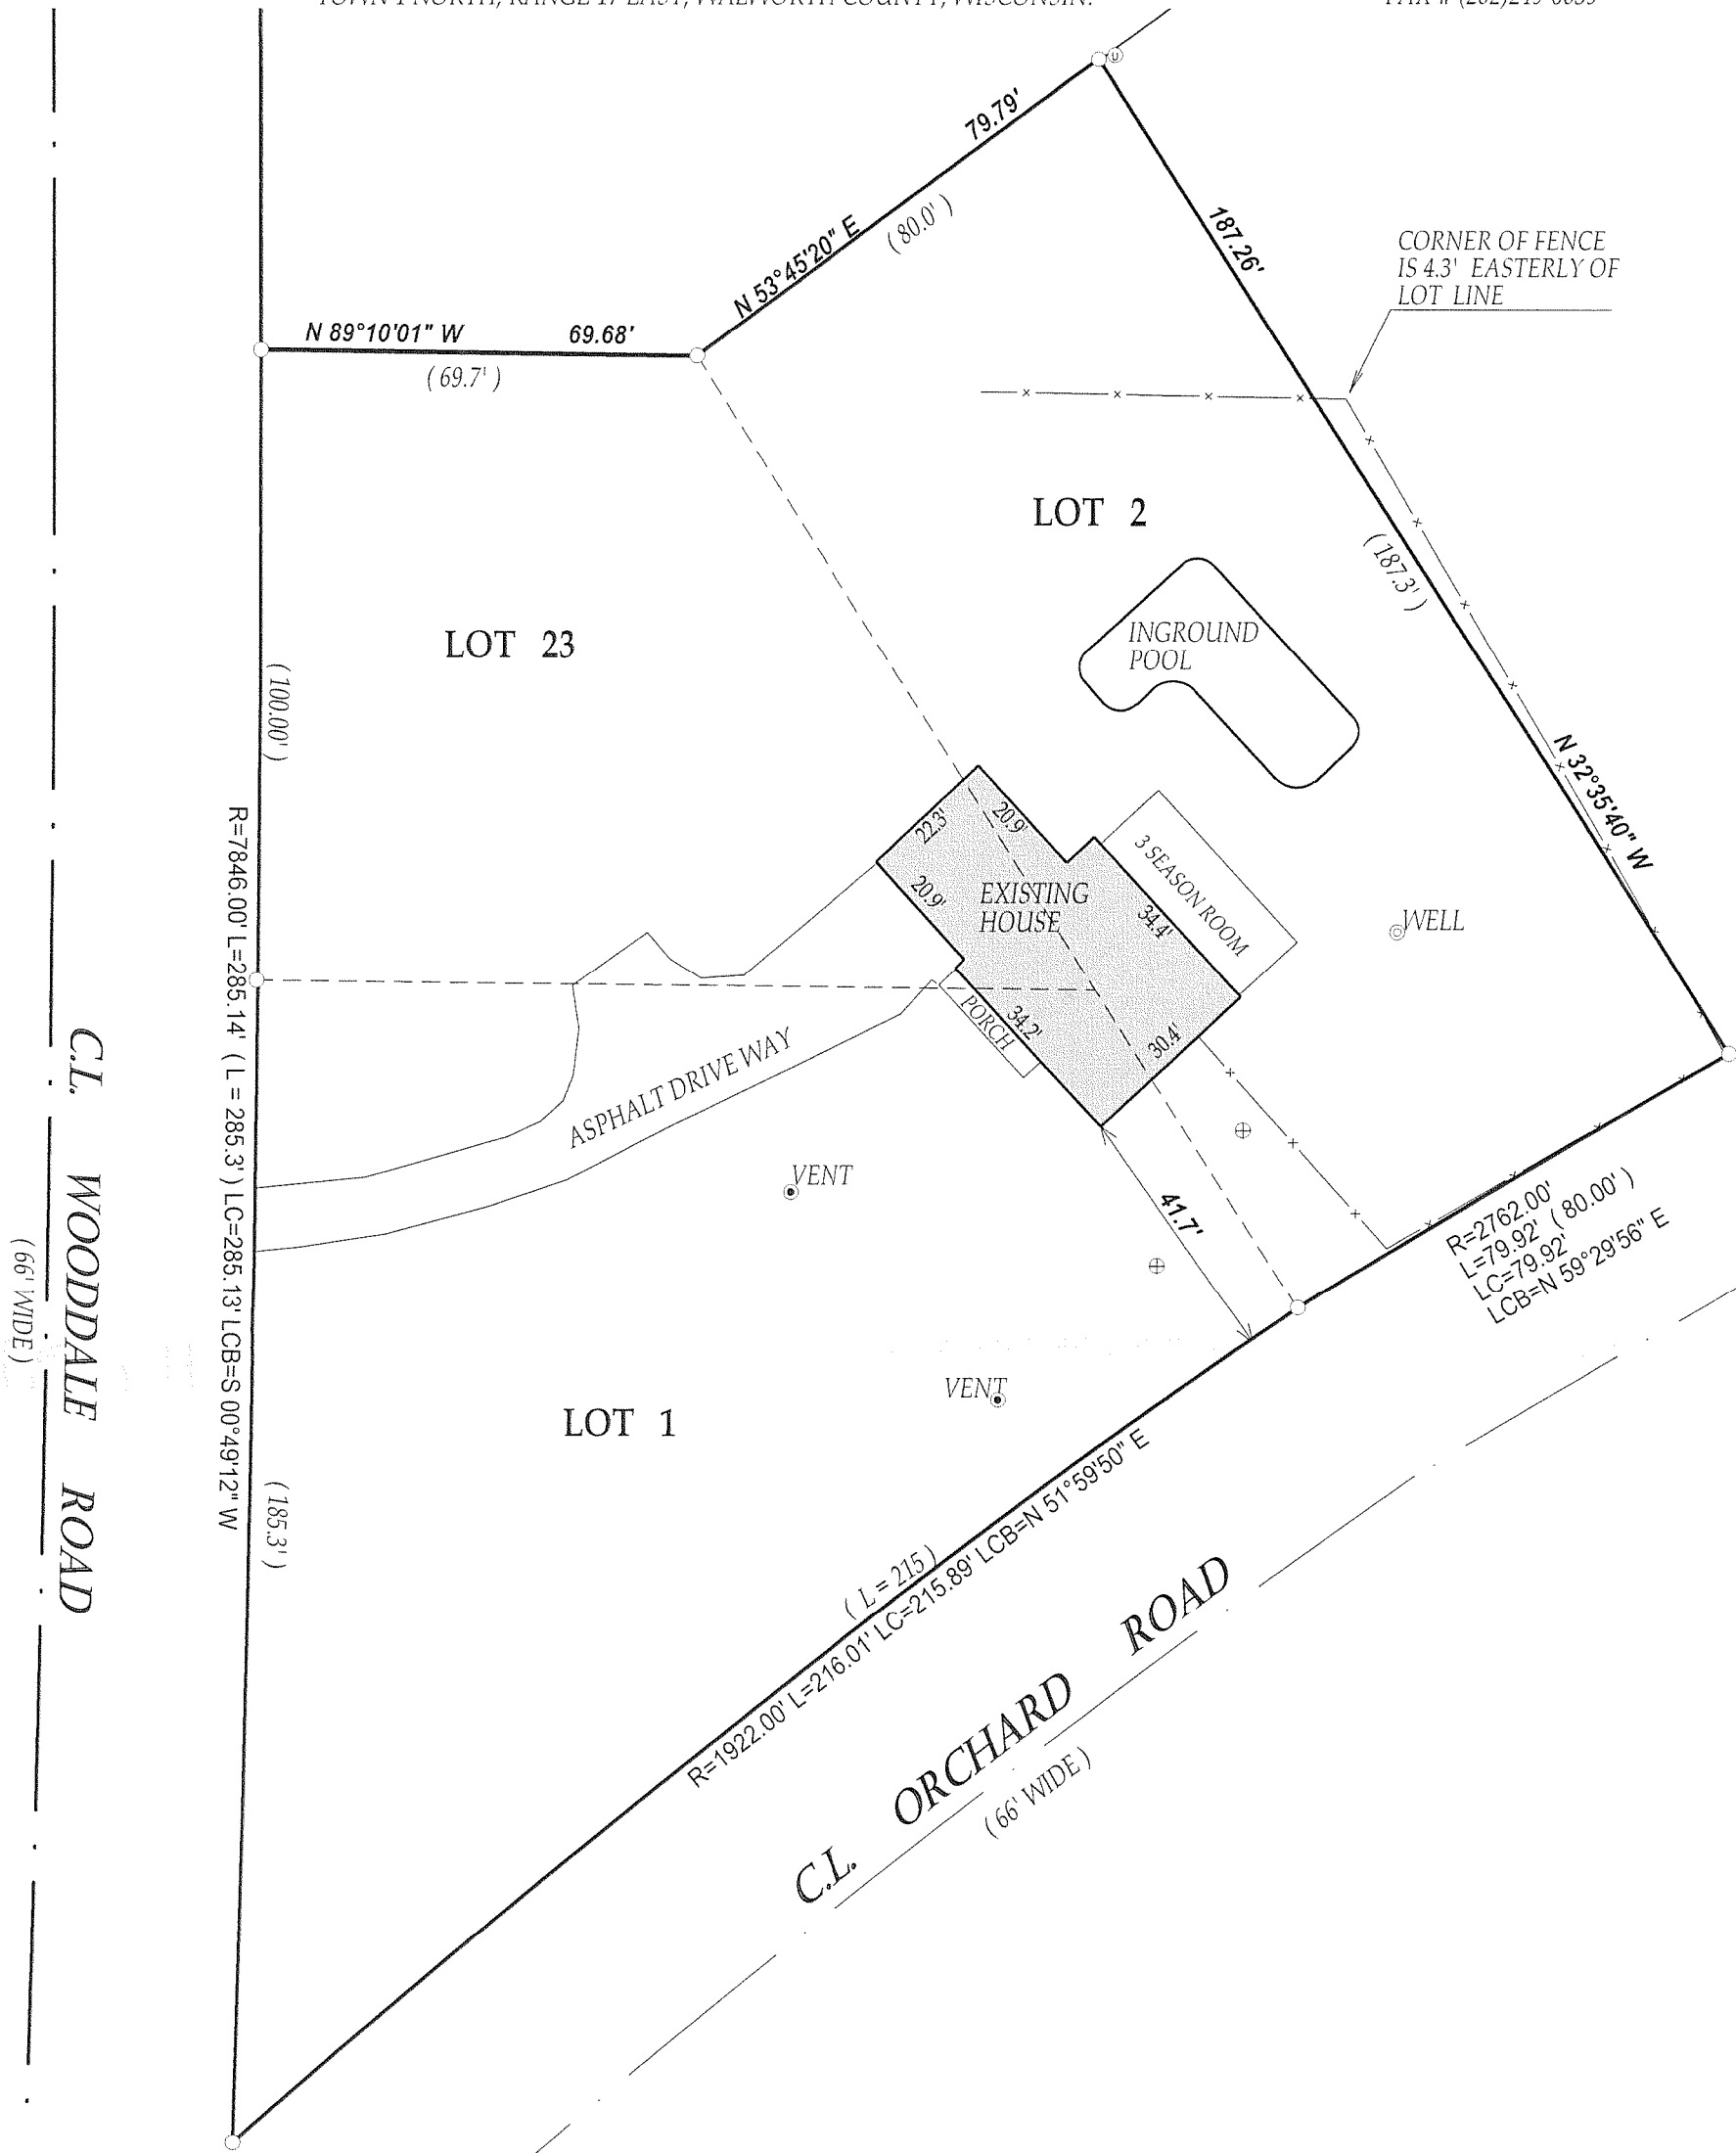


LEGEND

- ⊕ CONCRETE ACCESS COVER
- FOUND IRON PIPE
- ⊙ UTILITY PEDISTALS
- ⊞ TRANSFORMER


(xx) RECORDED AS

JOB # 08-120



TAX ID # 1W00058

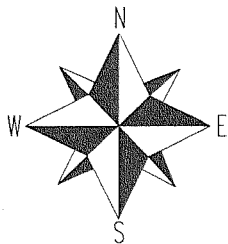

SCALE 1" = 30'

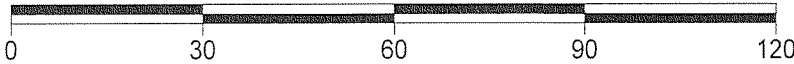

"I hereby certify that I have surveyed the above described property and that the above map is a true representation thereof and shows the size and location of all visible structures, apparent easements and encroachments if any."
This survey is made for the present owners of the property, and those who purchase, mortgage, or guarantee the title thereto, within one year from the date hereof.

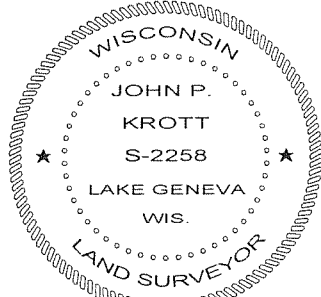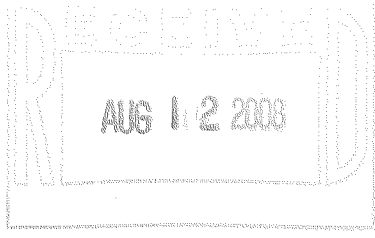

DTED THIS 4th, DAY OF JUNE, 2008

John P. Krott
JOHN KROTT S - 2258
Wisconsin Registered Land Surveyor
(original if signed in red)

117-2973