

Hillside Road


Plat of Survey

of

Lot 14 of Lake Geneva Beach,
a subdivision located in the Southwest 1/4 of Section 11,
Town 1 North, Range 17 East, Town of Linn, Walworth
County, Wisconsin.

Surveyed for: **Richard & Jane Schwab**
902 Buckingham Drive
Wheaton, Illinois. 60187-8053

Survey Date: March 23, 2007.
Revisions: No. 1 - Proposed House
No. 2 - Elevation
No. 3 - Foundation
No. 4 - New Garage
No. 5 - Walks removed

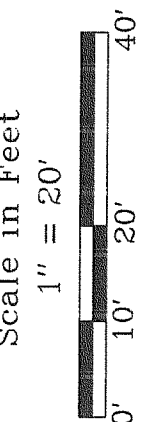

Jensen & Olson Land Surveying, LLC
45 South Wisconsin Street P.O. Box 322
Elkhorn, Wisconsin 53121
Telephone (262) 723-3434
Facsimile (262) 723-8044

Legend
● Found Concrete Monument
○ Found Iron Pipe
○ Found Iron Rod
○ Recorded Information
○ Utility Pole
○ Asphalt Surface
○ Concrete Surface
○ Gravel

Sheet 1 of 1 Sheets
Job Reference Number
2007.016

2007.016

58.39'

Overhead Wires
S68°03'00"E 53.79'

Park Drive
(30' Wide)

Well

Poured
Concrete
Foundation
W3295

Lot 13

N0°24'18"W 180.46'

Lot 14
0.195 Acre
8,477 Sq.Ft.

Metal Cover
Appears to
be holding
tank.

Mutual Easement Agreement
Vol. 633, Page 5480.
Doc. No. 209962

"Building Line"
As shown on the plat
of Lake Geneva Beach

Lot 15

Lot 16

Lot 17

Lot 18

Garage


Poured
Concrete Slab
for Garage

Garage

West 49.74'
(50')

Lot 20

Monument
leans South

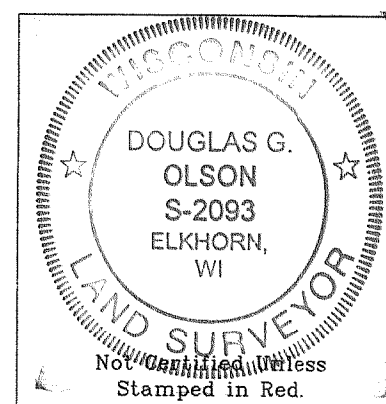


- Notes: 1) This survey plat is not
certified unless signed
and sealed in red ink.
- 2) This survey is subject to Wisconsin lien laws.
This Plat of Survey is the notice of intent
to file lien. Lien waiver required.

Copyright 2007 by Jensen & Olson Land Surveying, LLC.

All rights reserved. No part of this survey plat may be reproduced
or transmitted in any form by any means - graphic, electronic, or
mechanical, including photocopying, tracing, or information storage
and retrieval systems - without permission in writing from Douglas
G. Olson, Jensen & Olson Land Surveying, LLC.

I, Douglas G. Olson, Wisconsin Registered Land Surveyor,
do hereby certify that this survey was performed by me or under my
direction in full compliance with the owner's/agent's instructions
and Chapter A-E 7 of the Wisconsin Administrative Code "Minimum
Standards for Property Surveys", and that this map is an accurate
representation thereof to the best of my knowledge and belief.

Douglas G. Olson
Wisconsin Registered Land Surveyor - 2093

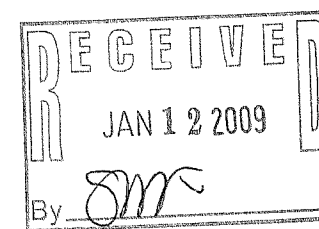

Bearings are assumed.

ILGB-10

117-3017