



PREPARED FOR : DEAN PICHA
146 BELAIRE DR.
BUFFALO GROVE IL 60089

KROTT SURVEYING INC.
N3705 WILLOWBEND LANE
LAKE GENEVA, WI, 53147
262-248-3697

PLAT OF SURVEY

- OF -

LOTS 27 - 29, BLOCK 2, LAKE VIEW PARK,
LOCATED IN TOWN 1 NORTH, RANGE 17
EAST, WALWORTH COUNTY, WISCONSIN.

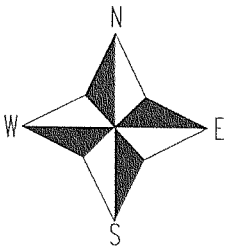
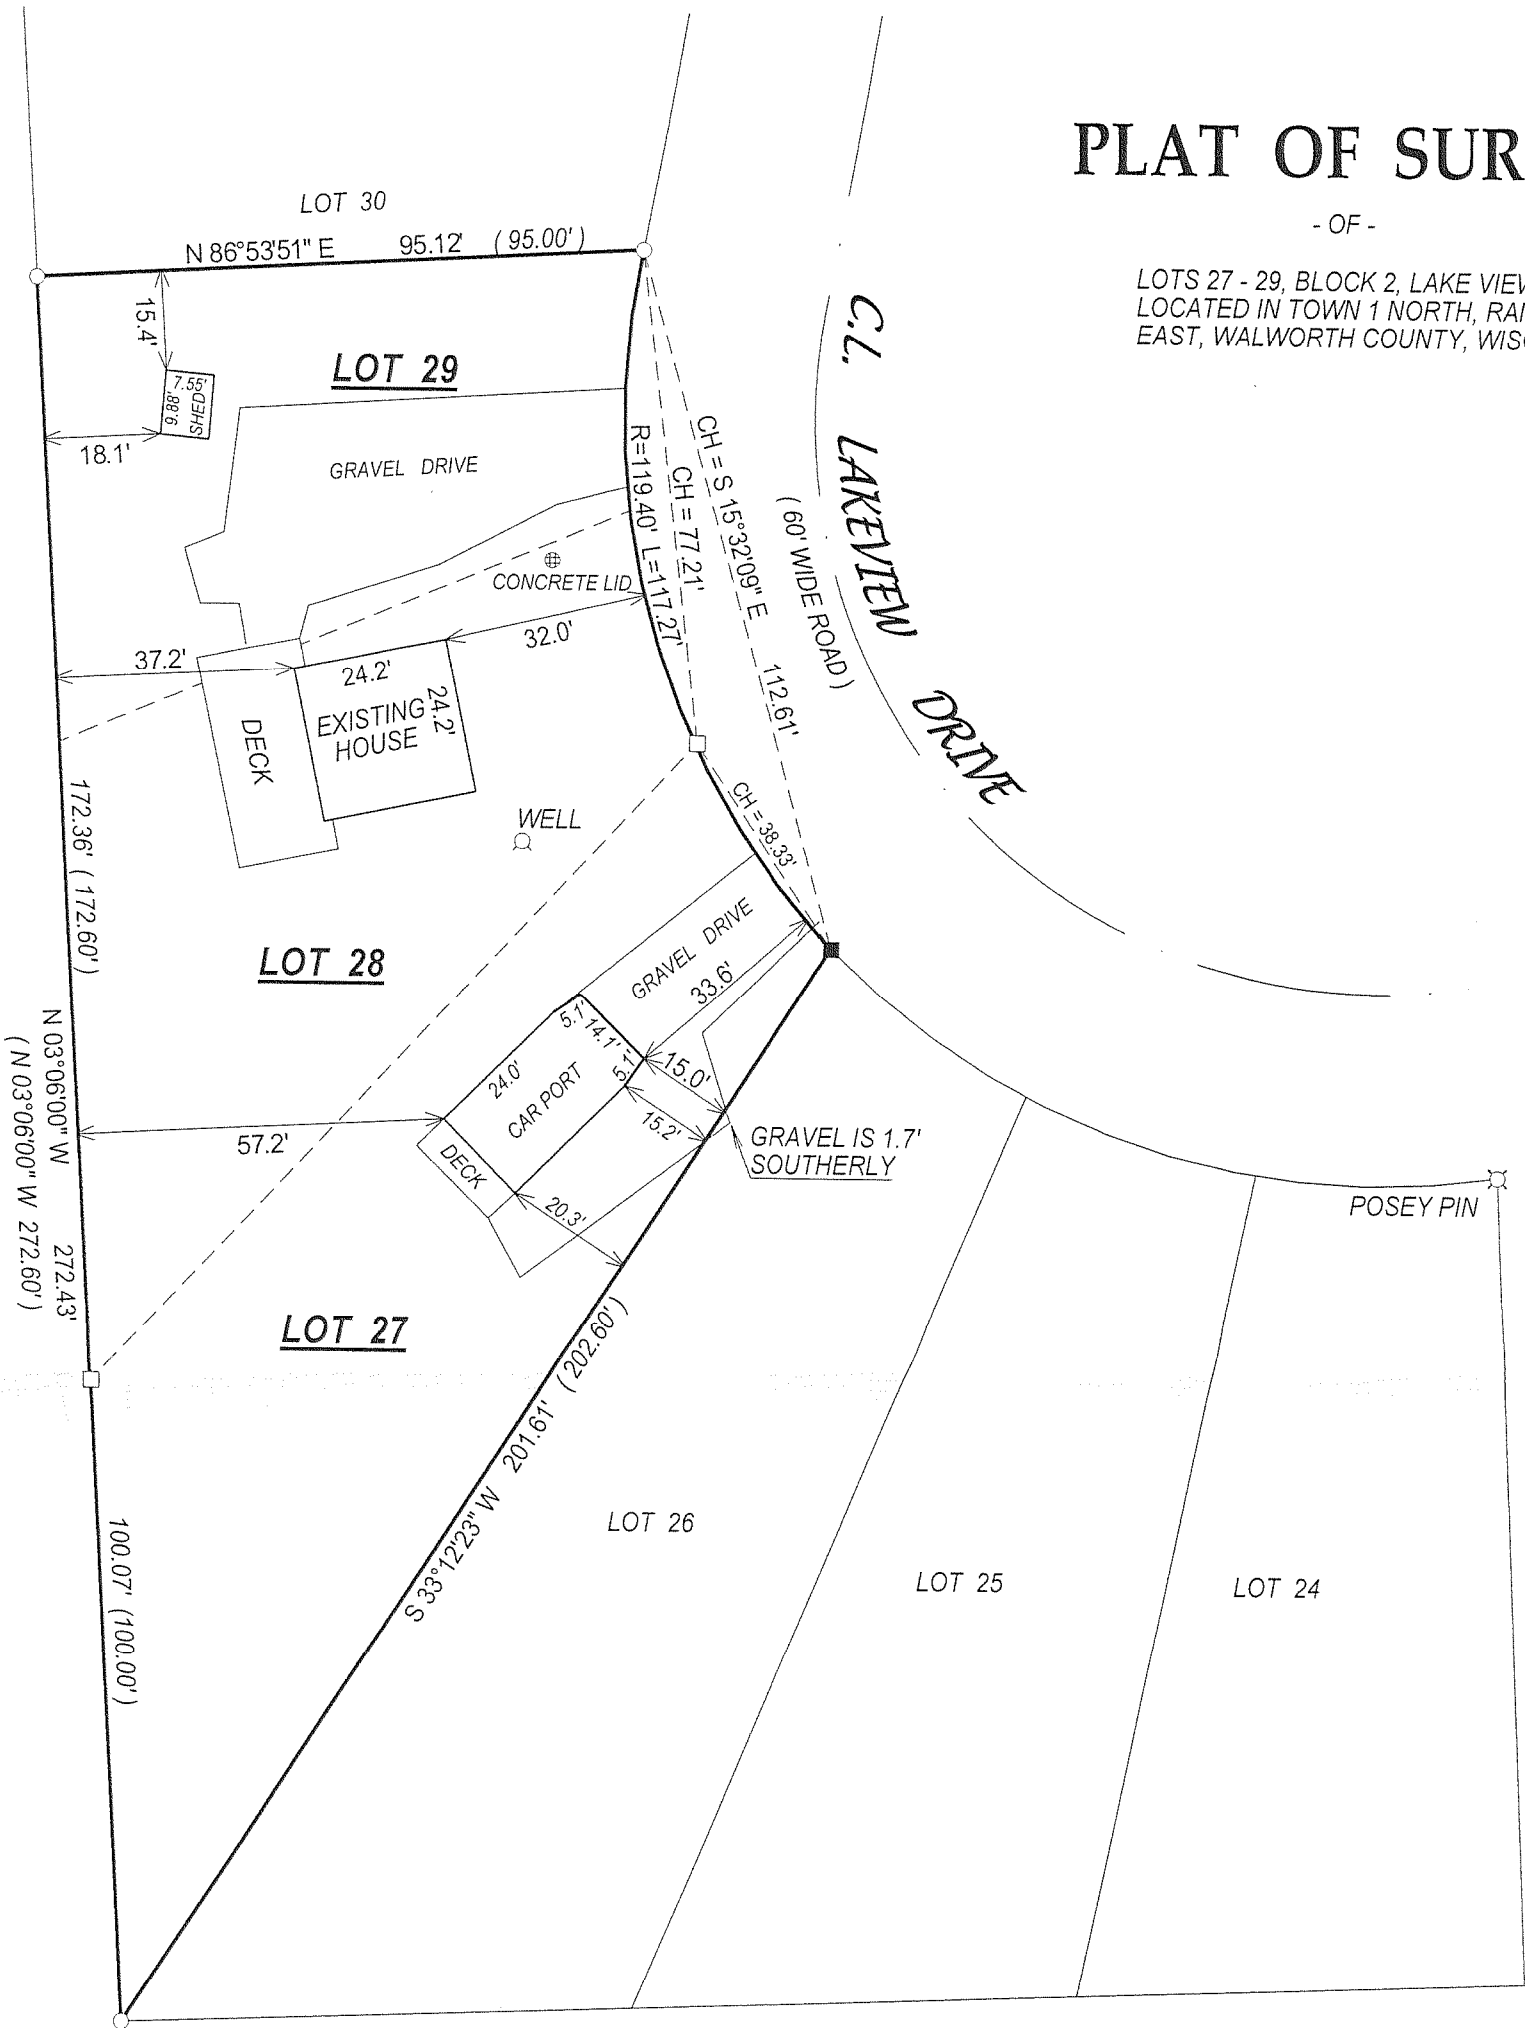


- () = recorded as
- = found iron bar
- = found iron pipe
- = set iron pipe
- = set iron bar

SCALE 1" = 30'

JOB # 05-144AB

TAX ID # ILVP00006B

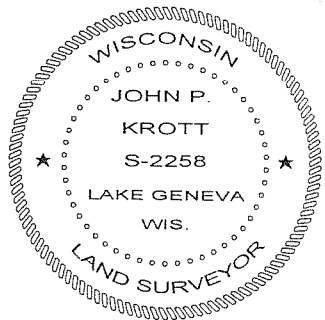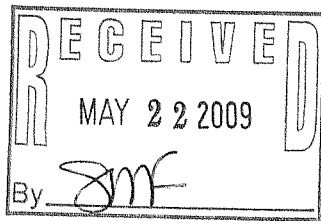

NOTE : BEARINGS ARE REFERENCED TO THE RECORDED SUBDIVISION PLAT.

COMPARE LEGAL DESCRIPTION ABOVE AND DRAWING WITH DEED. FOR BUILDING RESTRICTIONS AND EASEMENTS NOT SHOWN, REFER TO DEED, ABSTRACT SOURCES AND LOCAL MUNICIPAL CODES. NOTIFY THE SURVEYOR IMMEDIATELY OF ANY DISCREPANCY.

"I hereby certify that I have surveyed the above described property and that the above map, to the best of my knowledge and belief, is a true representation thereof and shows the size and location of all visible structures, apparent easements and encroachments if any."

This survey is made for the present owners of the property, and those who purchase, mortgage, or guarantee the title thereto, within one year from the date hereof.

DATE OF LAST REVISION 5 / 12 / 2009.

JOHN KROTT S - 2258
Wisconsin Registered Land Surveyor
(original if signed in red)

DATED THIS 19th DAY OF MARCH 2009.

117-3042