


GEORGE T. DUNHAM
SURVEYING & SUBDIVIDING
DELAVER, WISCONSIN


N

Scale - 1" = 20'
o = Iron Pipe

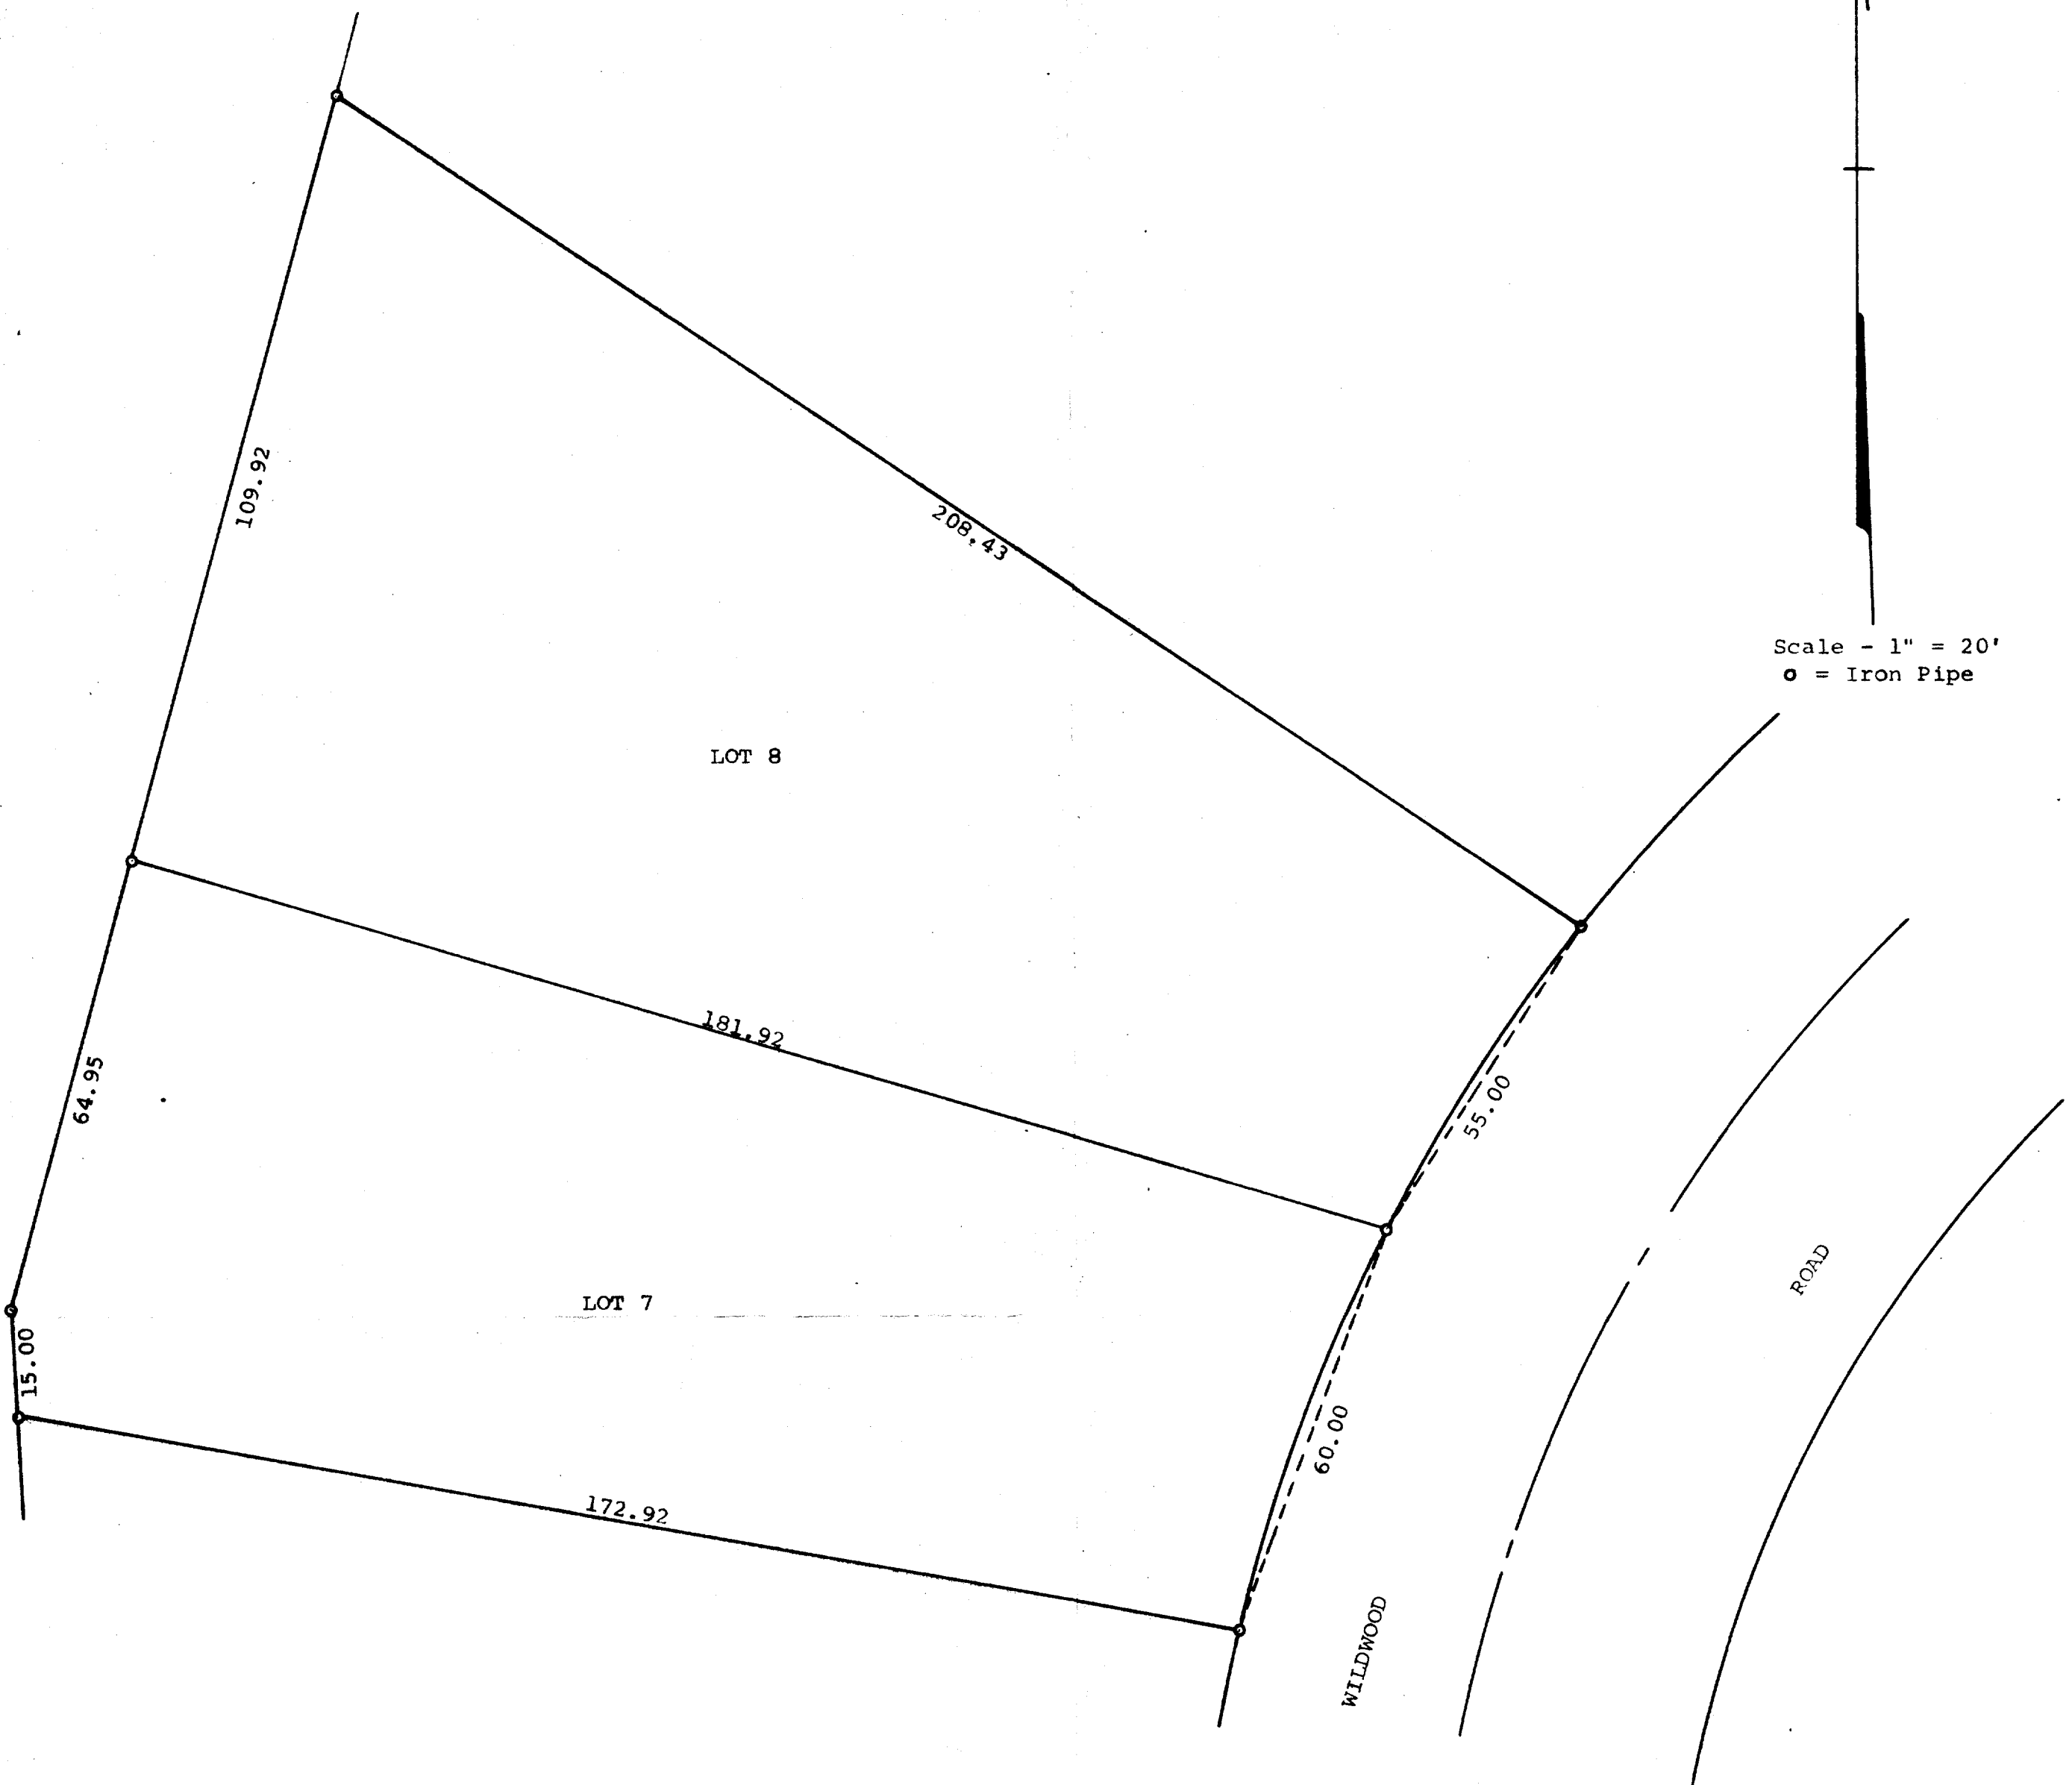

Plat of survey of Lots 7 and 8 in Block 15 of Wooddale
Addition, located in Section 16, T 1 N, R 17 E, Walworth
County, Wisconsin.
March 17, 1972

George T. Dunham
George T. Dunham, Surveyor

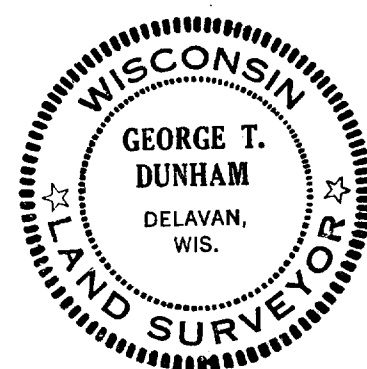

I W-77B

117-318