




**N9330 Knuteson Drive
Whitewater, WI 53190
Phone:(262)495-3284
FAX : (262) 495-8421
LAND-MARKSURVEYING.COM**

ORDERED BY: DOVETAIL CONSTRUCTION, INC.
2491 CREST DRIVE
P.O. BOX 175
LAKE GENEVA, WI. 53147-0175

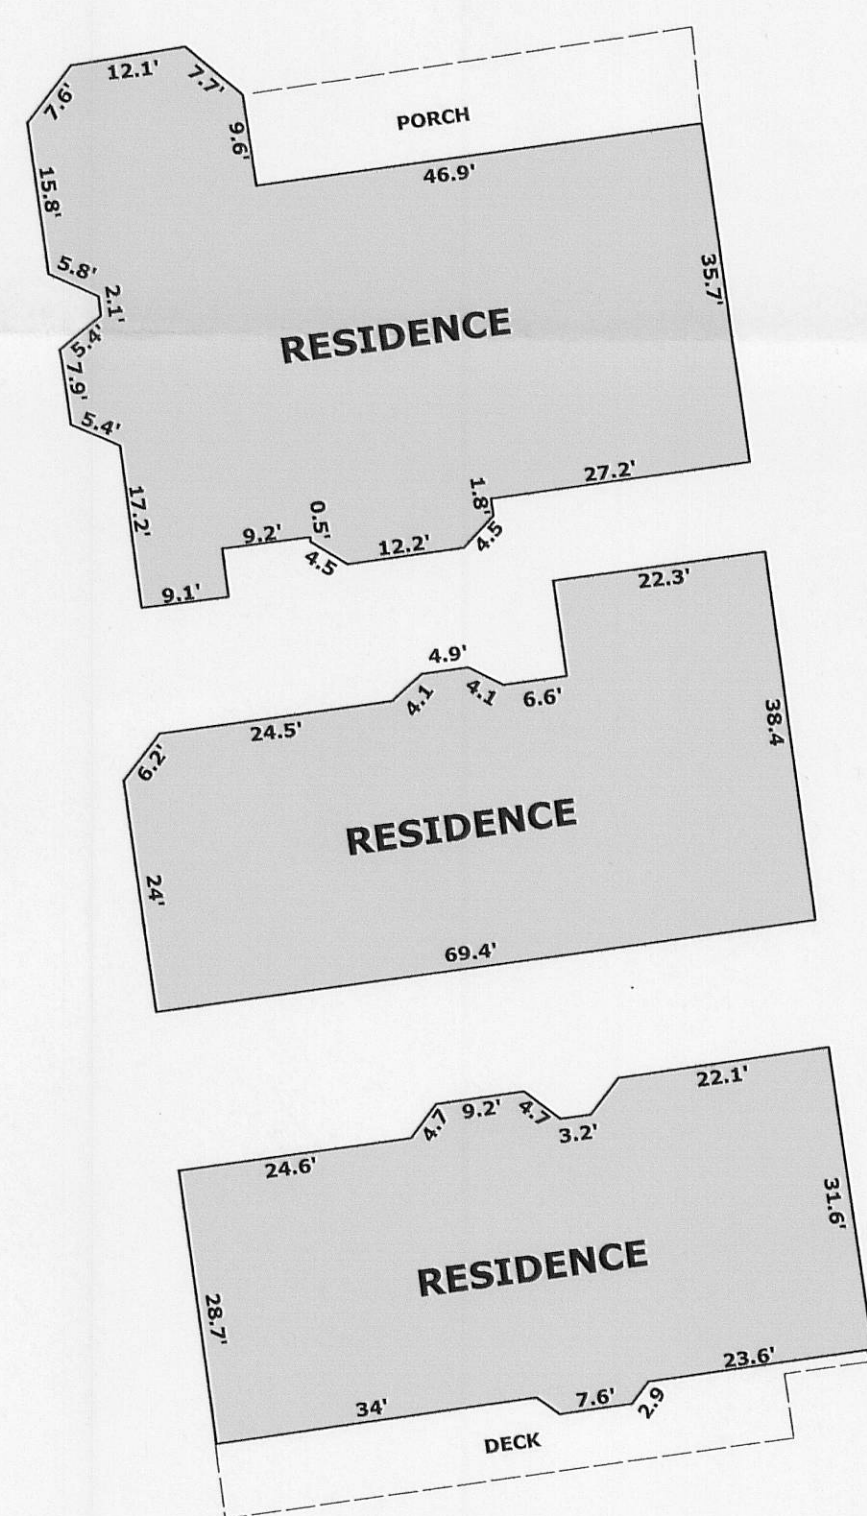

RESIDENCES DETAIL

SCALE: 1 INCH = 20 FEET

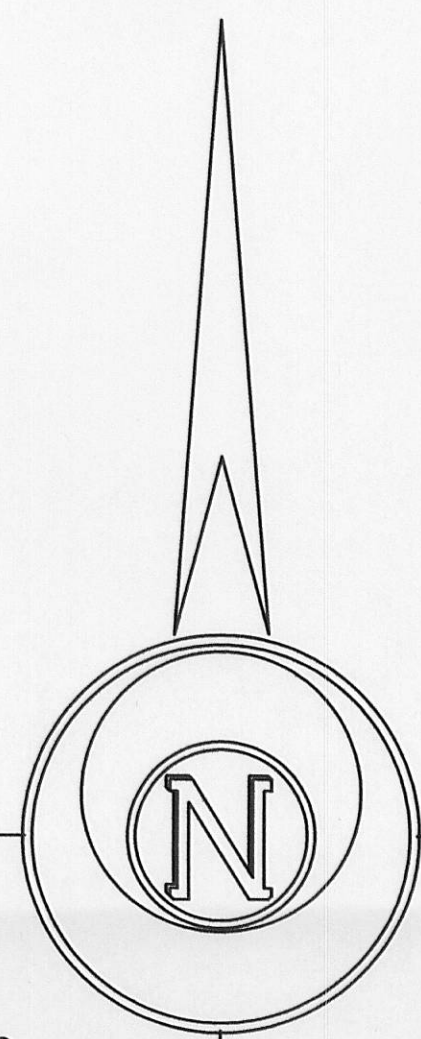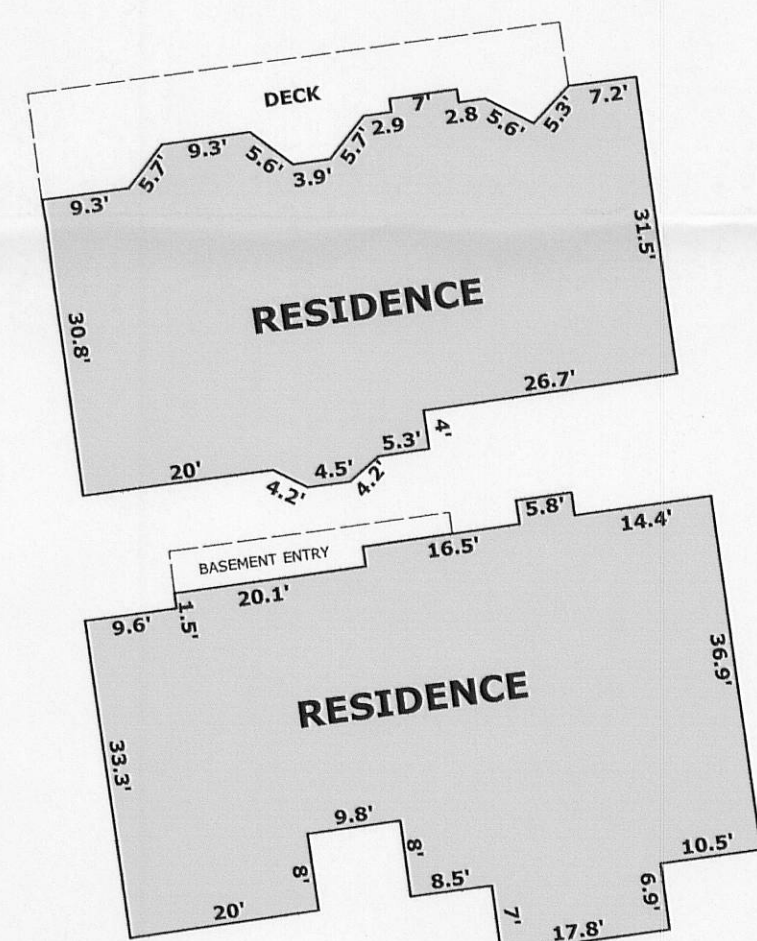

Horizontal Datum is based on the Wisconsin State Plane Coordinate System Grid, South Zone, all bearings are referred to Grid North

LEGEND

- | | |
|---|--|
|  | FOUND IRON PIPE |
|  | FOUND IRON ROD |
|  | FOUND COUNTY MONUMENT |
|  | FOUND CONCRETE MONUMENT |
|  | CHISEL CUT IN CONCRETE |
|  | SET IRON PIPE, 24" LONG, WEIGHING
1.13 LBS./LINEAL FT., 1 1/4" DIA. |
| (x x) | RECORDED AS DIMENSION |
|  | EXISTING FENCE |

SCALE: 1" = 50 FEET

"I hereby certify that the above described property has been surveyed by me or under my direction and that the above map is a true representation thereof and shows the size and location of the property, its exterior boundaries, the location of all visible structures and dimensions of all principal buildings thereon, boundary fences, apparent easements, roadways and visible encroachments, if any.

"This survey is made for the use of the present owners the property, and also those who purchase, mortgage, or guarantee the title thereto within one year from date hereof."

MARK L. MIRITZ
WISCONSIN REGISTERED
LAND SURVEYOR S-2582

DATE: DECEMBER 12, 2004 JOB NO. 04.1004

REVISED MAY 31, 2005 TO SHOW GARAGES "AS BUILT"
REVISED APRIL 7, 2005 TO SHOW PROPOSED GARAGES

ICL-1 ICL-2 ICL-3 ICL-4 ICL-5

117-3213