


SITE PLAN FOR PROPOSED POOL


PART OF LOTS 11 AND 12 OF
CHAPINS SUBDIVISION, LOCATED IN
THE SOUTHEAST 1/4 OF SECTION 4,
TOWN 1 NORTH, RANGE 17 EAST,
TOWN OF LINN, WALWORTH COUNTY,
WISCONSIN.

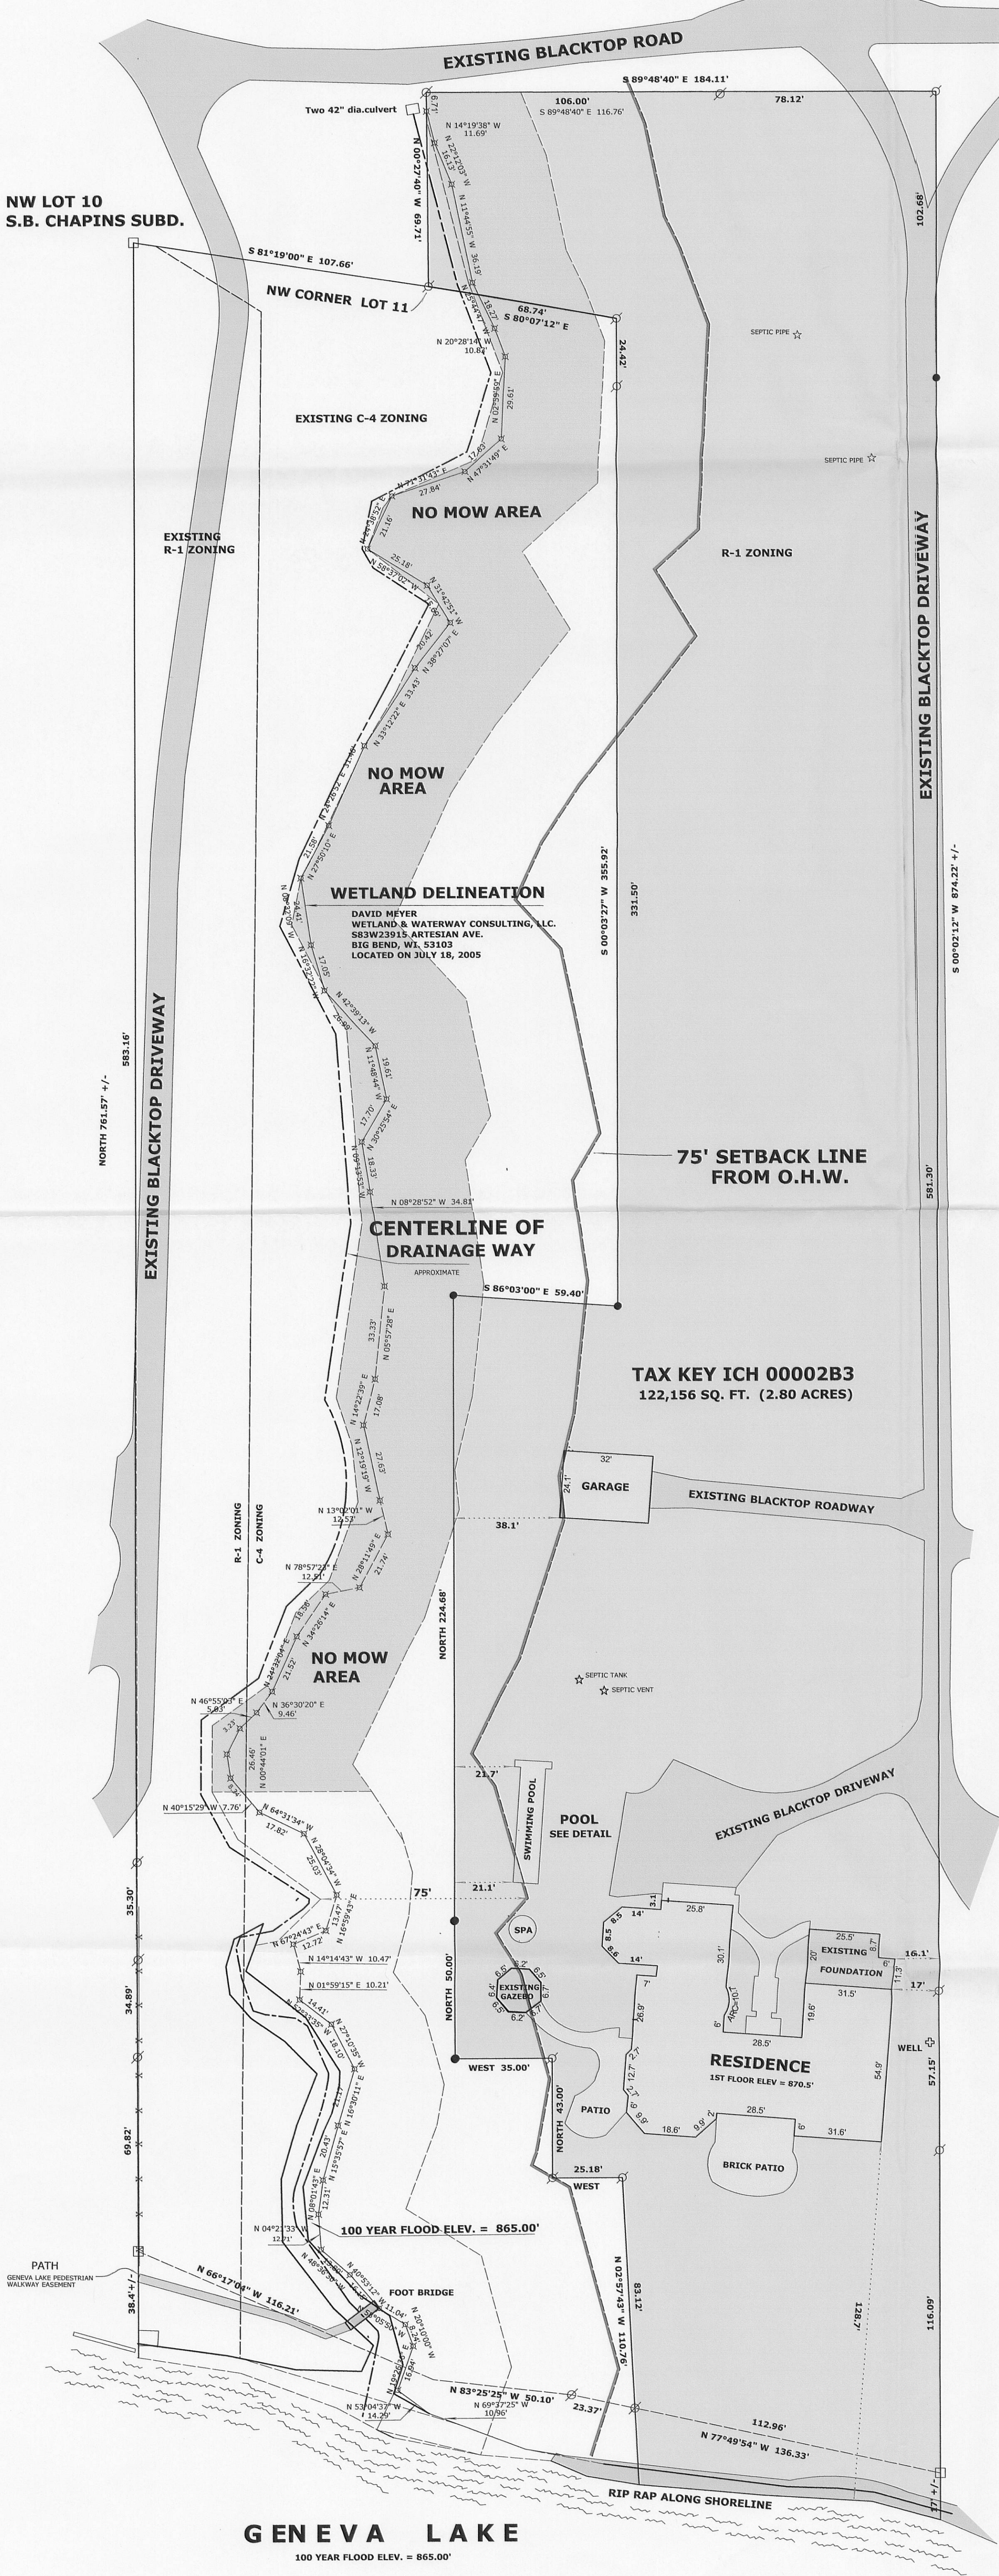

OWNER: DANIEL J. WALSH TRUST
DANIEL J. WALSH TRUSTEE
91 CHAPIN RD.
LAKE GENEVA, WI. 53147

NOTE
1) THIS PLAT IS BASED ON A PREVIOUS PLAT OF SURVEY
PREPARED BY ABERNATHY AND ASSOCIATES DATED NOV.
2, 1994 AS JOB NO. 94.906. REFER TO THIS PLAT FOR
EXTERIOR BOUNDARY AND EASEMENT INFORMATION.

EXISTING POOL DETAIL
1 INCH = 10 FEET
LOCATED JULY 26, 2006

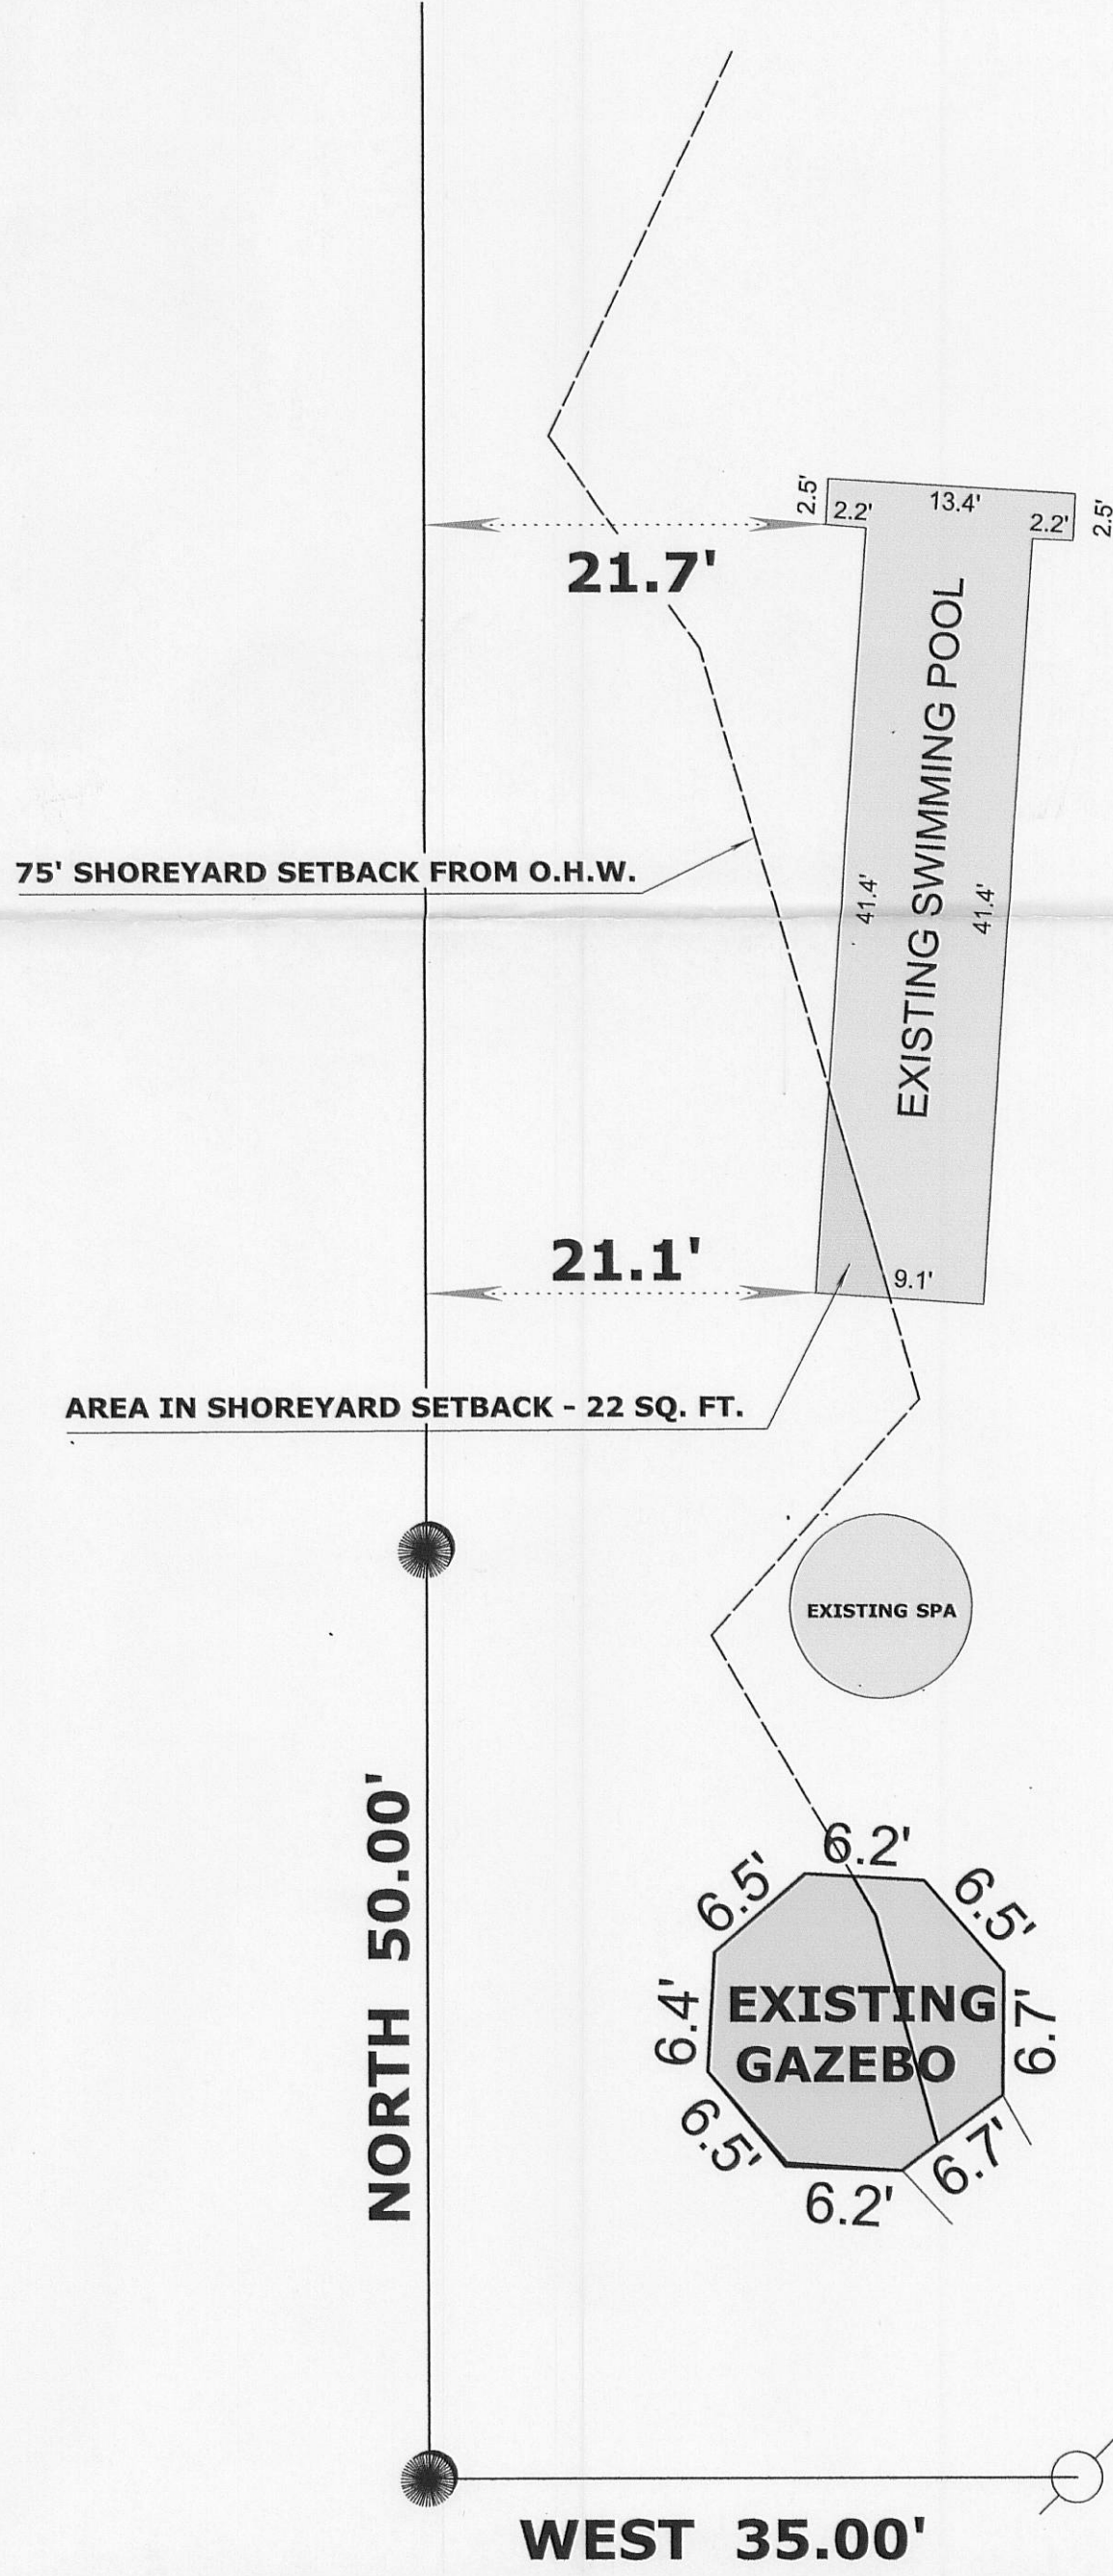


COMPUTATION OF AREA OF STRUCTURES IN THE SHOREYARD SETBACK

GARAGE..... 10.0' SQ. FT.
GAZEBO..... 140.0' SQ. FT.
EXISTING POOL..... 22.0' SQ. FT.
172.0 SQ. FT.

TOTAL LENGTH OF CREEK 982'
NO MOW AREA 37.5' X 687'

- LEGEND
- FOUND IRON PIPE
 - FOUND IRON ROD
 - FOUND COUNTY MONUMENT
 - FOUND CONCRETE MONUMENT
 - CHISEL CUT IN CONCRETE
 - SET IRON ROD, 24" LONG, WEIGHING 1.5 LBS./LINEAL FT., 3/4" DIA.
 - (x x) RECORDED AS DIMENSION
 - EXISTING FENCE
- SCALE: 1" = 30 FEET

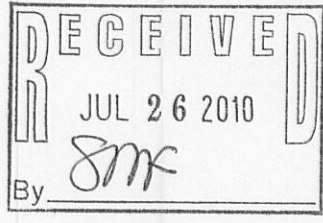

Mark L. Miritz
MARK L. MIRITZ
WISCONSIN REGISTERED
LAND SURVEYOR S-2582
DATE: MARCH 20, 2006 JOB NO. 04.1102