


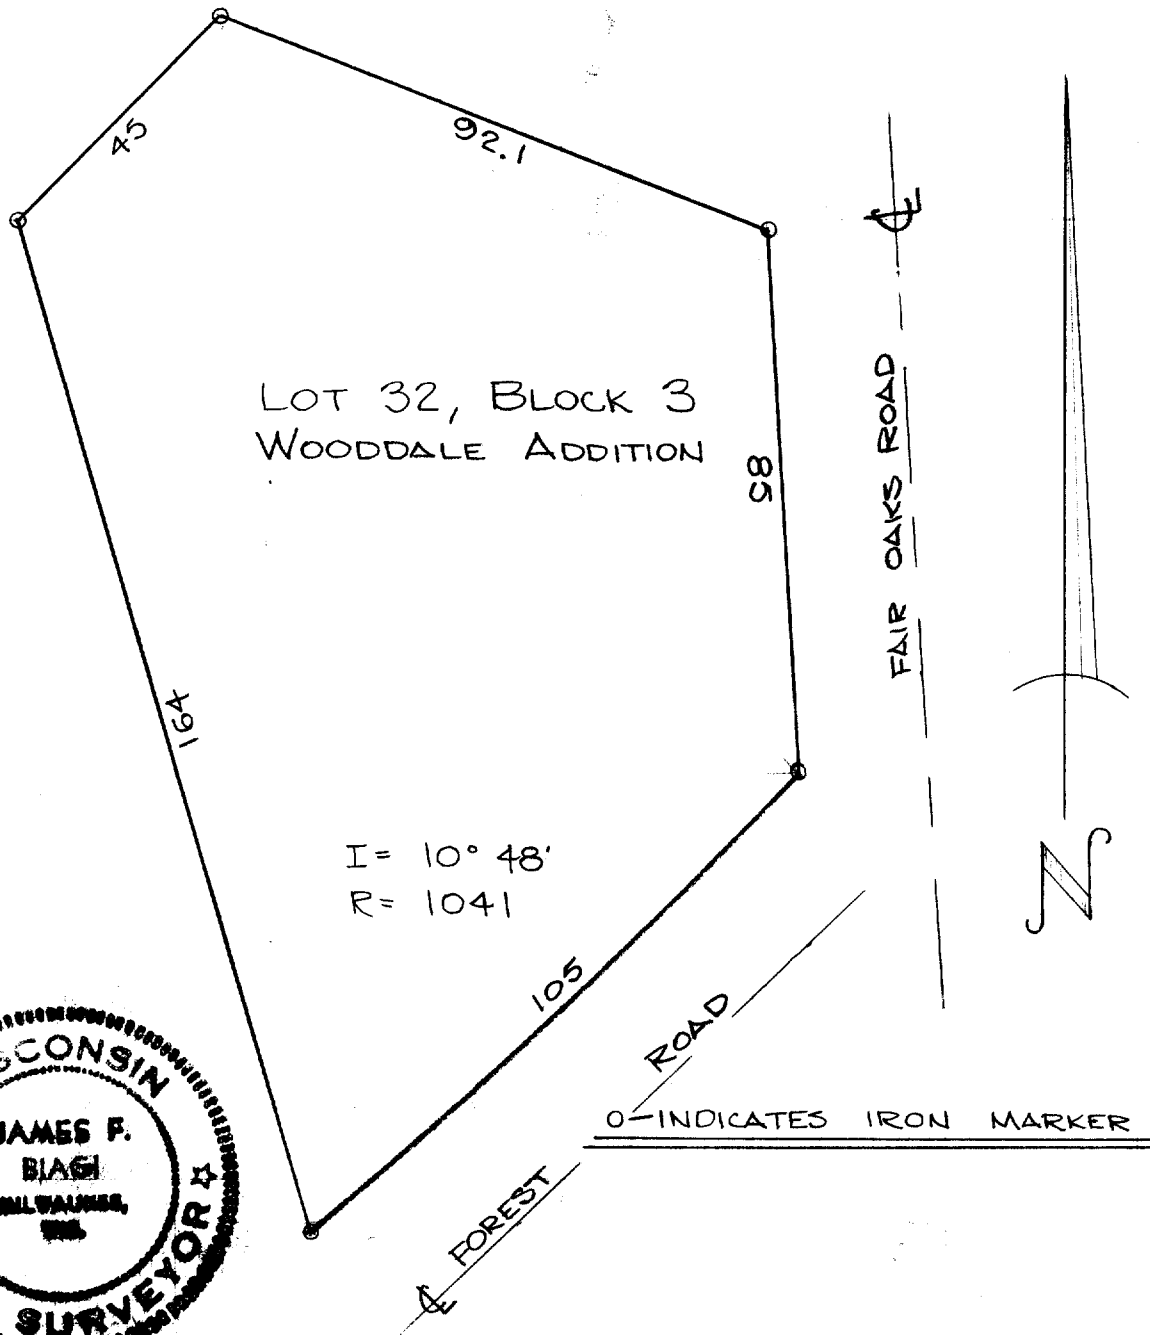

DESCRIPTION: Lot 32 of Block 3 of Wooddale Addition located in Section 9 of T. 1 N., R. 17 E., Walworth County, Wisconsin.

CERTIFICATE: I, James F. Biagi, surveyor, do hereby certify that I have surveyed the property hereon described.

July 3, 1968.

James F. Biagi
James F. Biagi, RLS 272

I W-42