


# BOUNDARY & TOPOGRAPHIC SURVEY

LOTS 11 & 12 OF BLOCK 14 OF WOODDALE ADDITION

LOCATED IN SECTIONS 9 AND 16, TOWN 1 NORTH, RANGE 17 EAST  
WALWORTH COUNTY, WI.

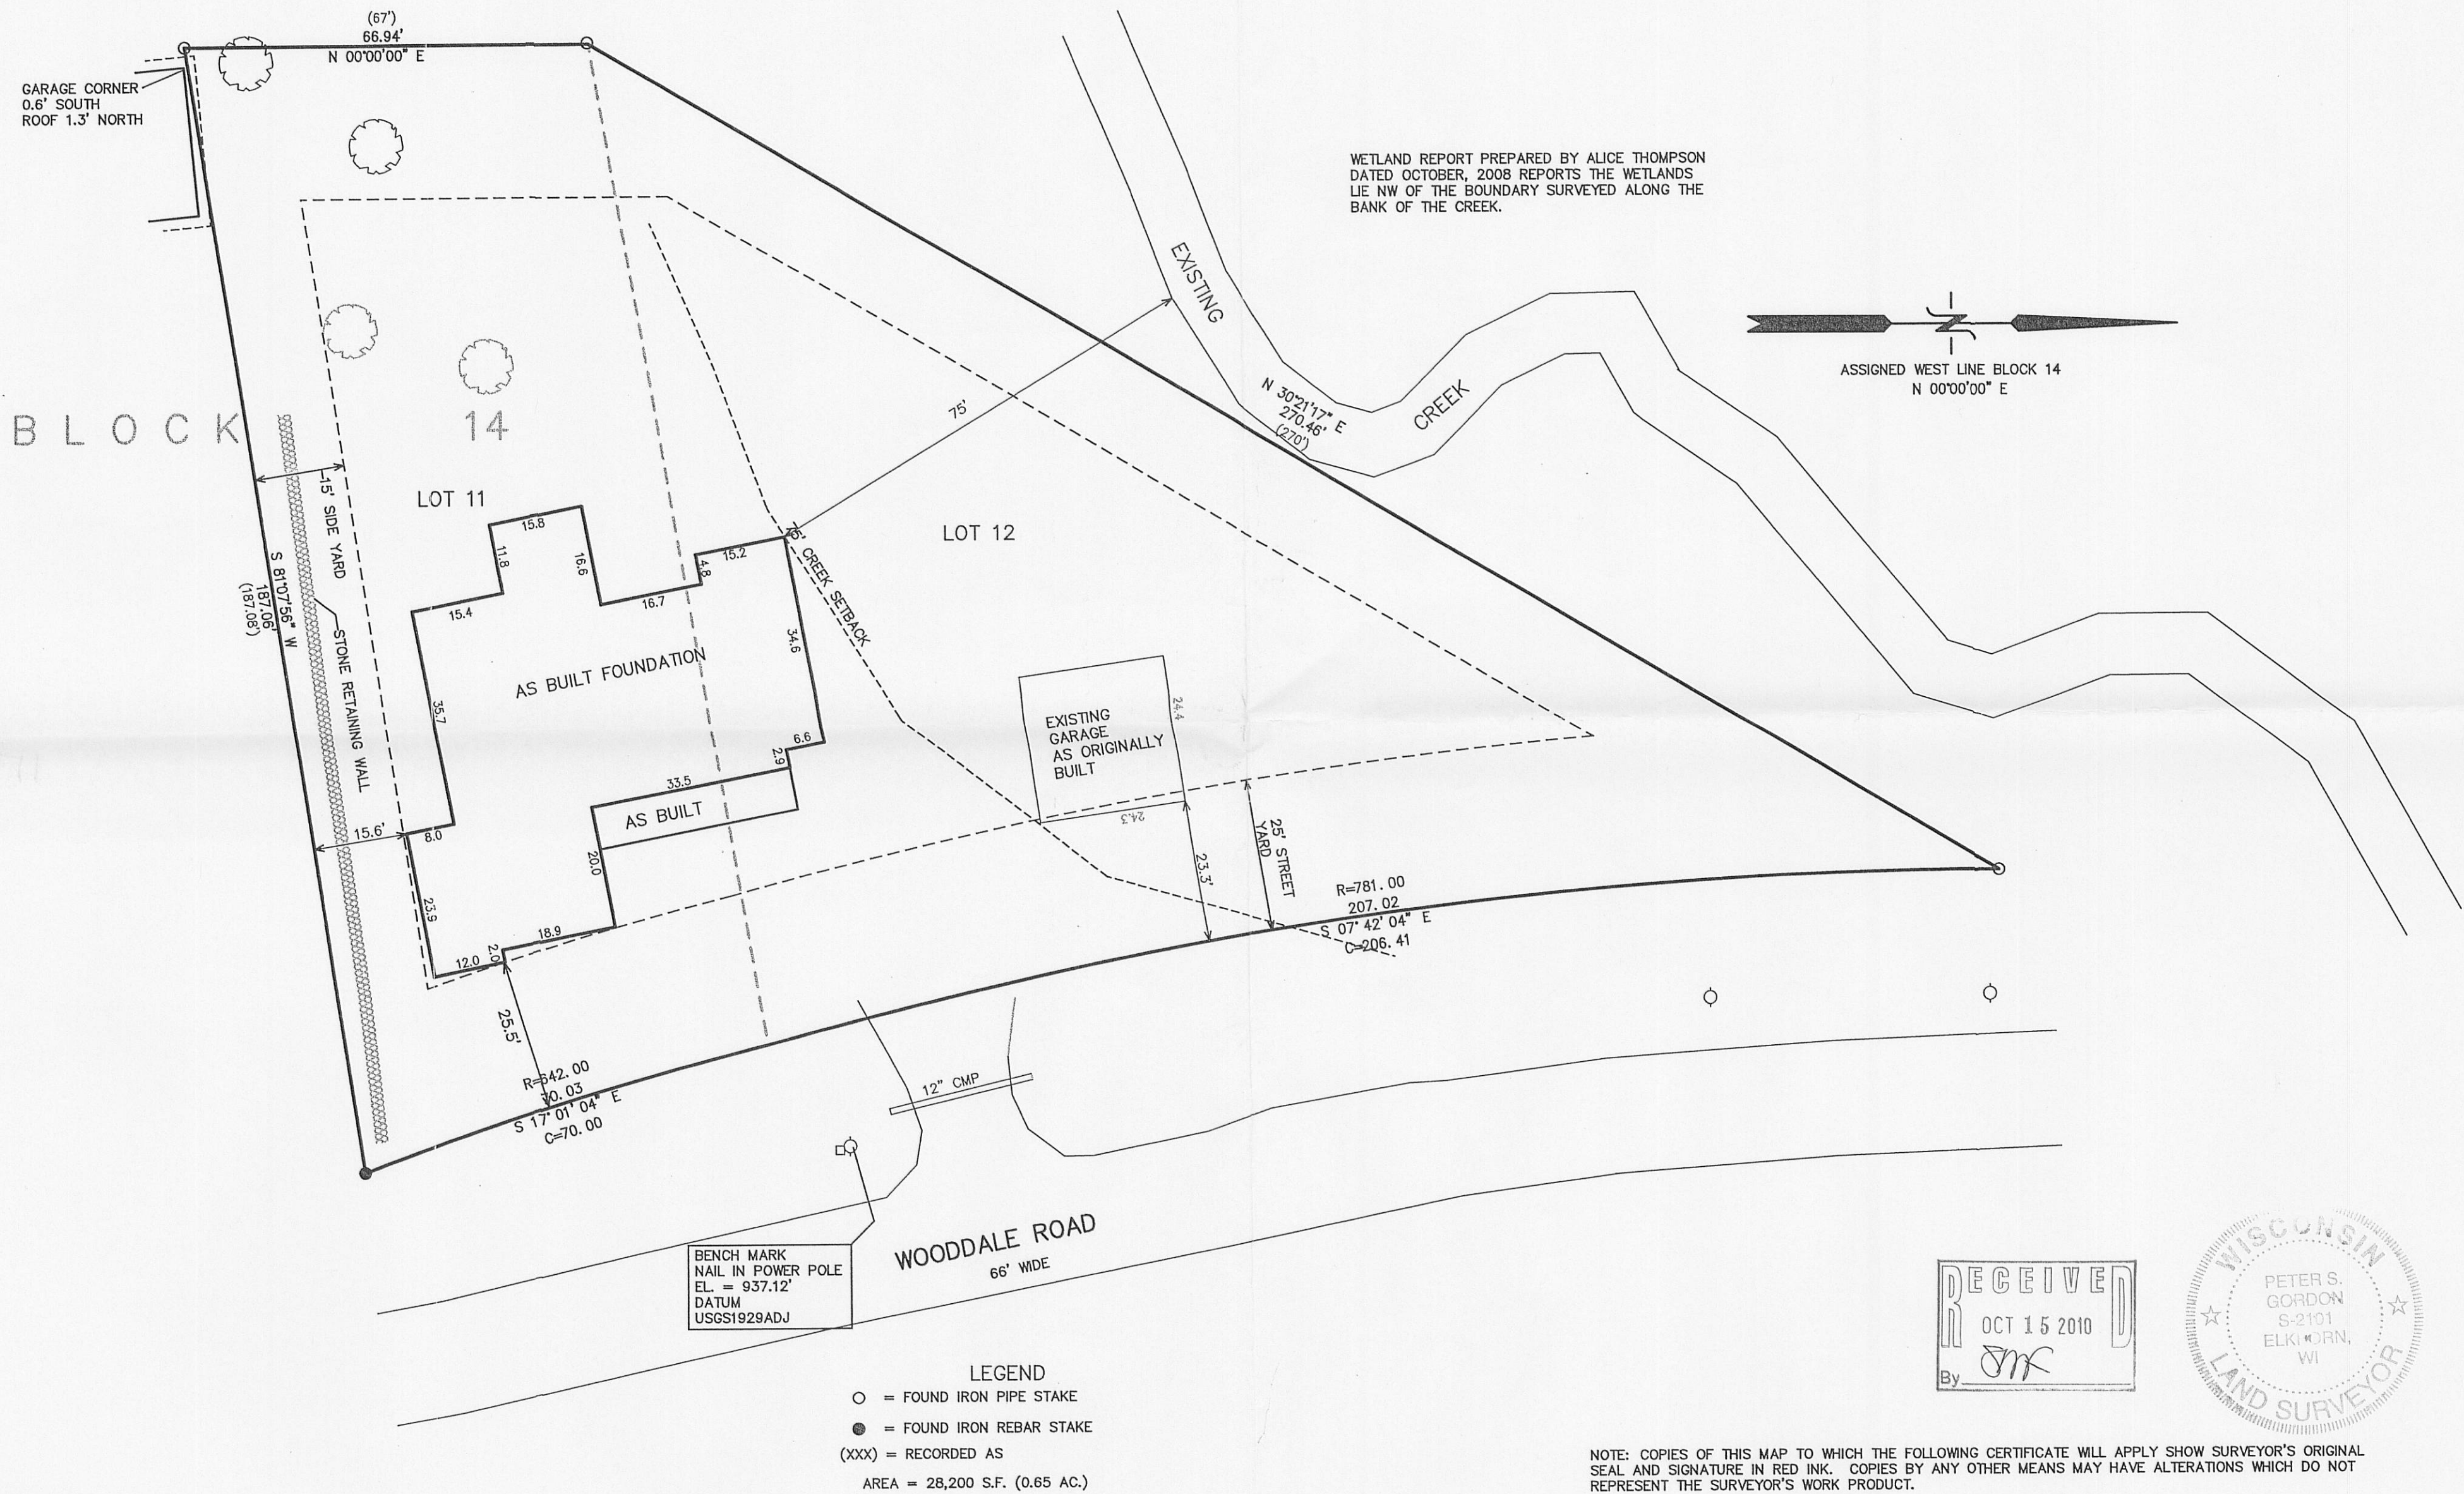

NOTE: COPIES OF THIS MAP TO WHICH THE FOLLOWING CERTIFICATE WILL APPLY SHOW SURVEYOR'S ORIGINAL SEAL AND SIGNATURE IN RED INK. COPIES BY ANY OTHER MEANS MAY HAVE ALTERATIONS WHICH DO NOT REPRESENT THE SURVEYOR'S WORK PRODUCT.

I HEREBY CERTIFY THAT THE ABOVE DESCRIBED PROPERTY HAS BEEN SURVEYED UNDER MY DIRECTION AND THAT THE ABOVE MAP IS A TRUE REPRESENTATION THEREOF AND SHOWS THE SIZE AND LOCATION OF THE PROPERTY AND ITS EXTERIOR BOUNDARIES. THIS SURVEY IS MADE FOR THE USE OF THE PRESENT OWNERS OF THE PROPERTY, AND ALSO THOSE WHO PURCHASE, MORTGAGE, OR GUARANTEE THE TITLE THERETO WITHIN ONE YEAR FROM THE DATE HEREOF.

DATED: MARCH 23, 2010

REVISED 05-19-2010  
TO SHOW PROPOSED RESIDENCE

PETER S. GORDON R.L.S. 2101

REVISED 09-23-2010  
TO SHOW SIZE & LOCATION OF  
AS BUILT RESIDENCE

WORK ORDERED BY:  
DEVORA BUDNICK  
3100 N. SHERIDAN ROAD APT. 8B  
CHICAGO, IL 60657

FARRIS, HANSEN & ASSOCIATES, INC.  
ENGINEERING - ARCHITECTURE - SURVEYING  
7 RIDGWAY COURT P.O. BOX 437  
ELKHORN, WISCONSIN 53121  
OFFICE: (262) 723-2088 FAX: (262) 723-5886

REVISIONS

PROJECT NO.  
8089  
DATE:  
03-22-2010  
SHEET NO.  
1 OF 1

SEP 28 2010

9/23/2010 X:\Projects\8089\WOODDALE\PERMIT