


KROTT SURVEYING INC.
N3705 WILLOW BEND LANE
LAKE GENEVA WI. 53147
PHONE # (262)248-3697
FAX # (262)249-0639

-OF-

RECEIVED
OCT 26 2010
By *SMF*

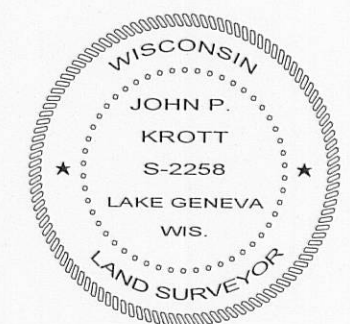

John P. Hall

LEGEND

- FOUND IRON PIPE
- FOUND IRON BAR
- SET IRON BAR
- Q WELL
- ⊕ CONCRETE SEPTIC LID

(XX) RECORDED AS


TAX ID # IZ00020

JOB # 10-148AB

I have surveyed the above-described property and the above map is a true representation thereof and shows the size and location of the property, its exterior boundaries, the location and dimensions of all structures thereon, fences apparent easements and roadways and visible encroachments, if any.

This survey is made for the exclusive use of the present owners of the property, and also those who purchase, mortgage, or insure the title thereto within one (1) year from date hereof; and as to them I warrant the accuracy of said survey map.

NOTE : BEARINGS ARE REFRENCED TO THE RECORD PLAT.

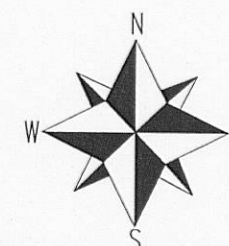

SCALE 1"=30'

