



PLAT OF SURVEY

LOT 2, THE LINDENS, LOCATED IN SECTION 8, TOWN 1 NORTH,
RANGE 17 EAST, WALWORTH COUNTY, WISCONSIN.

N3705 WILLOW BEND LANE
LAKE GENEVA WI. 53147
PHONE # (262)248-3697
FAX # (262)249-0639

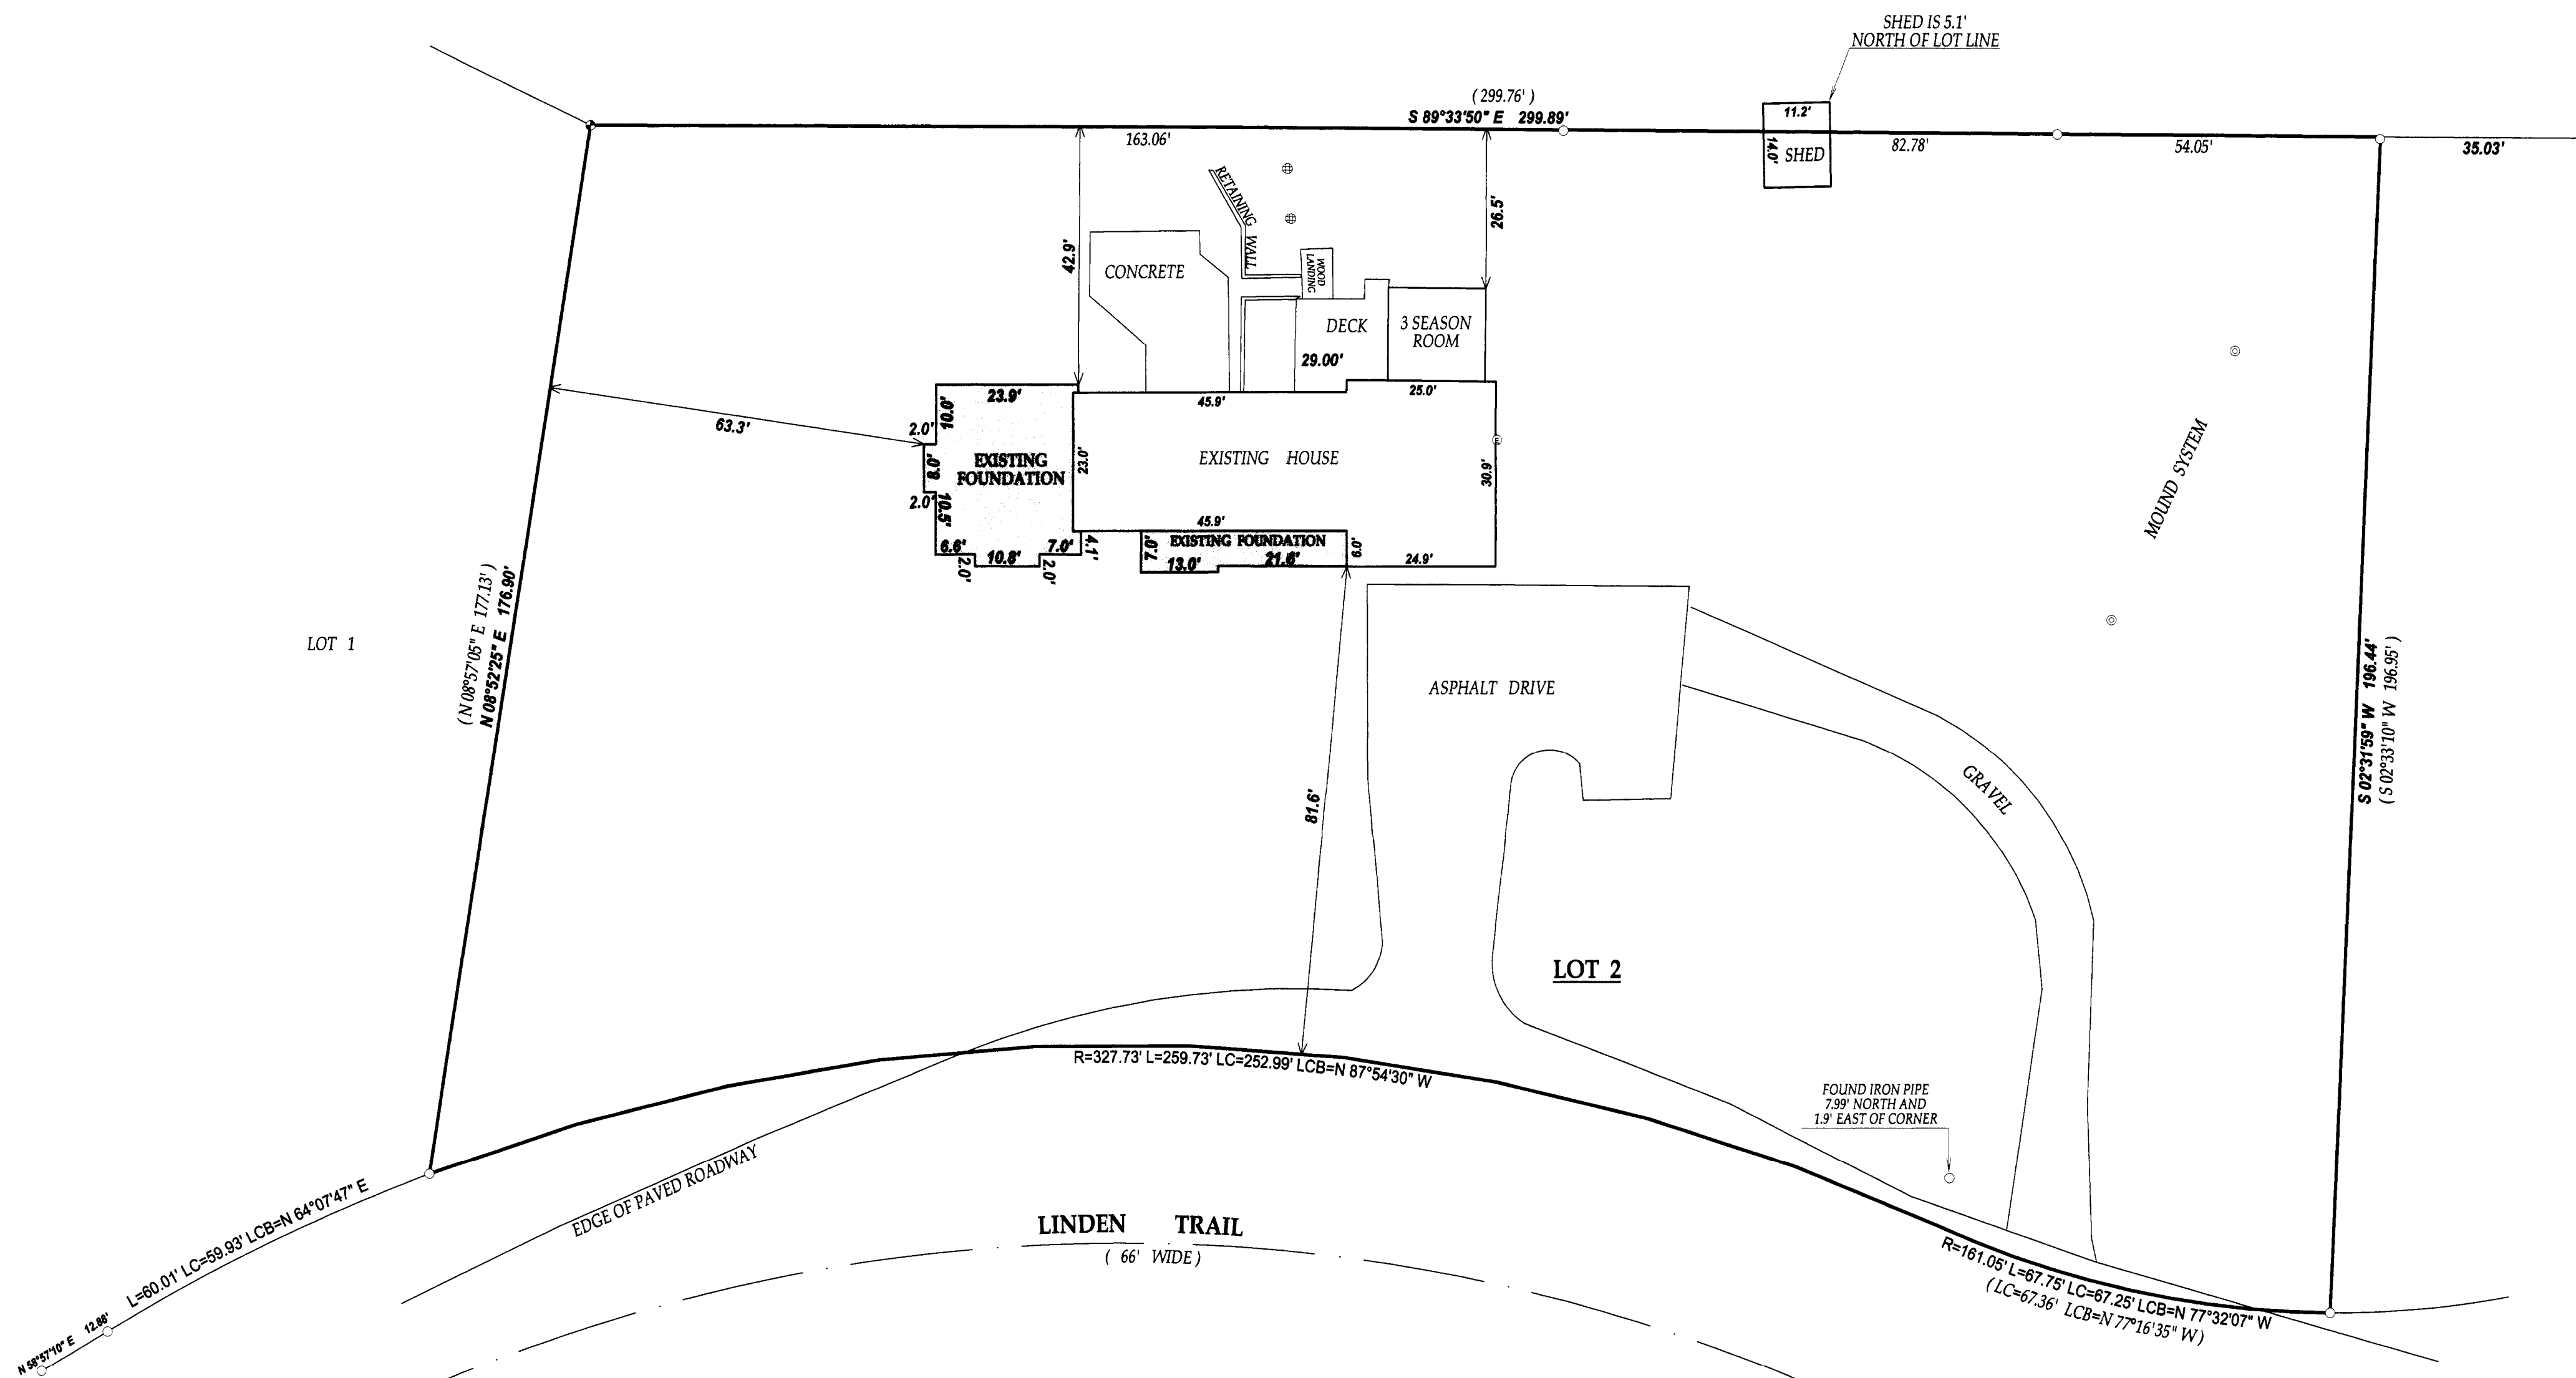


○ FOUND IRON PIPE
● FOUND CONCRETE MONUMENT
⊕ CONCRETE LID
⊙ 4" PVC PIPE
(XX) RECORDED AS
TAX ID # ILVT00002
JOB # 08-063AB

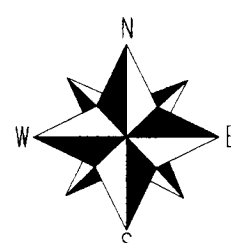

SCALE 1"=20'

This survey is made for the exclusive use of the present owners of the property, and also those who purchase, mortgage, or insure the title thereto within one (1) year from date hereof; and as to them I warrant the accuracy of said survey map.


JOHN KROTT S - 2258
Wisconsin Registered Land Surveyor
(original if signed in red)

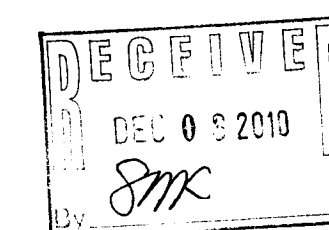

117 3258