

PREPARED FOR  
RONALD LEMKE  
786 TIMBER RIDGE  
FONTANA WI. 53125

## PLAT OF SURVEY


-OF-

LOTS 5 THRU 10 IN BLOCK 5, LAKE VIEW PARK,  
LOCATED IN THE NORTHEAST 1/4 OF SECTION 16  
TOWN 1 NORTH, RANGE 17 EAST, WALWORTH  
COUNTY, WISCONSIN.



KROTT SURVEYING INC.

N3705 WILLOW BEND LANE  
LAKE GENEVA WI. 53147  
PHONE # (262)248-3697  
FAX # (262)249-0639

### C.L. ORLANDO DRIVE (50' WIDE PLATTED AS OAK DRIVE)

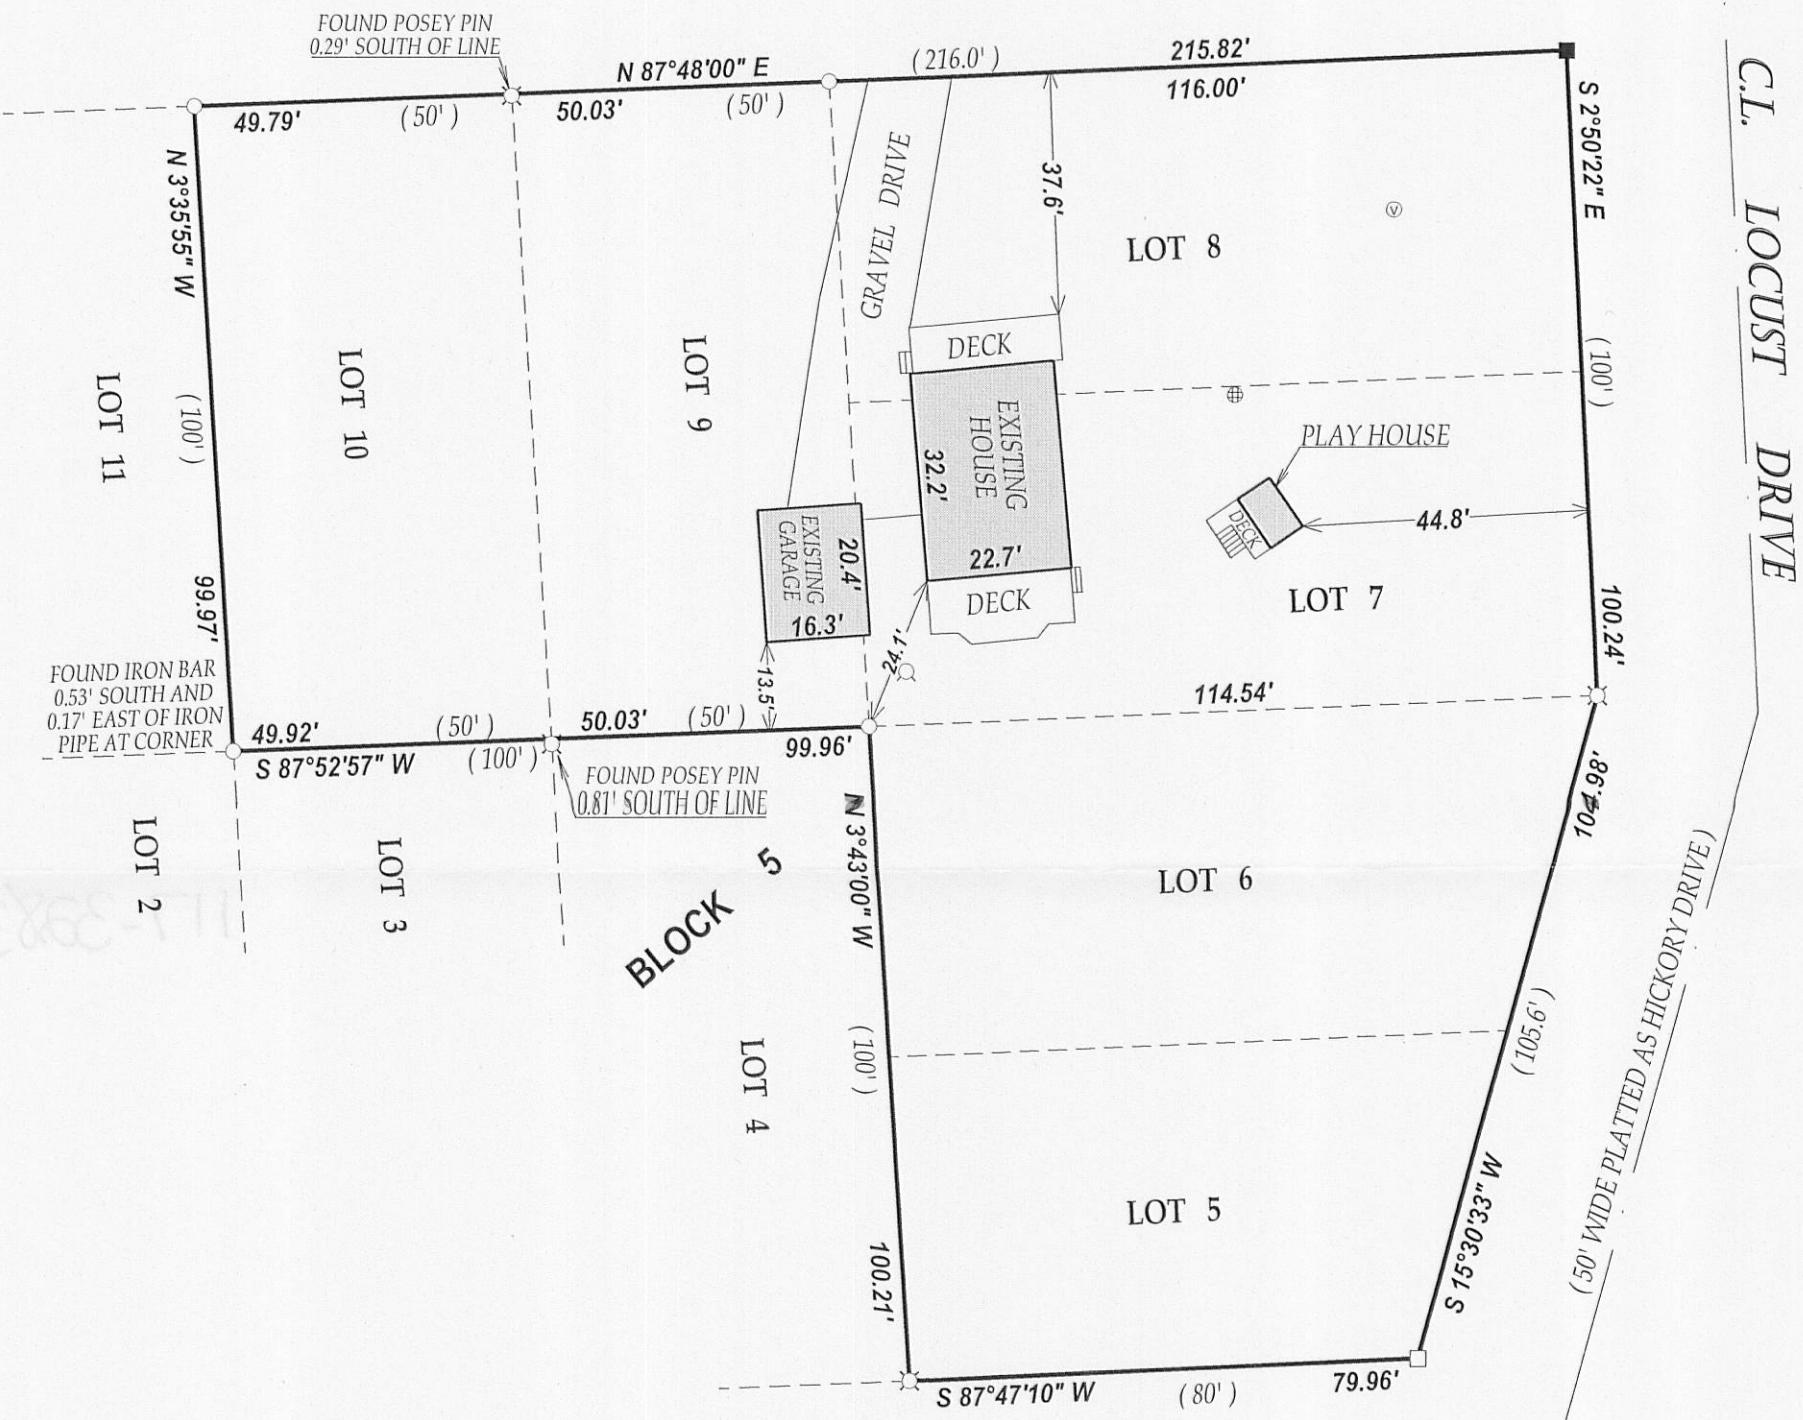

### C.L. PARKER DRIVE (50' WIDE PLATTED AS PARK DRIVE)

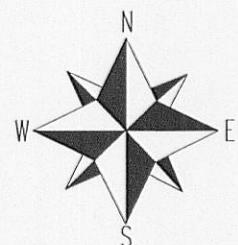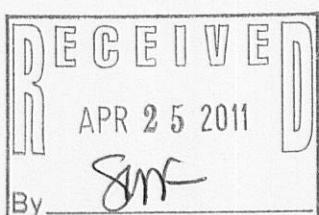


SCALE 1" = 30'

I have surveyed the above-described property and the above map is a true representation thereof and shows the size and location of the property, its exterior boundaries, the location and dimensions of all structures thereon, fences apparent easements and roadways and visible encroachments, if any.

This survey is made for the exclusive use of the present owners of the property, and also those who purchase, mortgage, or insure the title thereto within one (1) year from date hereof; and as to them I warrant the accuracy of said survey map.

(XX) **RECORDED AS**  
TAX ID # ILVP00027B & 27C  
JOB # 11-051

NOTE: BEARINGS ARE REFERENCED TO THE RECORD PLAT

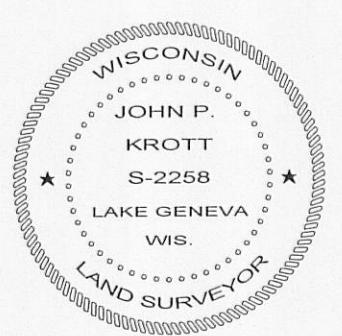

DATED THIS 13th DAY OF APRIL 2011.

*John P. Krott*  
JOHN KROTT S-2258  
Wisconsin Registered Land Surveyor  
(original if signed in red)