
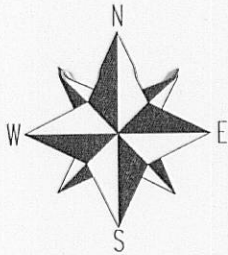
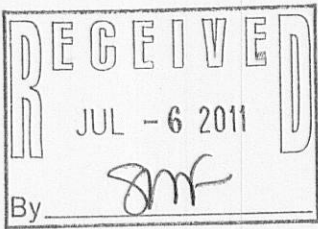


PREPARED FOR  
JOHN TISDALL  
SHOREWEST REALTORS  
623 MAIN ST.  
LAKE GENEVA WI 53147


PLAT OF SURVEY

KROTT SURVEYING INC.  
N3705 WILLOW BEND LANE  
LAKE GENEVA WI. 53147  
PHONE # (262)248-3697  
FAX # (262)249-0639

- OF -  
LOTS 21 AND 23 OF LAKE GENEVA CLUB, A SUBDIVISION  
LOCATED IN LOT NO. 3 OF THE NORTH 1/2 OF FRACTIONAL  
SECTION 18, TOWN 1 NORTH, RANGE 17 EAST, WALWORTH  
COUNTY, WISCONSIN.

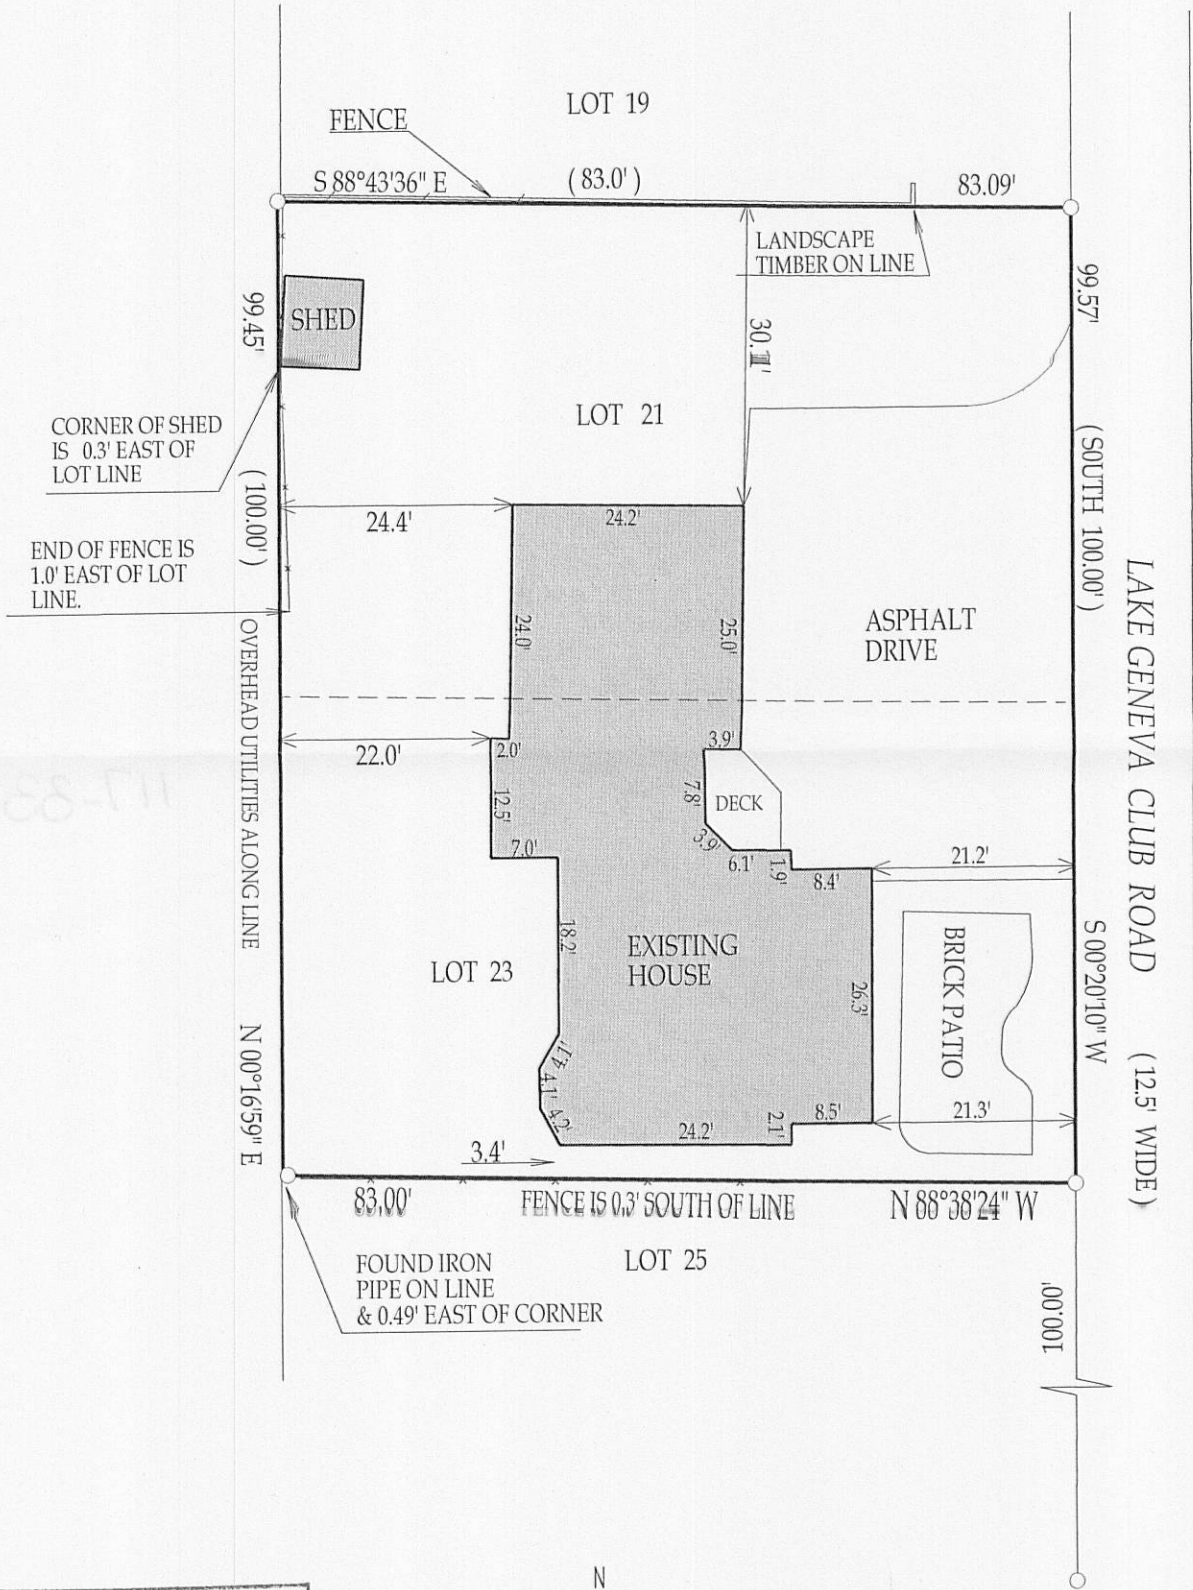


SCALE 1" = 20'

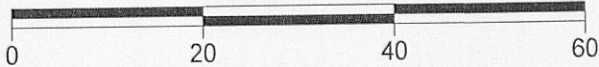

I have surveyed the above-described property and the above map is a true representation thereof and shows the size and location of the property, its exterior boundaries, the location and dimensions of all structures thereon, fences apparent easements and roadways and visible encroachments, if any.

This survey is made for the exclusive use of the present owners of the property, and also those who purchase, mortgage, or insure the title thereto within one (1) year from date hereof; and as to them I warrant the accuracy of said survey map.

NOTE: BEARINGS REFRENCED TO PREVIOUS SURVEY RECORDS.

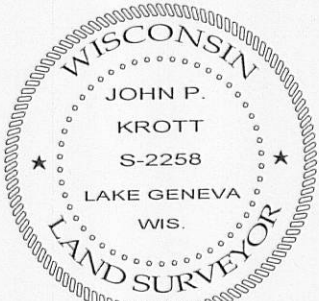

DATED THIS 17th, DAY OF MAY, 2006

*John P. Krott*

JOHN KROTT S - 2258  
Wisconsin Registered Land Surveyor  
(original if signed in red)

LEGEND

○ FOUND IRON PIPE

(xx) RECORDED AS  
TAX ID # ILGC00021

JOB # 06-482UD

117-3310