

PREPARED FOR:
DAVID CURRY
GENEVA LAKE FRONT REALTY, LLC
49 WEST GENEVA ST.
WILLIAMS BAY, WI 53191


PLAT OF SURVEY

-OF-

UNIT 2 OF ESTATES OF BLACK POINT, A CONDOMINIUM LOCATED
IN SECTION 8, TOWN 1 NORTH, RANGE 17 EAST, WALWORTH COUNTY, WISCONSIN.

KROTT SURVEYING INC.
N3705 WILLOW BEND LANE
LAKE GENEVA WI 53147
PHONE # (262)248-3697
FAX # (262)249-0639

GENEVA LAKE

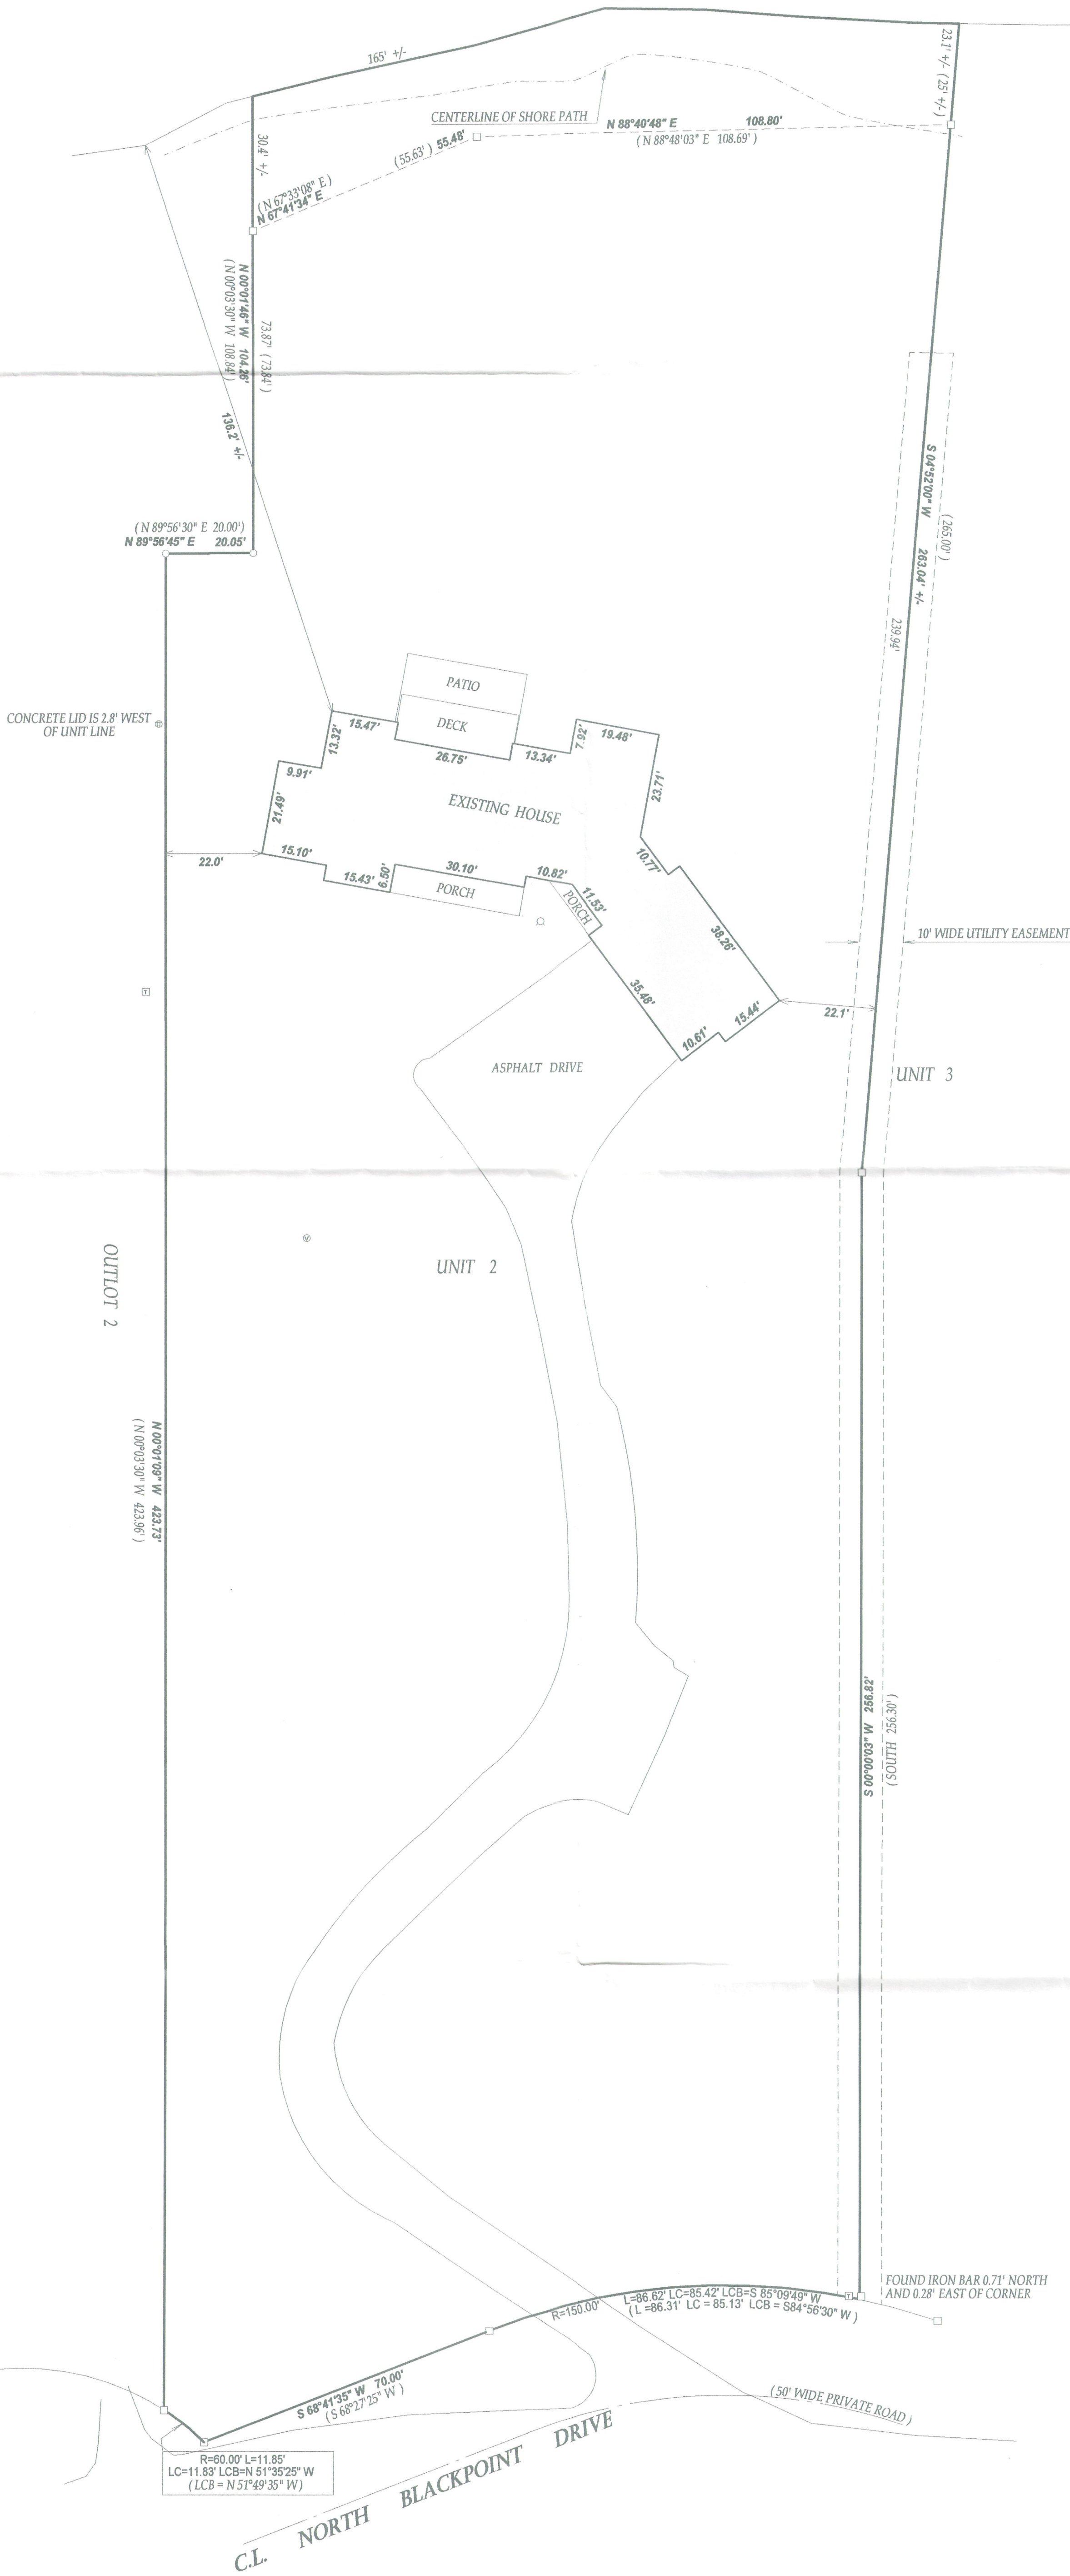


LEGEND

- FOUND IRON PIPE
- FOUND IRON BAR
- SET IRON BAR
- ⊕ CONCRETE LID
- ⊙ VENT
- WELL
- TRANSFORMER
- ⊗ RECORDED AS

JOB # 08-152UD2011


TAX ID # 1BC00002

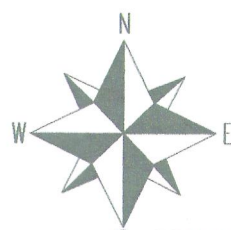

SCALE 1"=20'


0 20 40 60 80

"I hereby certify that I have surveyed the above described property and that the above map is a true representation thereof and shows the size and location of all visible structures, apparent easements and encroachments if any."
This survey is made for the present owners of the property, and those who purchase, mortgage, or guarantee the title thereto, within one year from the date hereof.

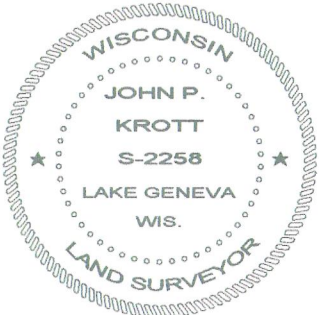

DATE OF LAST REVISION: 11/16/2011
DATED THIS THE 10th DAY OF JULY 2008.

JOHN KROTT S-2258
Wisconsin Registered Land Surveyor
(original if signed in red)

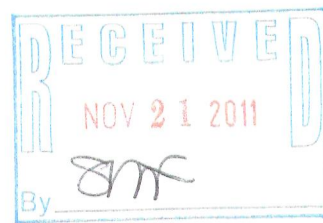

117-3348