


PLAT OF SURVEY

LOT 1 AND LOT 2 OF CERTIFIED SURVEY MAP NO. 1519,
FORMERLY LOT 1 AND PART OF LOT 21 OF OAK SHORES
SUBDIVISION LOCATED IN PART OF THE NORTHWEST
1/4 OF SECTION 18, TOWN 1 NORTH, RANGE 17 EAST,
LINN TOWNSHIP, WALWORTH COUNTY, WISCONSIN.

ORDERED BY: DAVID CURRY
GENEVA LAKEFRONT REALTY
49 WEST GENEVA STREET
WILLIAMS BAY, WI 53191

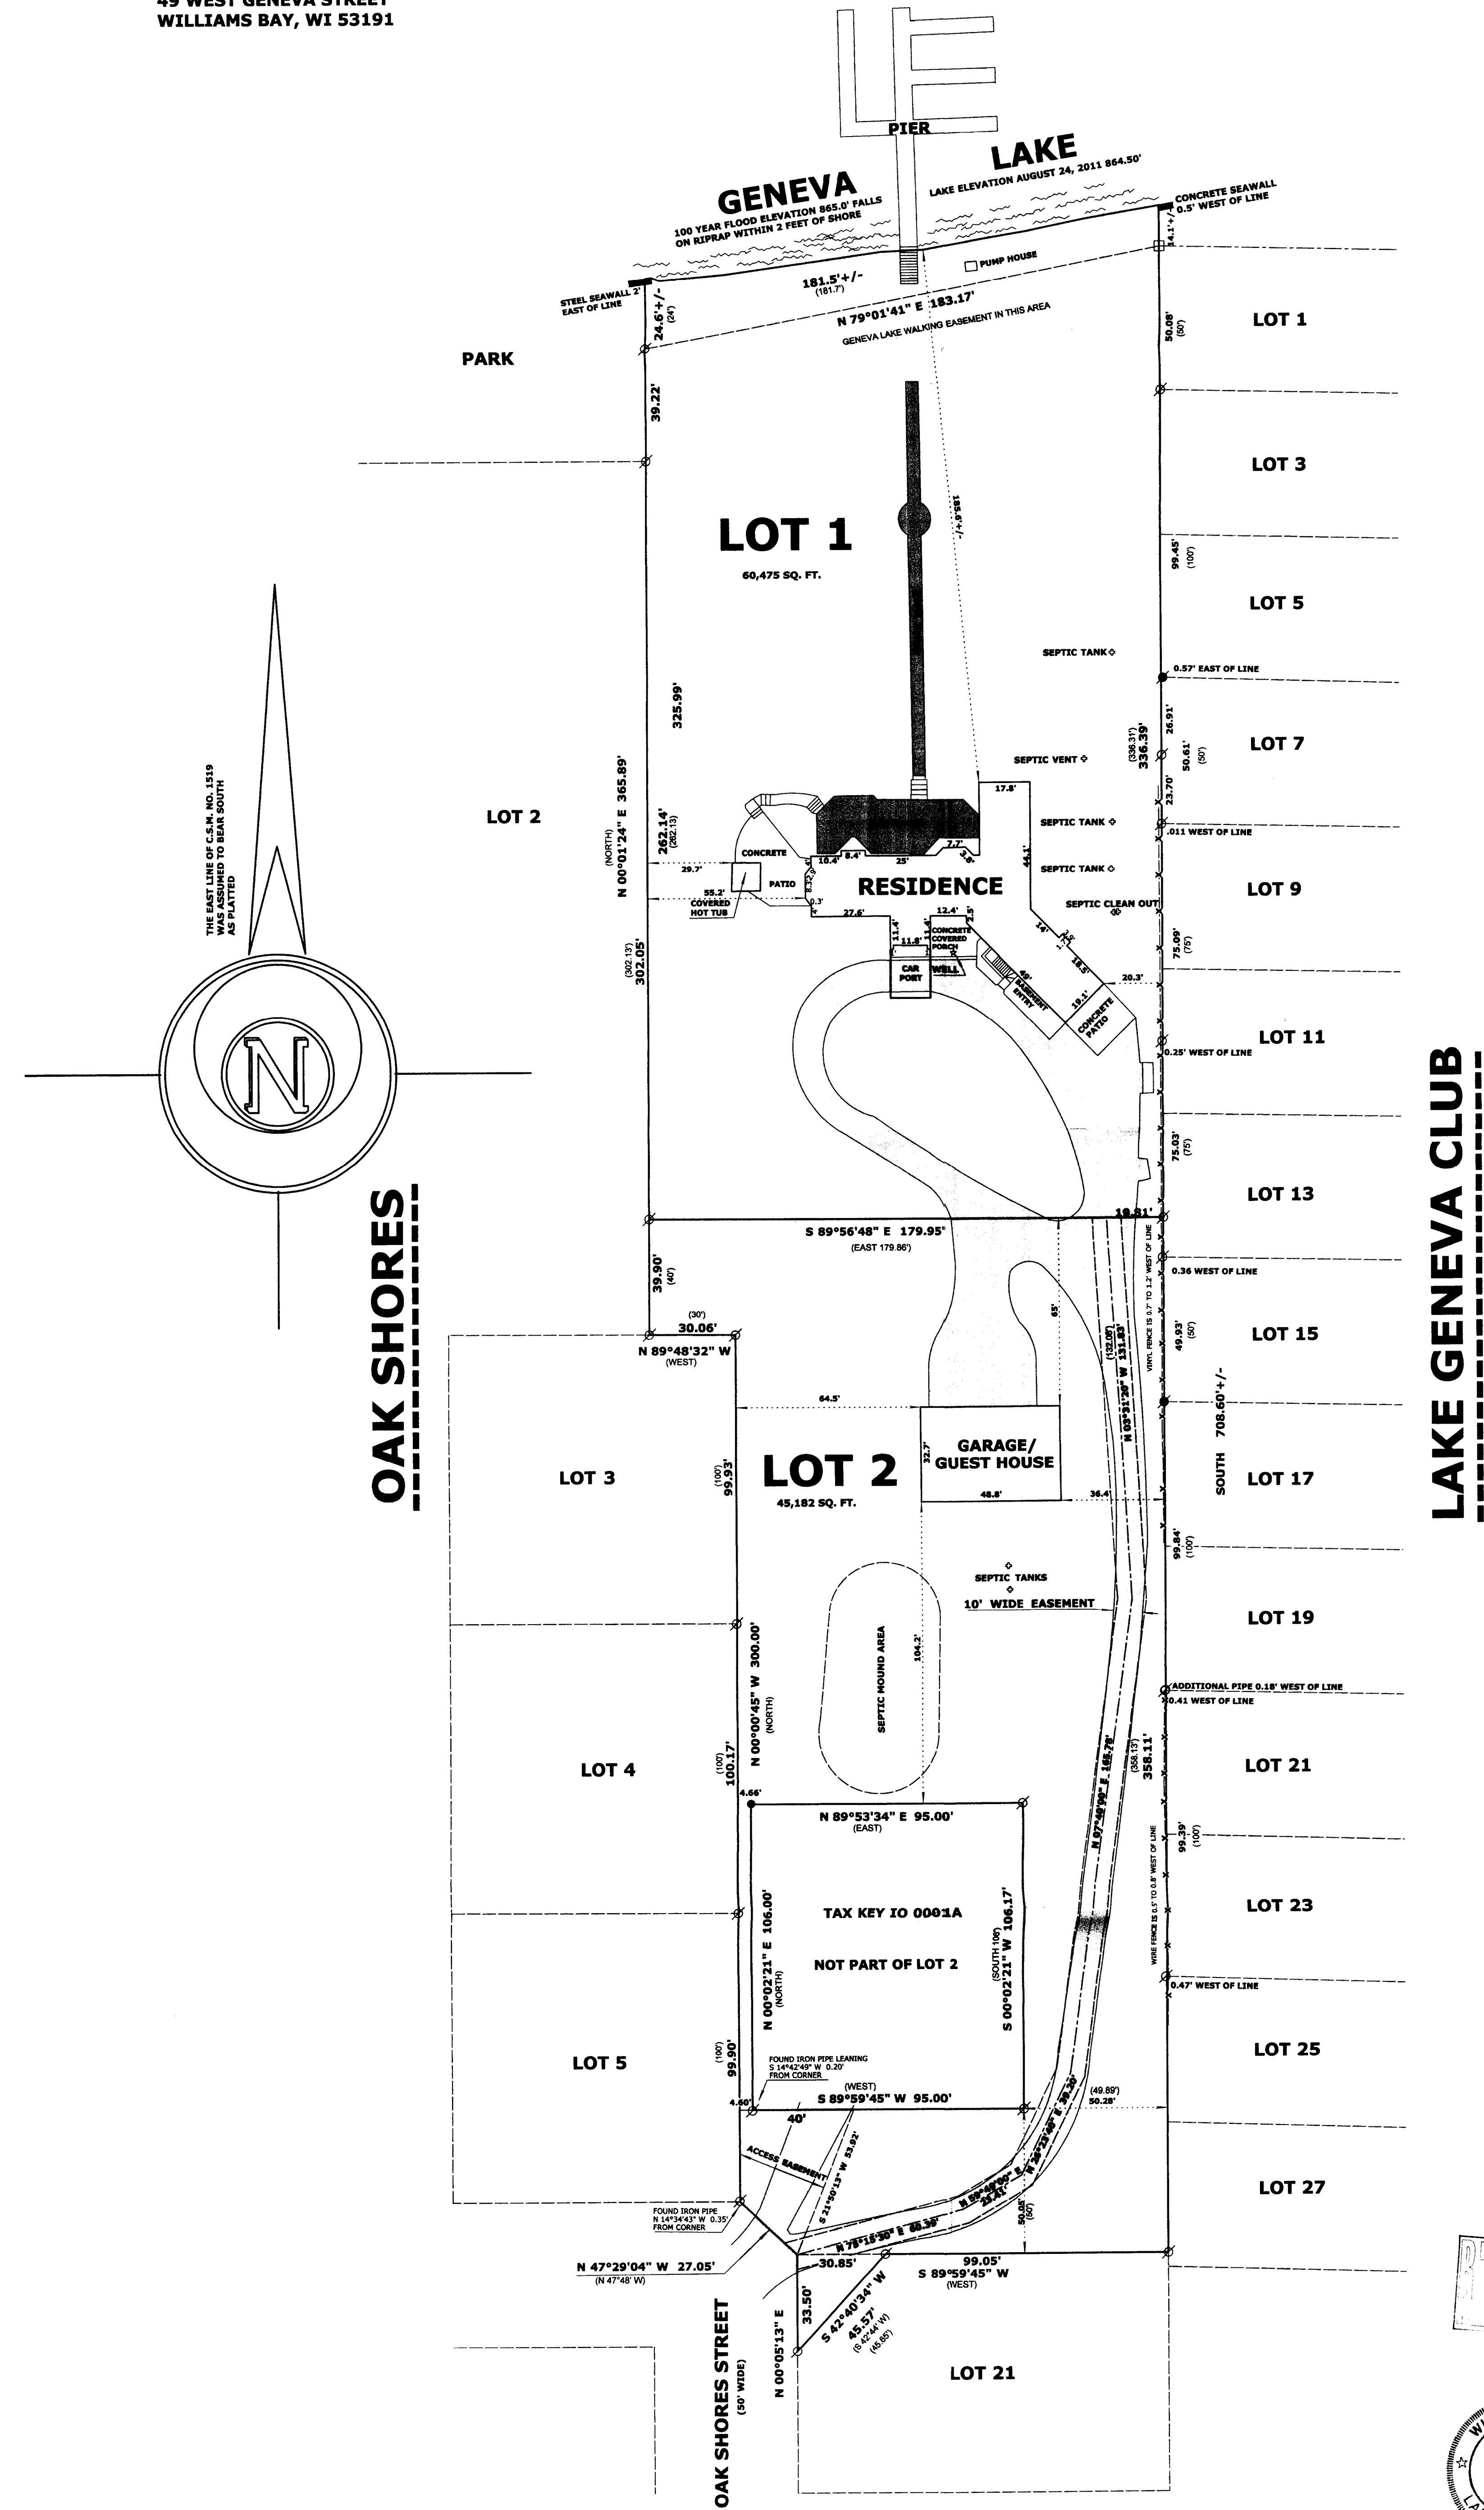

LEGEND

BLACKTOP DRIVE

FOUND IRON PIPE

FOUND IRON ROD

FOUND CONCRETE MONUMENT

SET IRON ROD, 24" LONG, WEIGHING 1.5 LBS./LINEAL FT., 3/4" DIA.

RECORDED AS DIMENSION

EXISTING FENCE

SCALE: 1 INCH = 30 FEET

"I hereby certify that the above described property has been surveyed by me or under my direction and that the above map is a true representation thereof and shows the size and location of the property, its exterior boundaries, the location of all visible structures and dimensions of all principal buildings thereon, boundary fences, apparent easements, roadways and visible encroachments, if any."

"This survey is made for the use of the present owners of the property, and also those who purchase, mortgage, or guarantee the title thereto within one year from date hereof."

Mark L. Miritz

MARK L. MIRITZ

S-2582

WHITWATER, WI

LAND SURVEYOR

MARK L. MIRITZ

WISCONSIN REGISTERED

LAND SURVEYOR S-2582

DATE: AUGUST 26, 2011 JOB NO. 11.811