
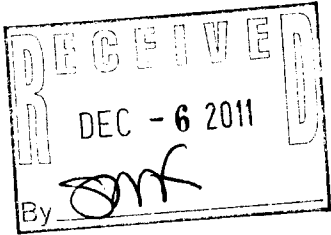


PLAT OF SURVEY

LOTS 11,12 AND 13 IN BLOCK 6 OF WOODDALE ADDITION
OF TOWNSHIP 1 NORTH, RANGE 17 EAST, TOWN OF LINN,
WALWORTH COUNTY, WISCONSIN

ORDERED BY: MICHAEL & PEGGY BENTLEY
KEEFE REAL ESTATE
751 GENEVA PARKWAY
LAKE GENEVA, WI 53147

SITE ADDRESS: N1765 WOODDALE DRIVE

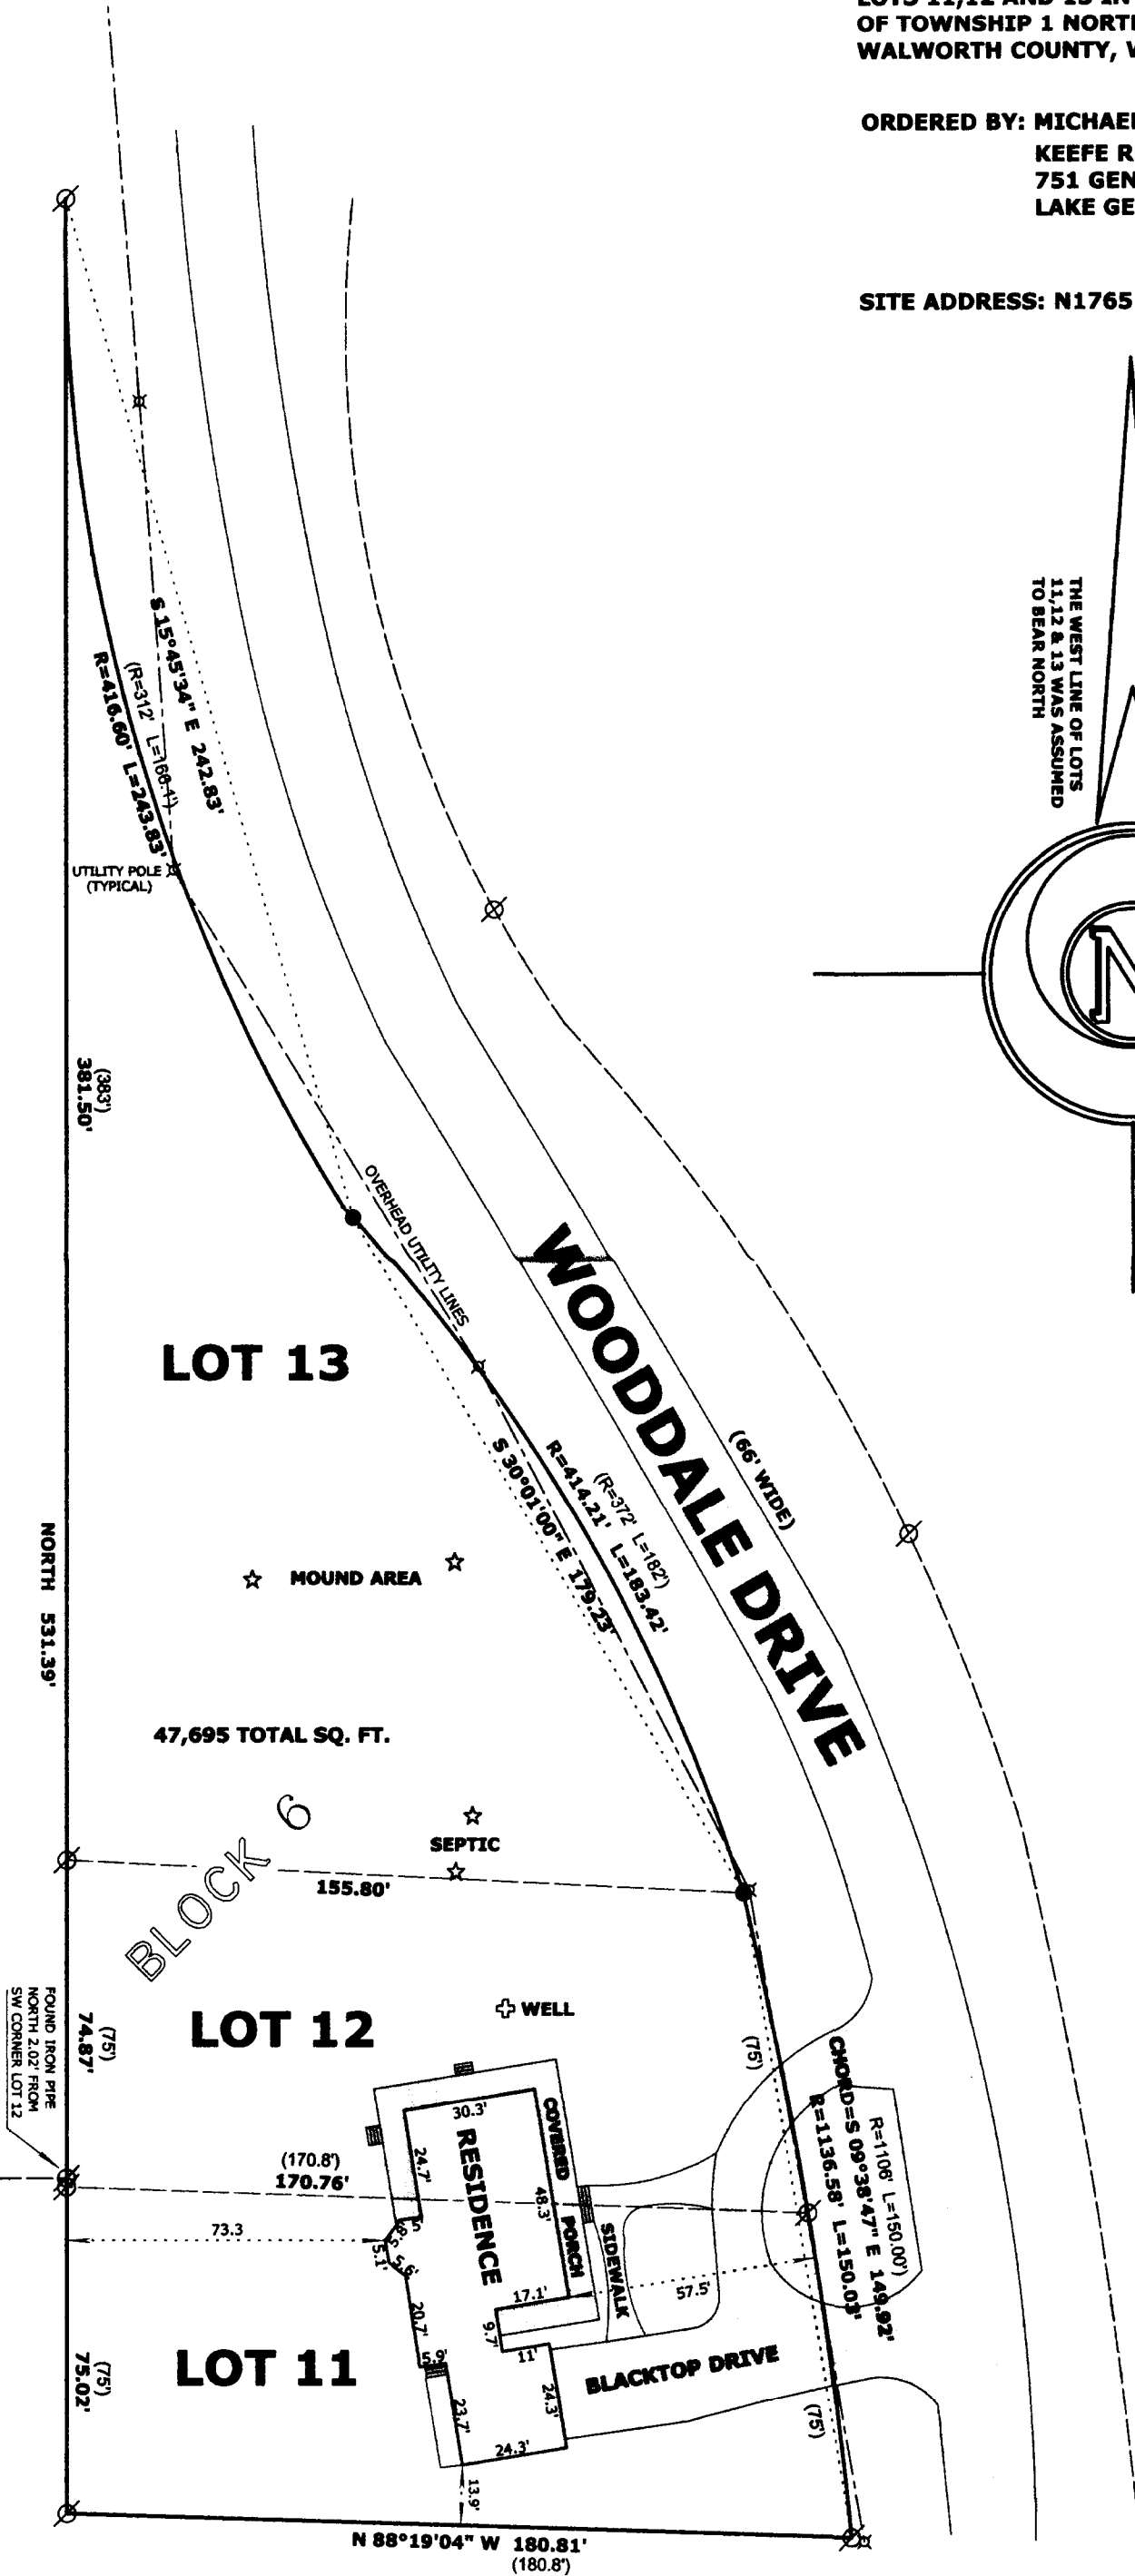

SURVEYOR'S NOTE:
THE CURVE DATA FOR LOT 13 ON THE
ORIGINAL PLAT HAS ERRORS AND ALL
OF THE CURVES ON THE PLAT IS
MISSING CRITICAL INFORMATION
FROM LOT CORNERS TO THE BEGINNING
OF CURVES. THEREFORE, FIELD EVIDENCE
WAS USED TO CREATE THE EASTERLY
LINE OF LOT 13.



LEGEND

- FOUND IRON PIPE
- SET IRON ROD, 18" LONG, WEIGHING 1.5 LBS./LINEAL FT., 3/4" DIA.
- RECORDED AS DIMENSION

SCALE: 1 INCH = 40 FEET

"I hereby certify that the above described property has been surveyed by me or under my direction and that the above map is a true representation thereof and shows the size and location of the property, its exterior boundaries, the location of all visible structures and dimensions of all principal buildings thereon, boundary fences, apparent easements, roadways and visible encroachments, if any."
"This survey is made for the use of the present owners of the property, and also those who purchase, mortgage, or guarantee the title thereto within one year from date hereof."

Mark L. Miritz
MARK L. MIRITZ
WISCONSIN REGISTERED
LAND SURVEYOR S-2582
DATE: JULY 11, 2011 JOB NO. 11.608

IW-55B

117-3362