


PLAT OF SURVEY -OF-



LOT 22, IN BLOCK 3, IN LAKE GENEVA TERRACE, ACCORDING TO THE RECORDED PLAT THEREOF.
SAID LAND BEING IN THE TOWN OF LINN, COUNTY OF WALWORTH, STATE OF WISCONSIN.

SURVEY ADDRESS: N1616 WASHINGTON AVENUE

SURVEY FOR: HOMESTEAD REALTY

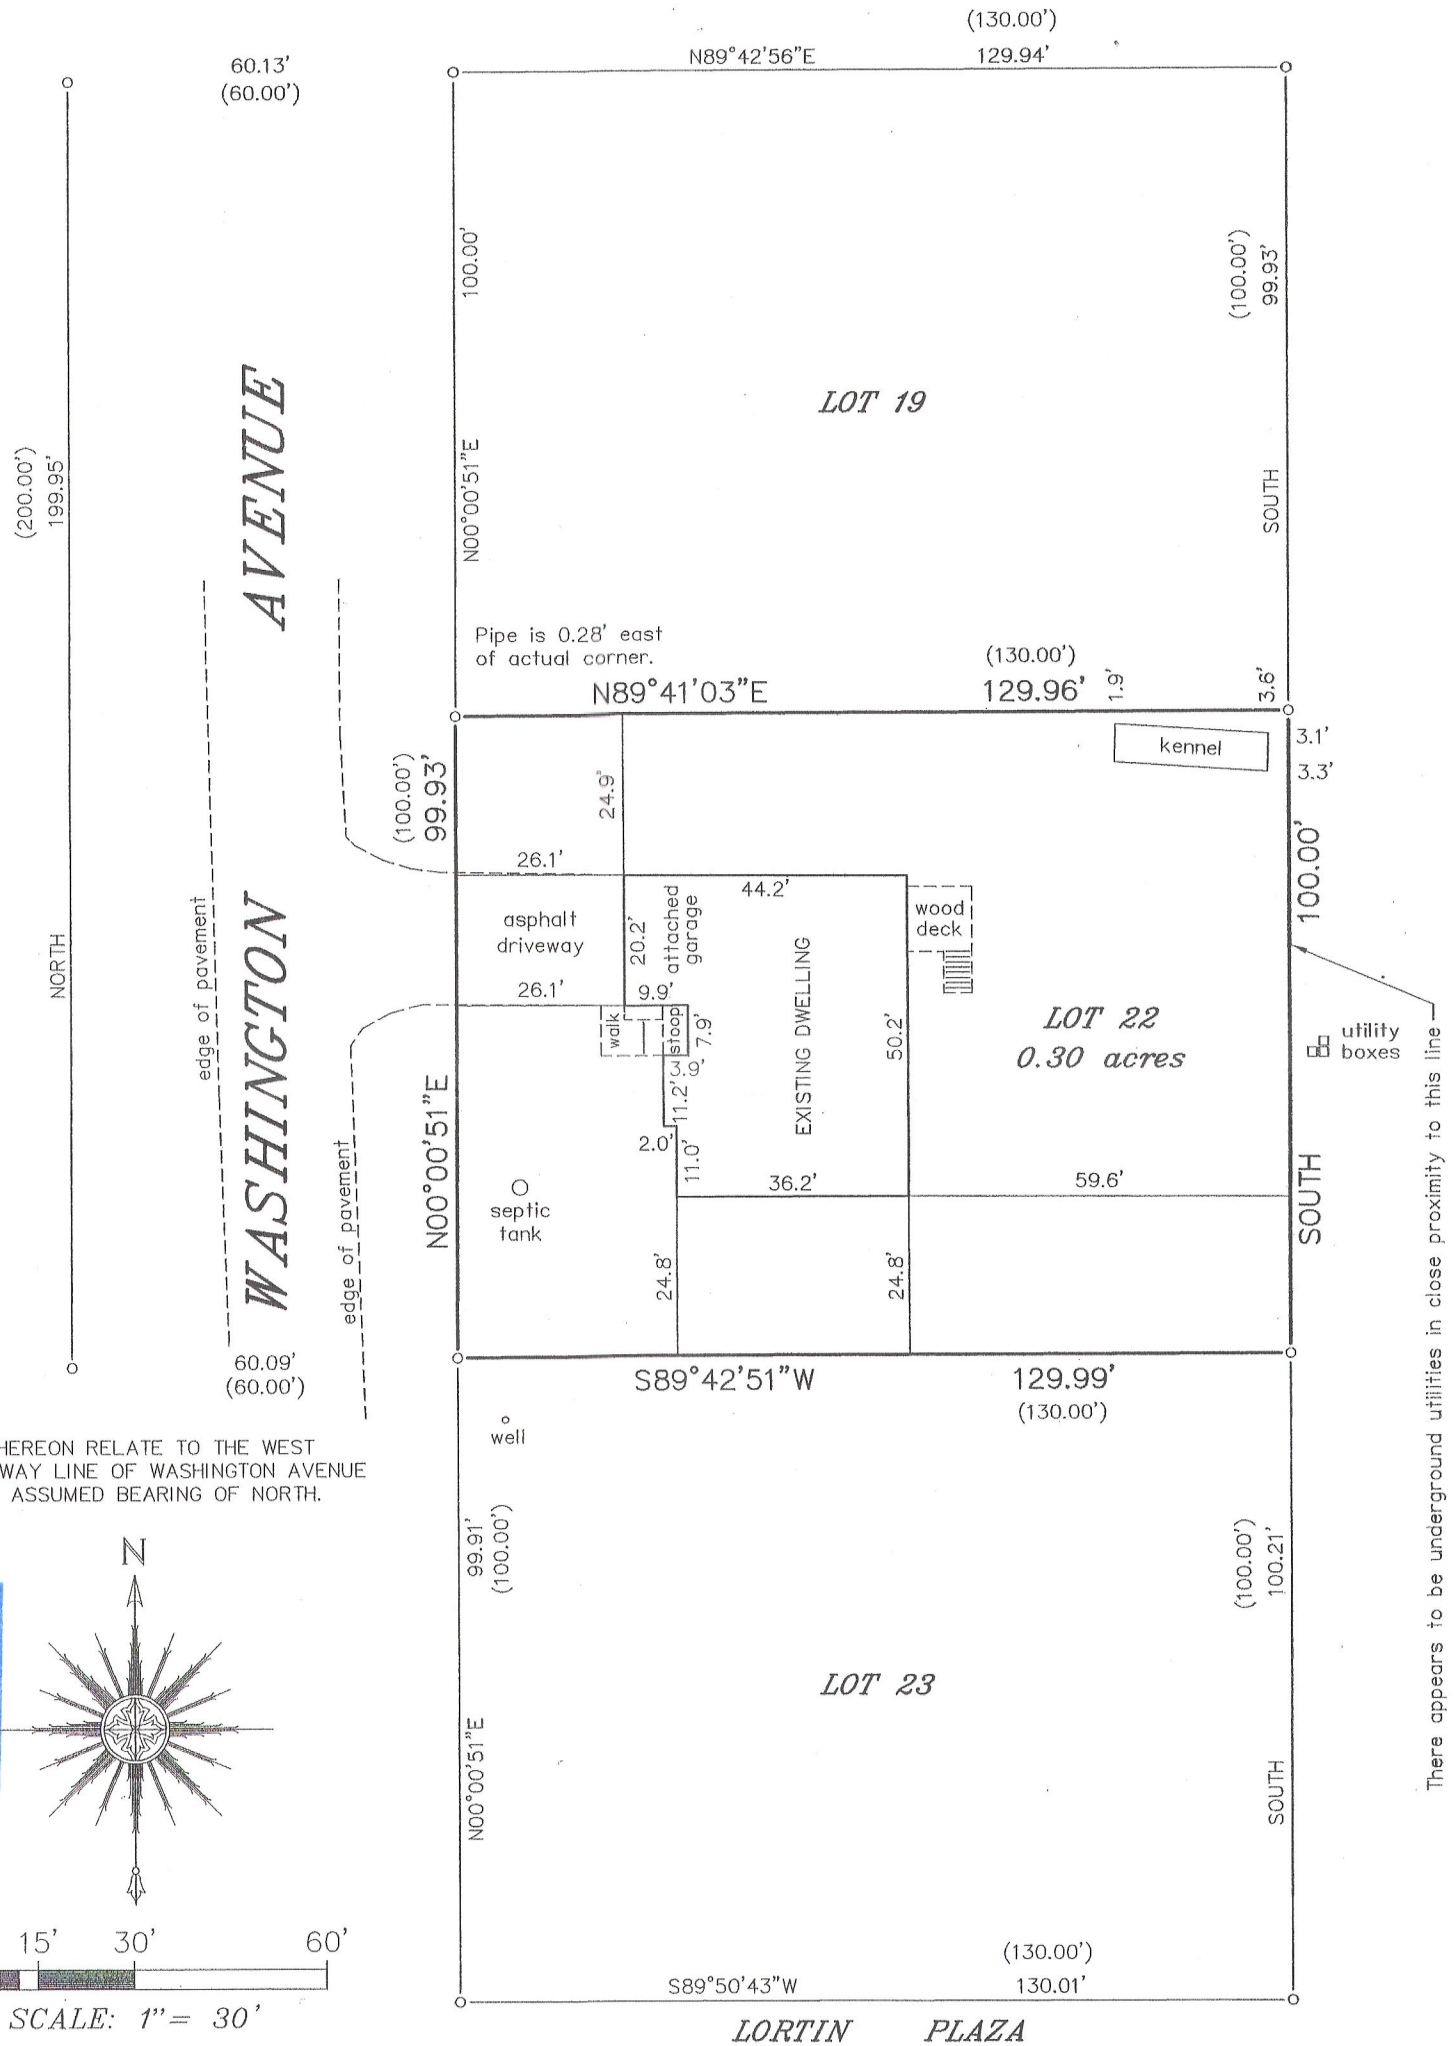


BEARINGS HEREON RELATE TO THE WEST
RIGHT-OF-WAY LINE OF WASHINGTON AVENUE
AS SHOWN. ASSUMED BEARING OF NORTH.

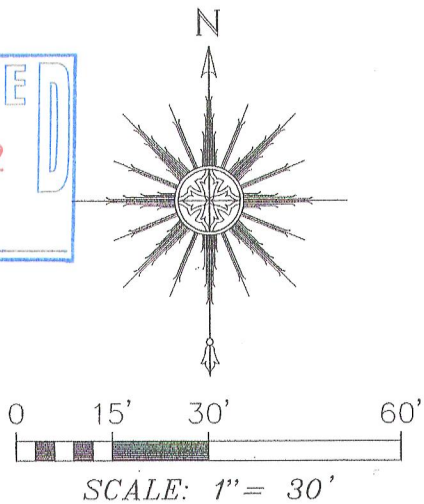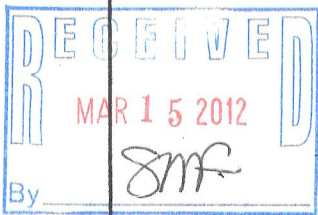

"I HEREBY CERTIFY THAT I HAVE SURVEYED THE ABOVE
DESCRIBED PROPERTY AND THAT THE ABOVE MAP IS A CORRECT
REPRESENTATION THEREOF AND SHOWS THE SIZE AND LOCATION
OF THE PROPERTY, ITS EXTERIOR BOUNDARIES, THE LOCATION
OF ALL VISIBLE STRUCTURES AND DIMENSIONS OF ALL
PRINCIPAL BUILDINGS THEREON, BOUNDARY FENCES, APPARENT
EASEMENTS, ROADWAYS AND ENCROACHMENTS, IF ANY."

"THIS SURVEY IS MADE FOR THE USE OF THE PRESENT OWNERS
OF THE PROPERTY, AND THOSE WHO PURCHASE, MORTGAGE, OR
GUARANTEE THE TITLE THERETO WITHIN ONE YEAR FROM DATE
HEREOF."

SATTER SURVEYING, LLC
LAND SURVEYS, MAPPING AND PLANNING
272 ORIGIN STREET
BURLINGTON, WI 53105
262-661-4239

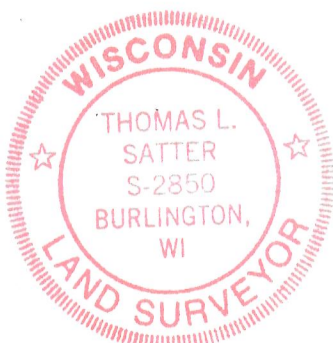

LEGEND

- FOUND IRON PIPE
- () RECORDED AS

Thomas L. Satter
THOMAS L. SATTER S-2850

THIS IS NOT AN ORIGINAL PRINT
UNLESS THIS SEAL IS RED.

FEBRUARY 24, 2012
DATE

021205
JOB NUMBER

ILGT-11

117-3373