


PREPARED FOR
SCHORSCH BUILDERS

PLAT OF SURVEY

- OF -

LOTS 6 AND 7, BLOCK 2 SUNSET HILLS, A SUBDIVISION LOCATED
IN SECTION 4, TOWN 1 NORTH, RANGE 17 EAST OF THE FOURTH
PRINCIPAL MERIDIAN, TOWN OF LINN, COUNTY OF WALWORTH
AND STATE OF WISCONSIN.

PATHFINDER SURVEYING INC.
(formerly)
J.K. SURVEYING INC.
P.O BOX 322
LAKE GENEVA, WI. 53147
WWW.PATHFINDERSURVEYING.NET
262-248-8303

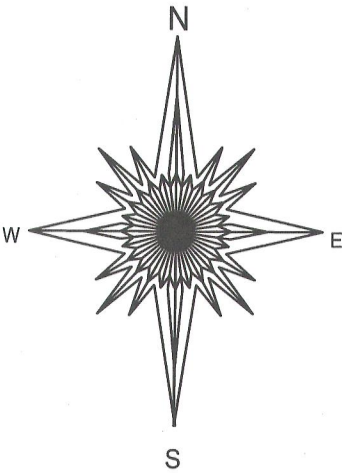

20 0 20 40

BASIS OF BEARING OF THIS PLAT: THE EAST LINE OF
GREENVIEW DRIVE WAS ASSUMED TO BEAR
NORTH/SOUTH.


- () = recorded as
□ = found iron bar
○ = found iron pipe
● = set iron pipe
■ = set iron bar

SCALE 1" = 20'

JOB # 12-13

TAX ID # ISH 00018


GREENVIEW DRIVE " A.K.A. W. MAIN ROAD "

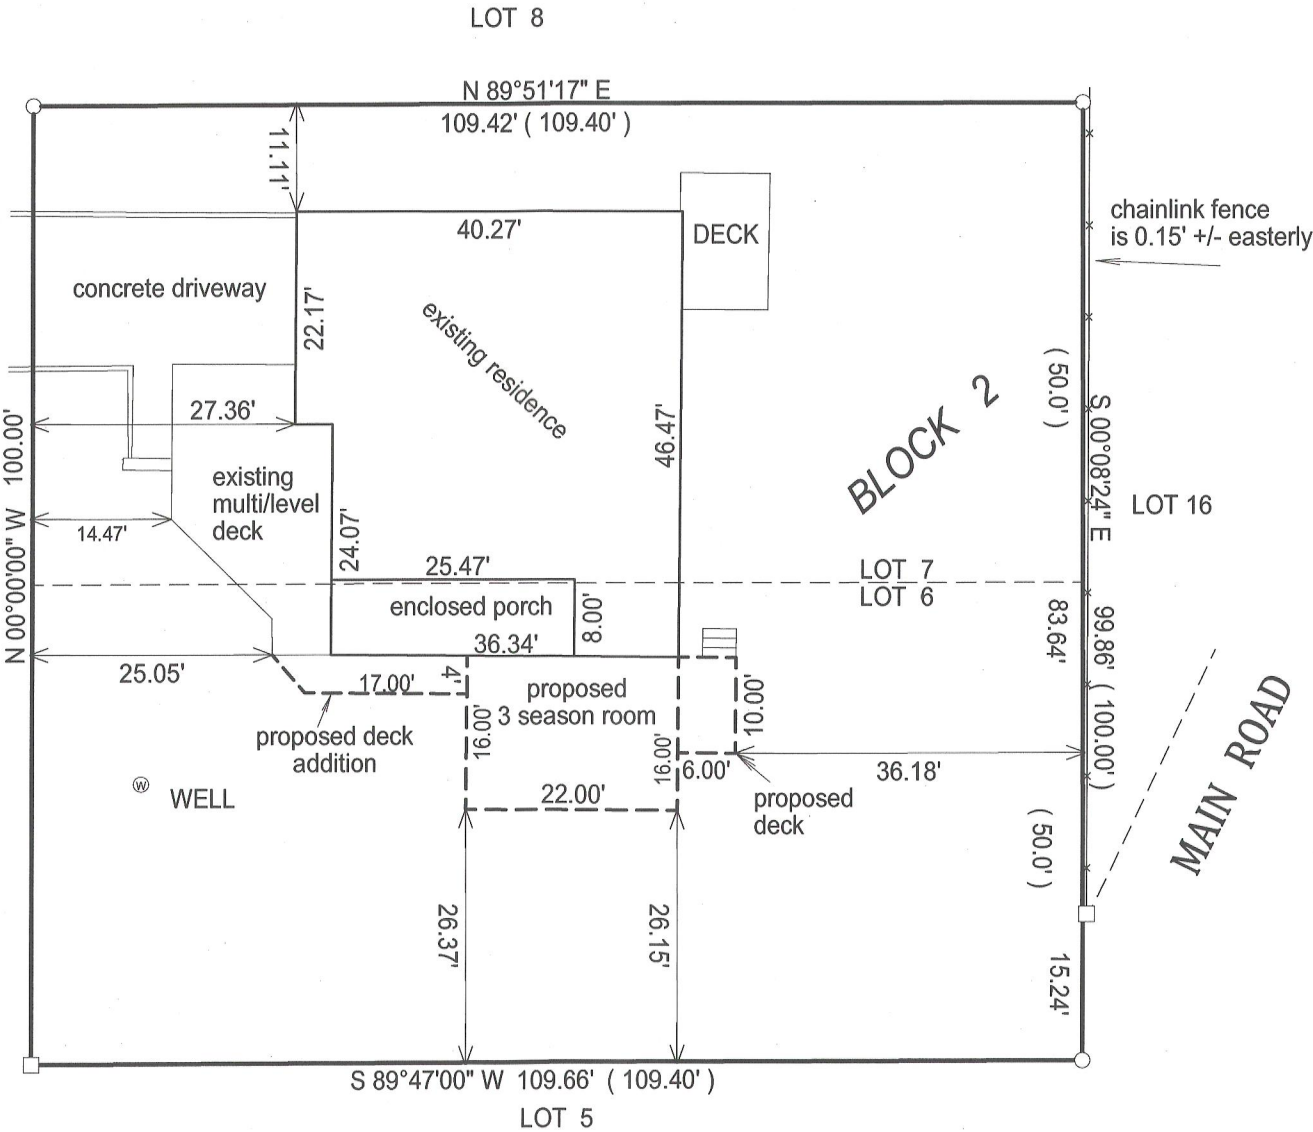

"I hereby certify that I have surveyed the above described property and that the above
map is a true representation of its exterior boundary and shows the size and location of
all visible structures, apparent easements and encroachments if any."

This survey is made for the present owners of the property, and those who
purchase, mortgage, or guarantee the title thereto, within one year from
the date hereof.

DATED THIS 7TH DAY OF FEBRUARY, 2012.

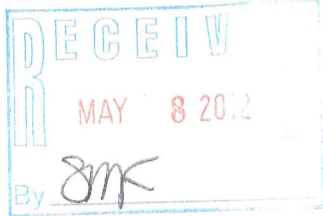

JEFFREY L. KIMPS S - 2436
Wisconsin Registered Land Surveyor
(original if signed in red)

117-3387