


PLAT OF SURVEY

No. 5156

DESCRIPTION: South 125 Ft. of lot No. 1, The Birches Second Addition,
Northwest 1/4 Section 10, Town 1 North, Range 17 East, Walworth County,
Wisconsin.

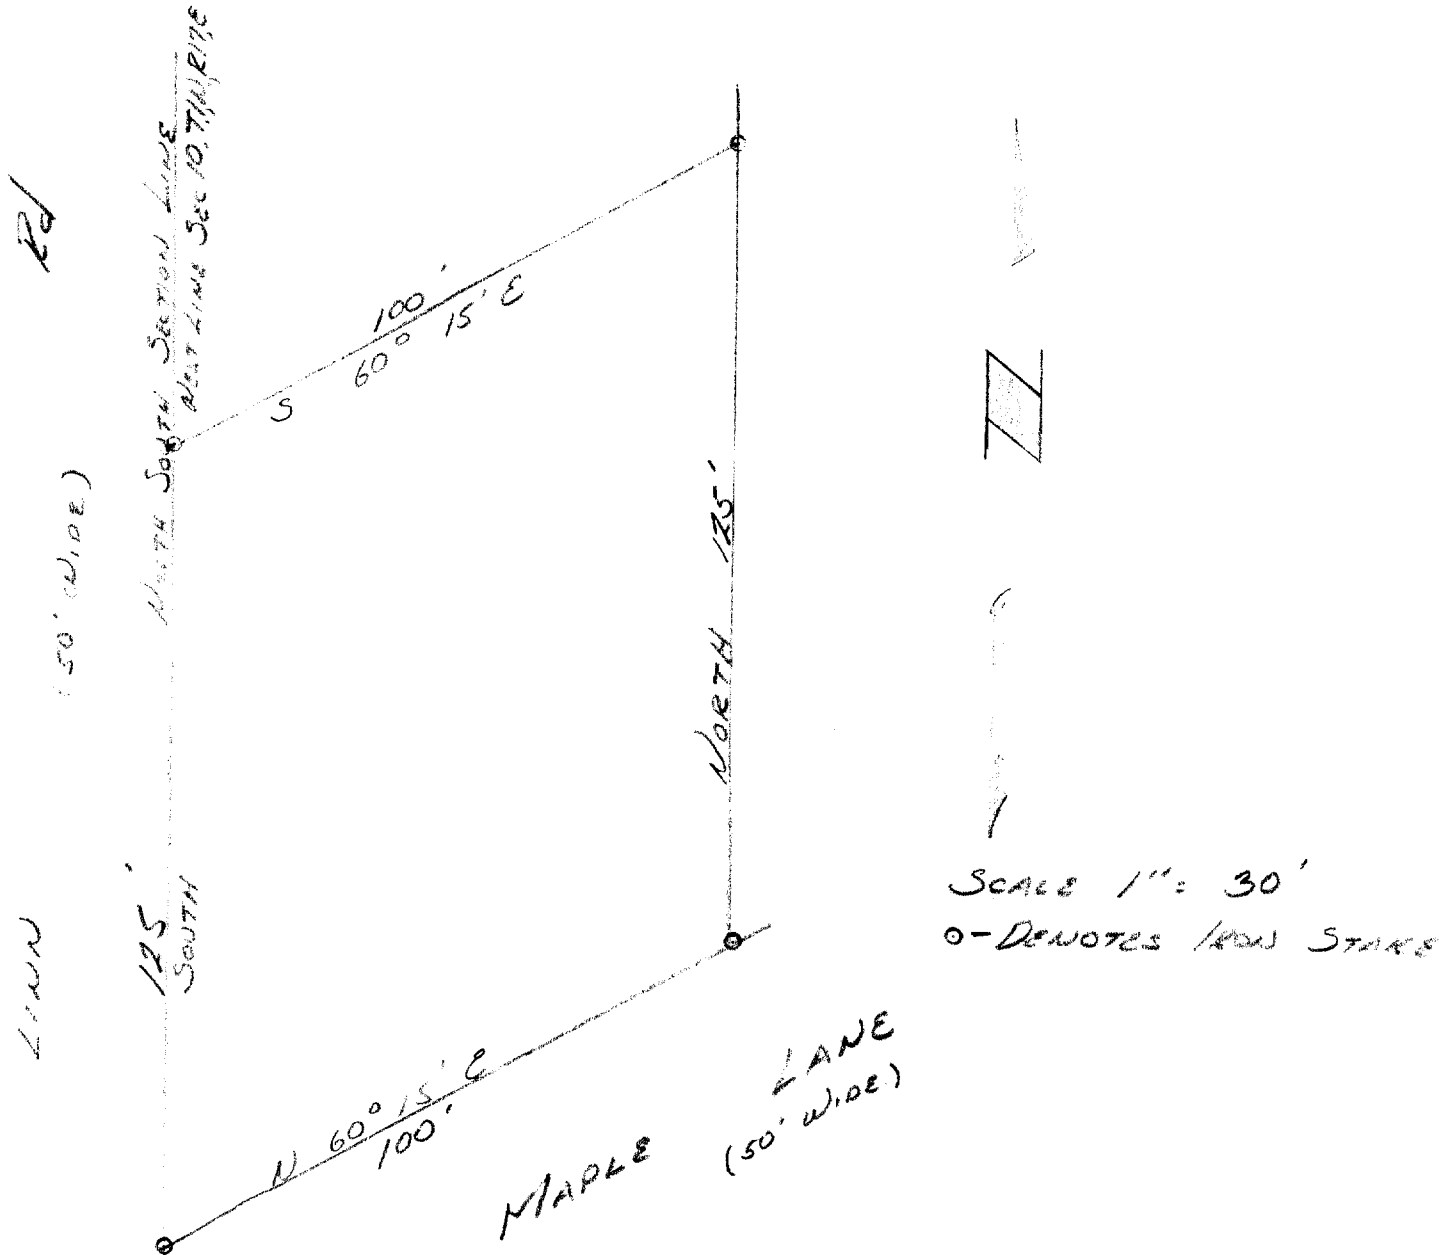

CERTIFICATE: I hereby certify that I have on this 10th day of May, 1956 surveyed the above described property at the request of the owner, and that the above description and drawing are in accordance with the records on file in the register of Deeds office, Walworth County, Wisconsin.

Signed John A. B. A.
Surveyor

Signed James E. Bagl
and Surveyor (272)

