

**LAND-MARK SURVEYING**  
Mark L. Miritz

Wisconsin Registered Land Surveyor S-2582




N9330 Knuteson Drive  
Whitewater, WI 53190  
Phone: (262) 495-3284  
FAX : (262) 495-8421  
LAND-MARKSURVEYING.COM

**PLAT OF SURVEY**

**LOT 4, BLOCK 2, GENEVISTA SUBDIVISION,  
LOCATED IN SECTION 10, TOWN 1 NORTH,  
RANGE 17 EAST, LINN TOWNSHIP, WALWORTH  
COUNTY, WISCONSIN**



**ORDERED BY:**  
**MIKE PFAMMATTER**  
**KEEFE REAL ESTATE**  
**751 GENEVA PARKWAY**  
**LAKE GENEVA, WI. 53147**

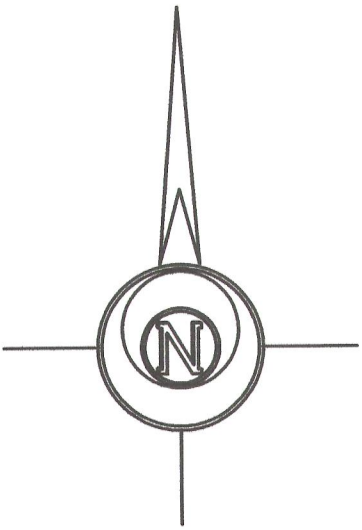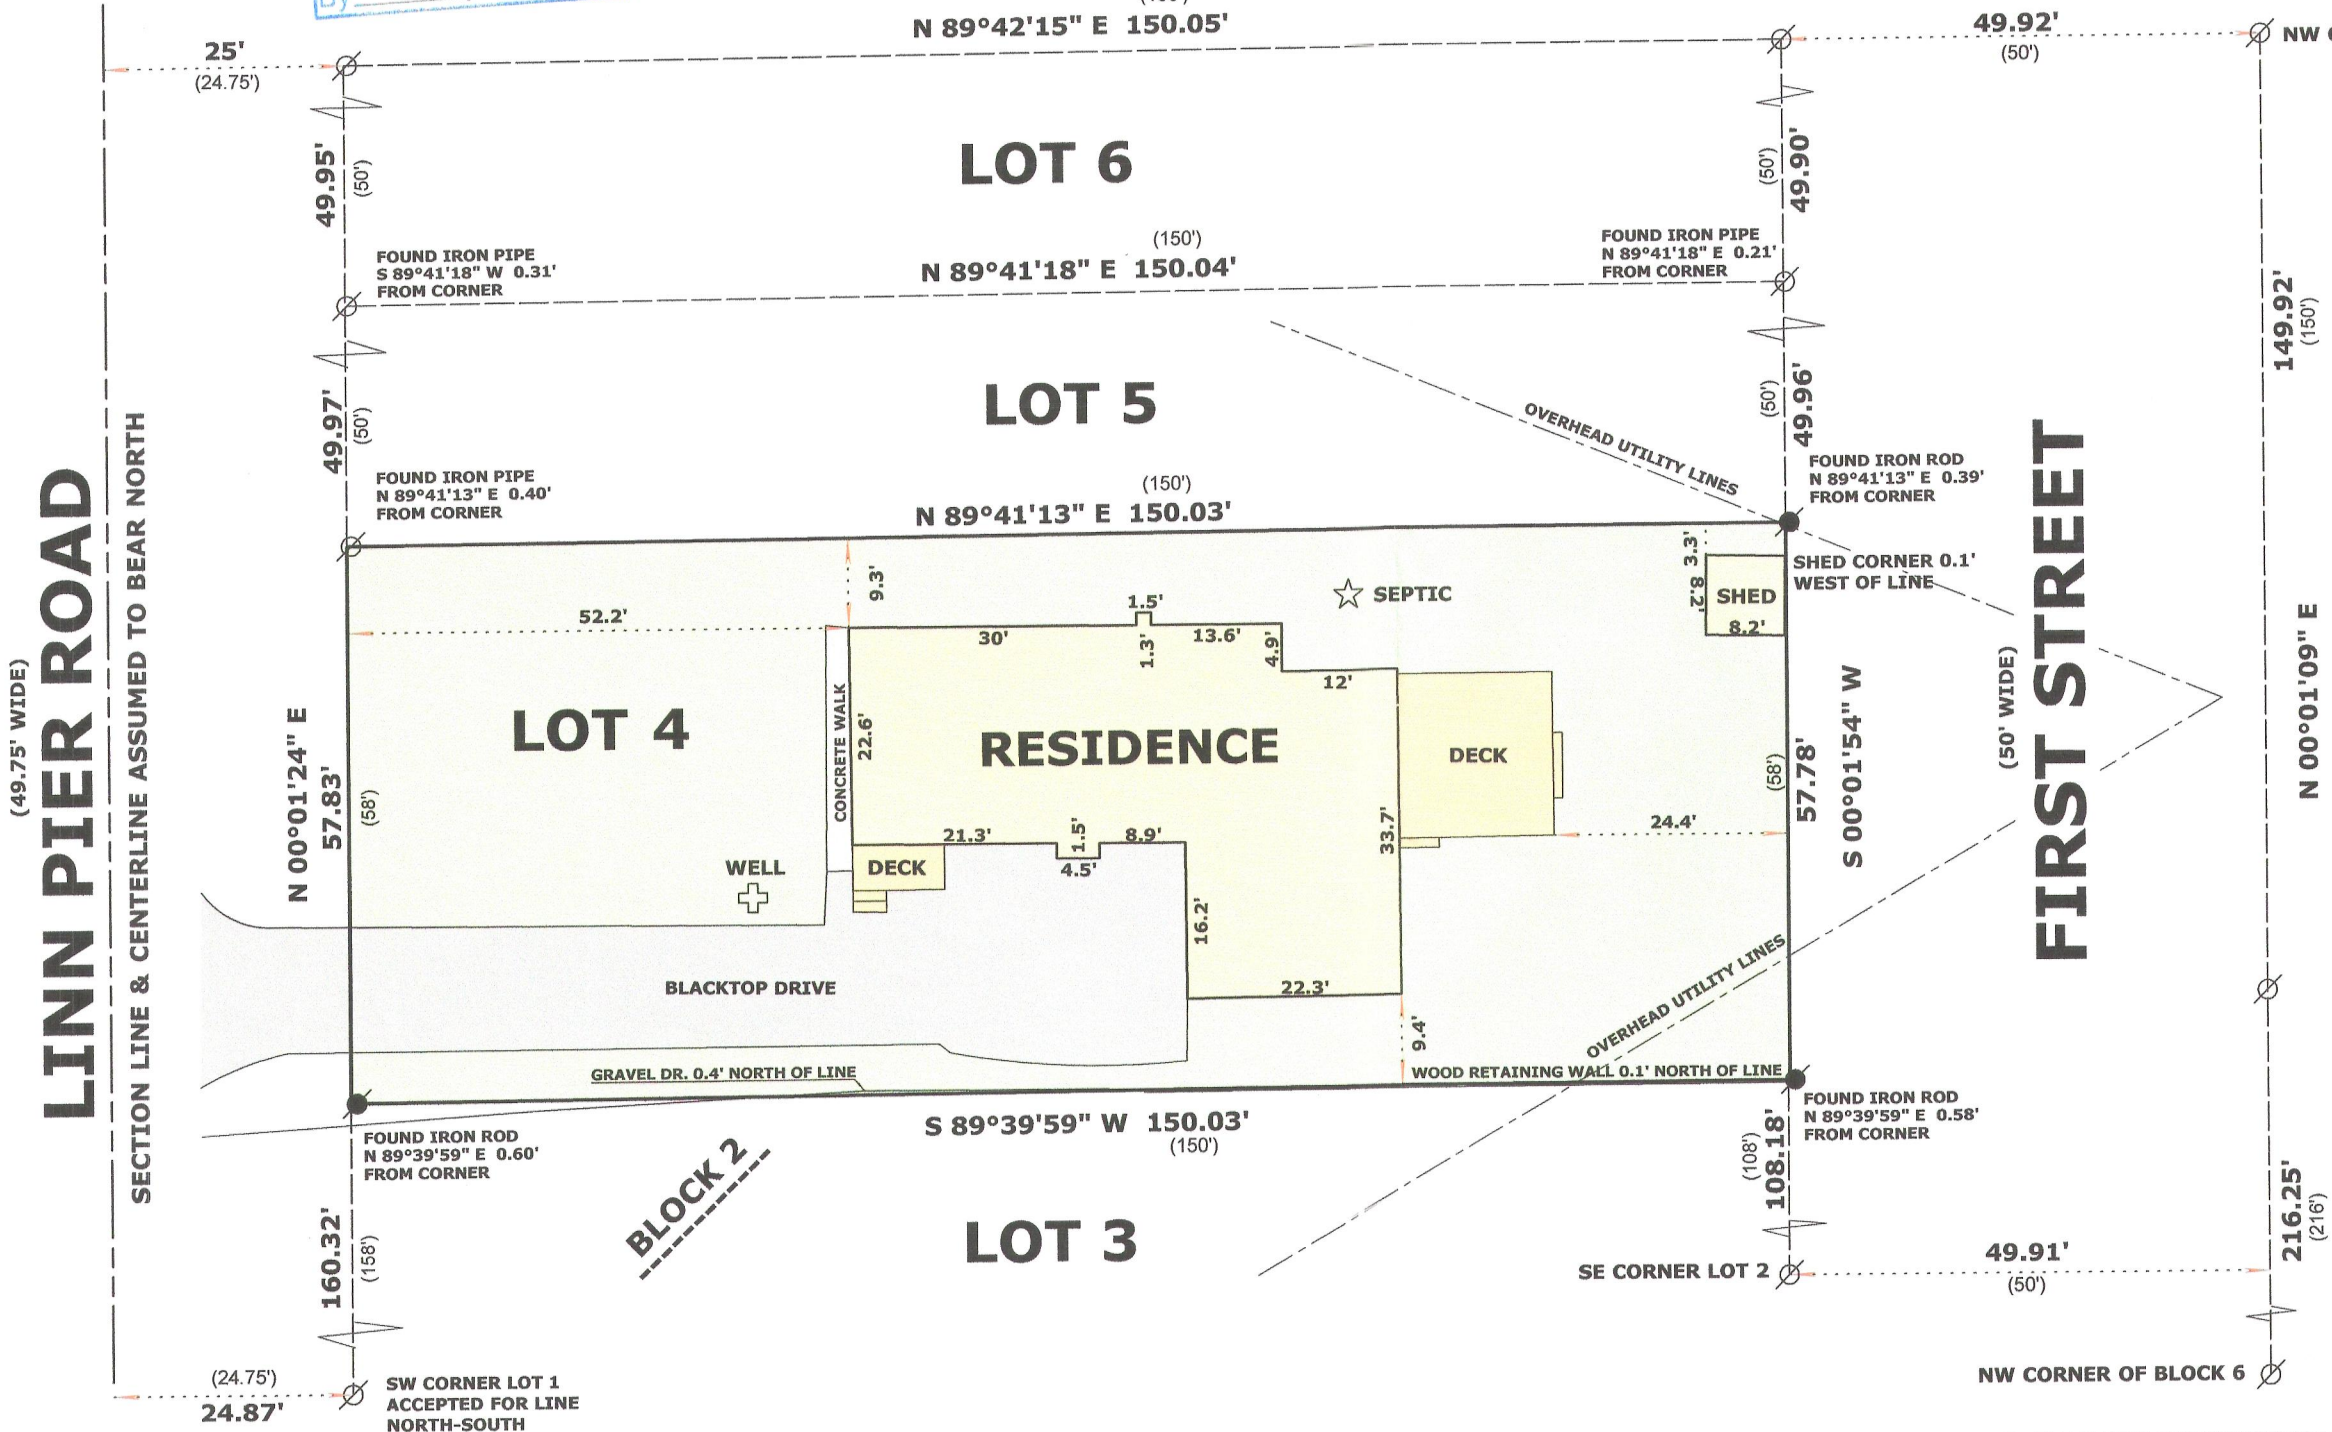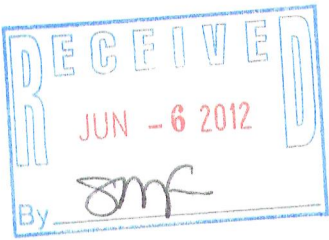

- LEGEND**
- FOUND IRON PIPE
  - FOUND IRON ROD
  - RECORDED AS DIMENSION

**SCALE: 1 INCH = 20 FEET**

"I hereby certify that the above described property has been surveyed by me or under my direction and that the above map is a true representation thereof and shows the size and location of the property, its exterior boundaries, the location of all visible structures and dimensions of all principal buildings thereon, boundary fences, apparent easements, roadways and visible encroachments, if any."

"This survey is made for the use of the present owners of the property, and also those who purchase, mortgage, or guarantee the title thereto within one year from date hereof."

*Mark L. Miritz*  
**MARK L. MIRITZ**  
**WISCONSIN REGISTERED**  
**LAND SURVEYOR S-2582**

**DATE:** JUNE 1, 2012 **JOB NO.** 12.512

IGV-5

117-3403