

PREPARED FOR
R.J. AMANN BUILDERS
2492 CREST DR.
LAKE GENEVA WI. 53147.

PLAT OF SURVEY

-OF-

LOT 27 OF LAKE GENEVA HIGHLANDS, A SUBDIVISION
LOCATED IN SECTION 8, TOWN 1 NORTH, RANGE 17 EAST,
WALWORTH COUNTY, WISCONSIN.

KROTT SURVEYING INC.

N3705 WILLOW BEND LANE




LAKE GENEVA WI. 53147

PHONE # (262)248-3697


FAX # (262)249-0639

C.L. LAKEVIEW ROAD

(50' WIDE)

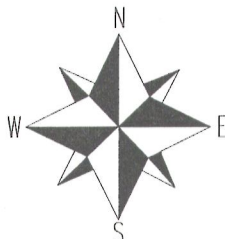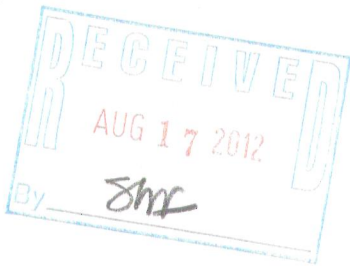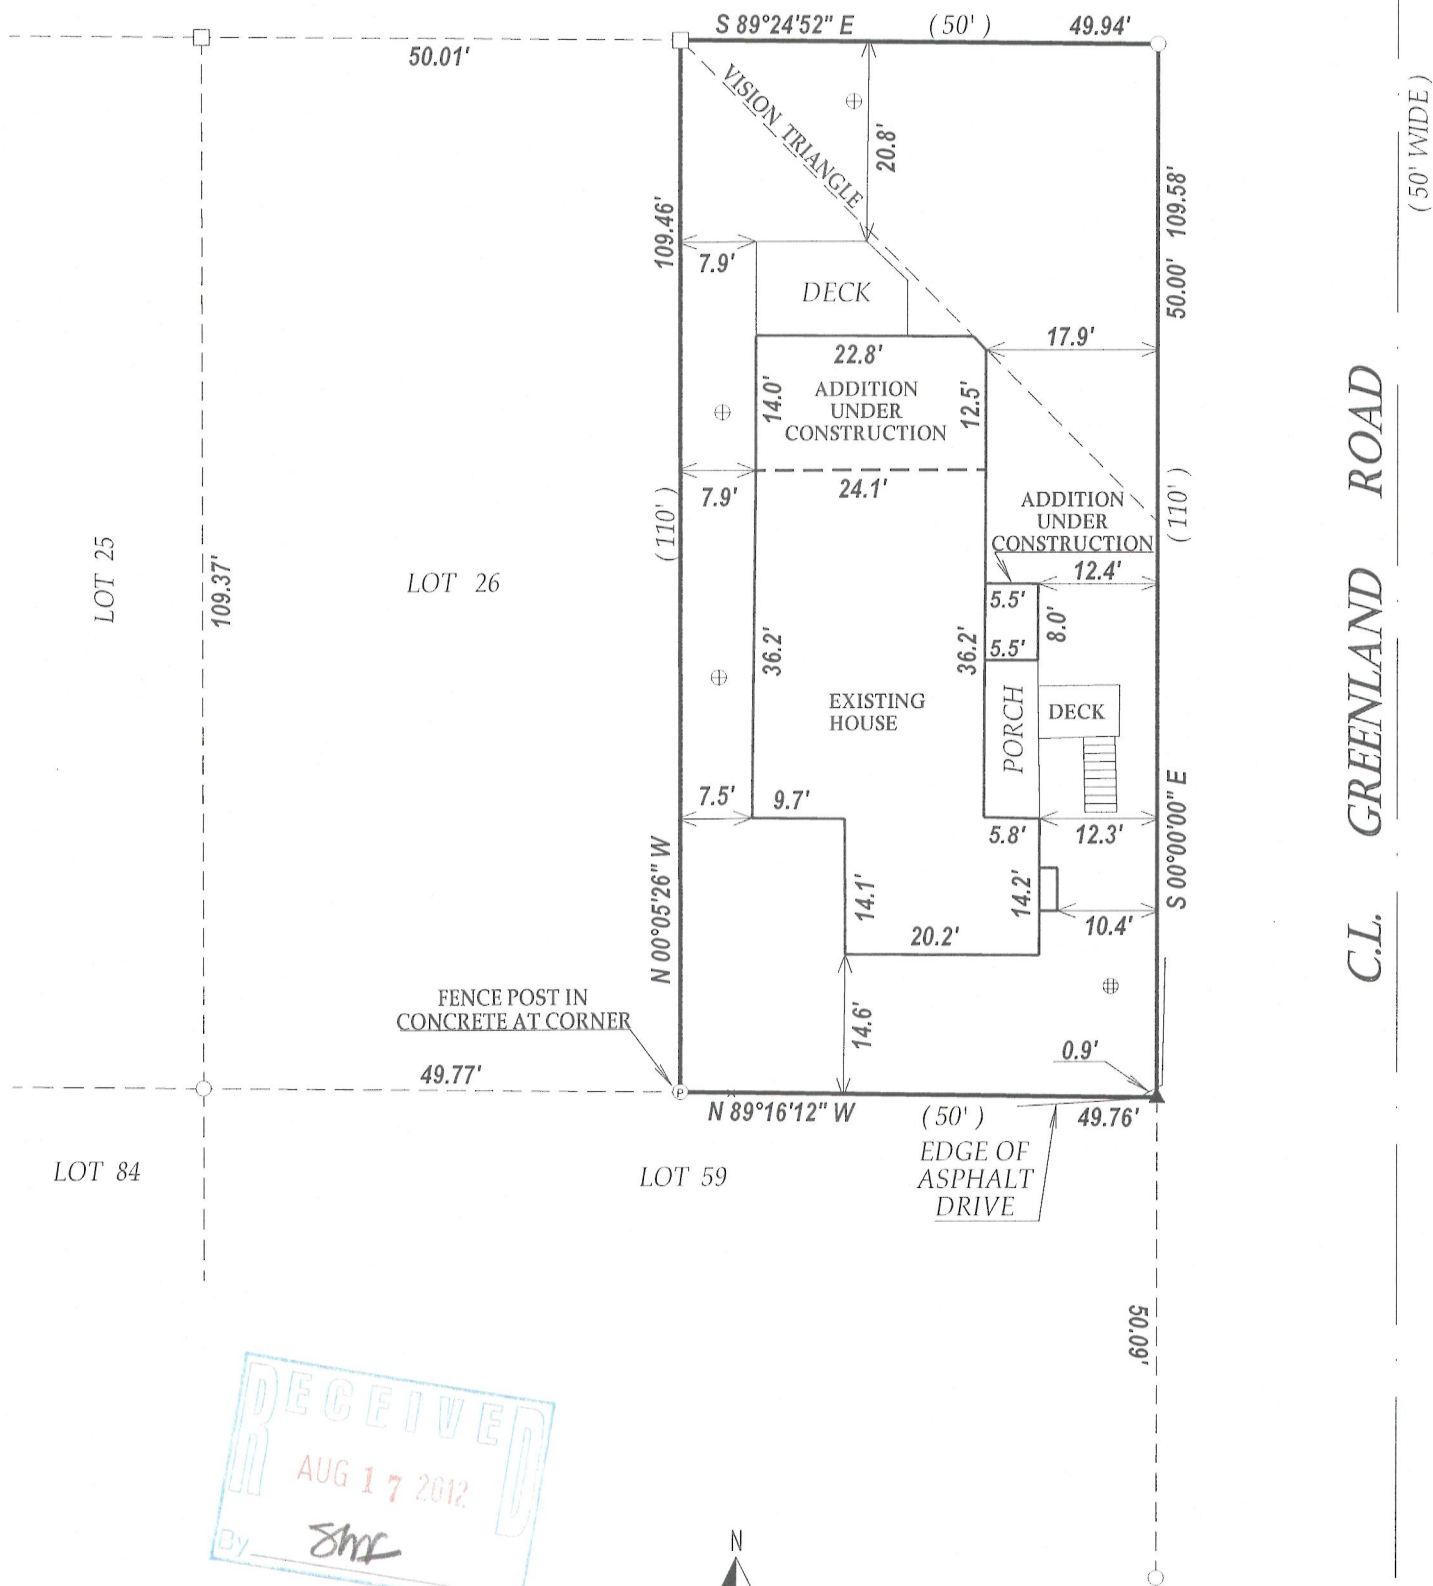

SCALE 1" = 20'

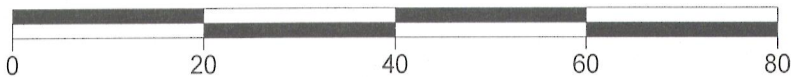

NOTE: THE EAST LINE OF LOT 27 WAS ASSUMED TO BE NORTH-SOUTH

LEGEND

- FOUND IRON PIPE
- FOUND IRON BAR
- ▲ SET MAG NAIL
- ⊕ CONCRETE LID
- ⊕ METAL LID

(XX) RECORDED AS

TAX ID # ILGH00026

JOB # 12-015

I have surveyed the above-described property and the above map is a true representation thereof and shows the size and location of the property, its exterior boundaries, the location and dimensions of all structures thereon, fences apparent easements and roadways and visible encroachments, if any.

This survey is made for the exclusive use of the present owners of the property, and also those who purchase, mortgage, or insure the title thereto within one (1) year from date hereof; and as to them I warrant the accuracy of said survey map.



DATED THIS 29th DAY OF FEBRUARY 2012.
DATE OF LAST REVISION: 07/16/2012
REVISED 5/03/2012

John P. Krott

JOHN KROTT S - 2258
Wisconsin Registered Land Surveyor
(original if signed in red)

117-3422