


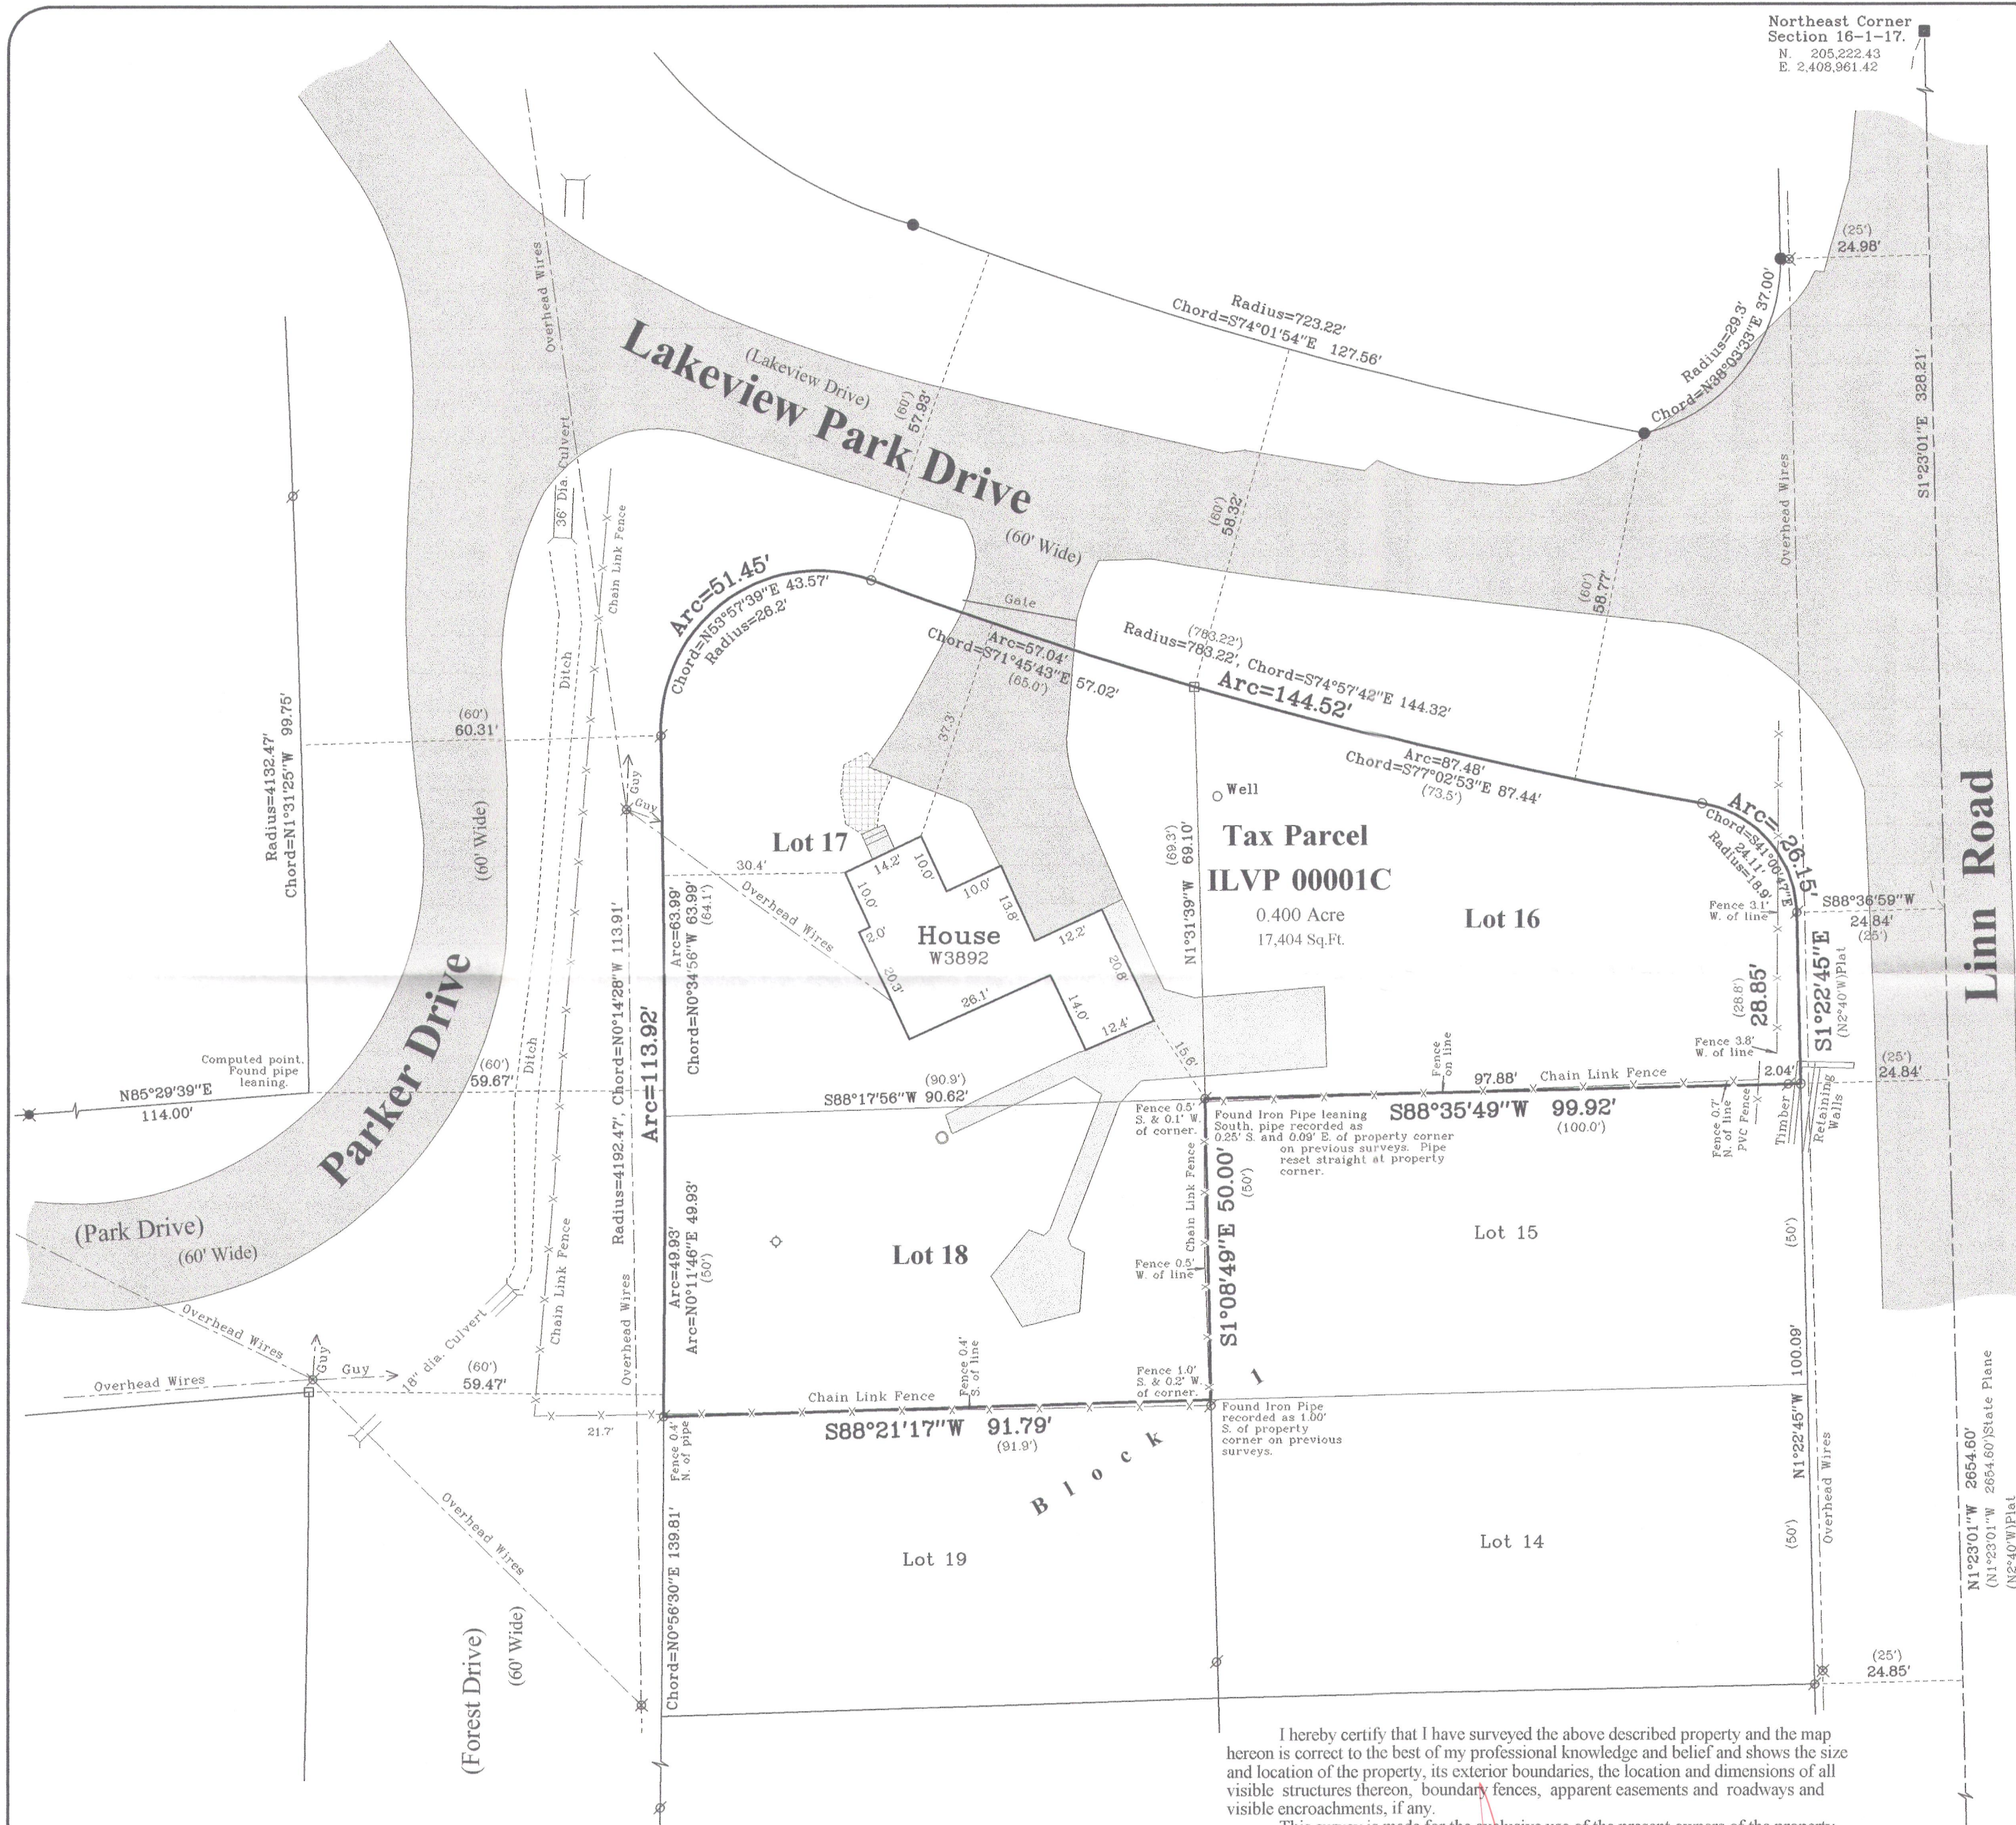

Copyright 2012 by Jensen & Olson Land Surveying, LLC.

All rights reserved. No part of this survey plat may be reproduced or transmitted in any form by any means - graphic, electronic, or mechanical, including photocopying, tracing, or information storage and retrieval systems - without permission in writing from Douglas G. Olson, Jensen & Olson Land Surveying, LLC.

I hereby certify that I have surveyed the above described property and the map hereon is correct to the best of my professional knowledge and belief and shows the size and location of the property, its exterior boundaries, the location and dimensions of all visible structures thereon, boundary fences, apparent easements and roadways and visible encroachments, if any.

This survey is made for the exclusive use of the present owners of the property, and also those who purchase, mortgage or guarantee title thereto, within one year from the date hereof.

Douglas G. Olson
Wisconsin Registered Land Surveyor - 2093

East 1/4 Corner
Section 16-1-17.
N. 202,568.61
E. 2,409,025.52


Plat of Survey

of
**Lots 16, 17 & 18 in Block 1
of Lakeview Park,**
a subdivision located in the Northeast 1/4 of Section 16,
Town 1 North, Range 17 East, Town of Linn,
Walworth County, Wisconsin.



Surveyed for:

RE/MAX Geneva Realty, Ltd.

101 Broad Street, Suite 102
Lake Geneva, Wisconsin. 53147

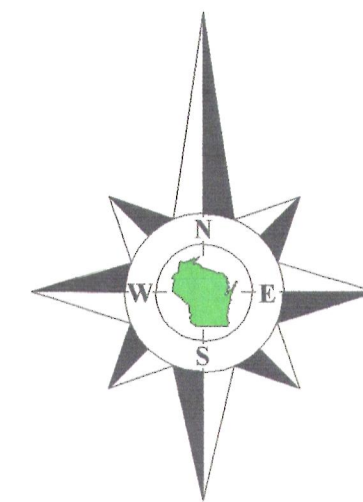

Bearings reference to the Wisconsin State
Plane Coordinate System, South Zone.

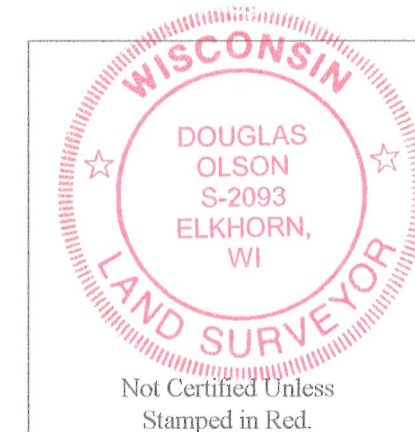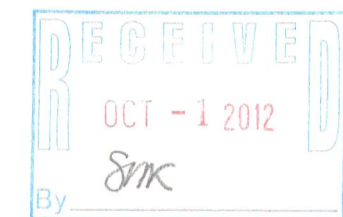

Notes:

- 1) This survey plat is not certified unless signed and sealed in red ink.
- 2) This survey is subject to Wisconsin lien laws. This Plat of Survey is the notice of intent to file lien. Lien waiver required.

Survey Date: September 21, 2012.
Revisions:

Scale in Feet
1" = 20'



Jensen & Olson Land Surveying, LLC
45 South Wisconsin Street * P.O. Box 322 * Elkhorn, Wisconsin. 53121
Telephone: (262) 723-3434 * Facsimile: (262) 723-8044
Email: jensen.olson@elknet.net

- Legend**
- Found County Section Corner
 - Found Iron Pipe
 - Found Iron Rod
 - Found Pipe 1" dia.
 - Found Pipe 1.5" dia.
 - Recorded Information
 - Utility Pole
 - Septic Vent
 - Concrete Cover
 - Asphalt
 - Concrete Surface
 - Flagstone

Sheet 1 of 1 Sheets
Drawing Name: Ilvp17-2012105-2012105Pak.dwg
Job Reference Number
2012.105

2012.105

ILVP-1C

117.3453