
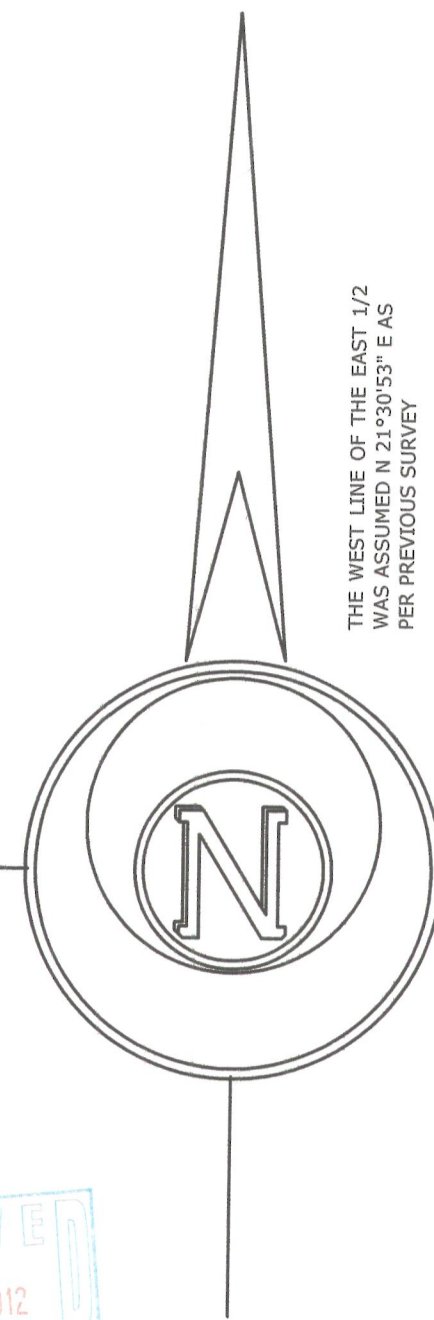


PLAT OF SURVEY


LOT 1 AND LOTS 13-15 INCLUSIVE AND THE
EAST 1/2 OF LOT 16 OF BLOCK "F" OF CISCO
BEACH SUBDIVISION, LOCATED IN SECTION
5, TOWN 1 NORTH, RANGE 17 EAST, LINN
TOWNSHIP, WALWORTH COUNTY, WISCONSIN.

OWNERS: ERIC T. MAU
LAURA A. MAU
207 N. EMERSON ST.
MT. PROSPECT, IL 60056

SITE ADDRESS: W4272 CRESCENT DRIVE

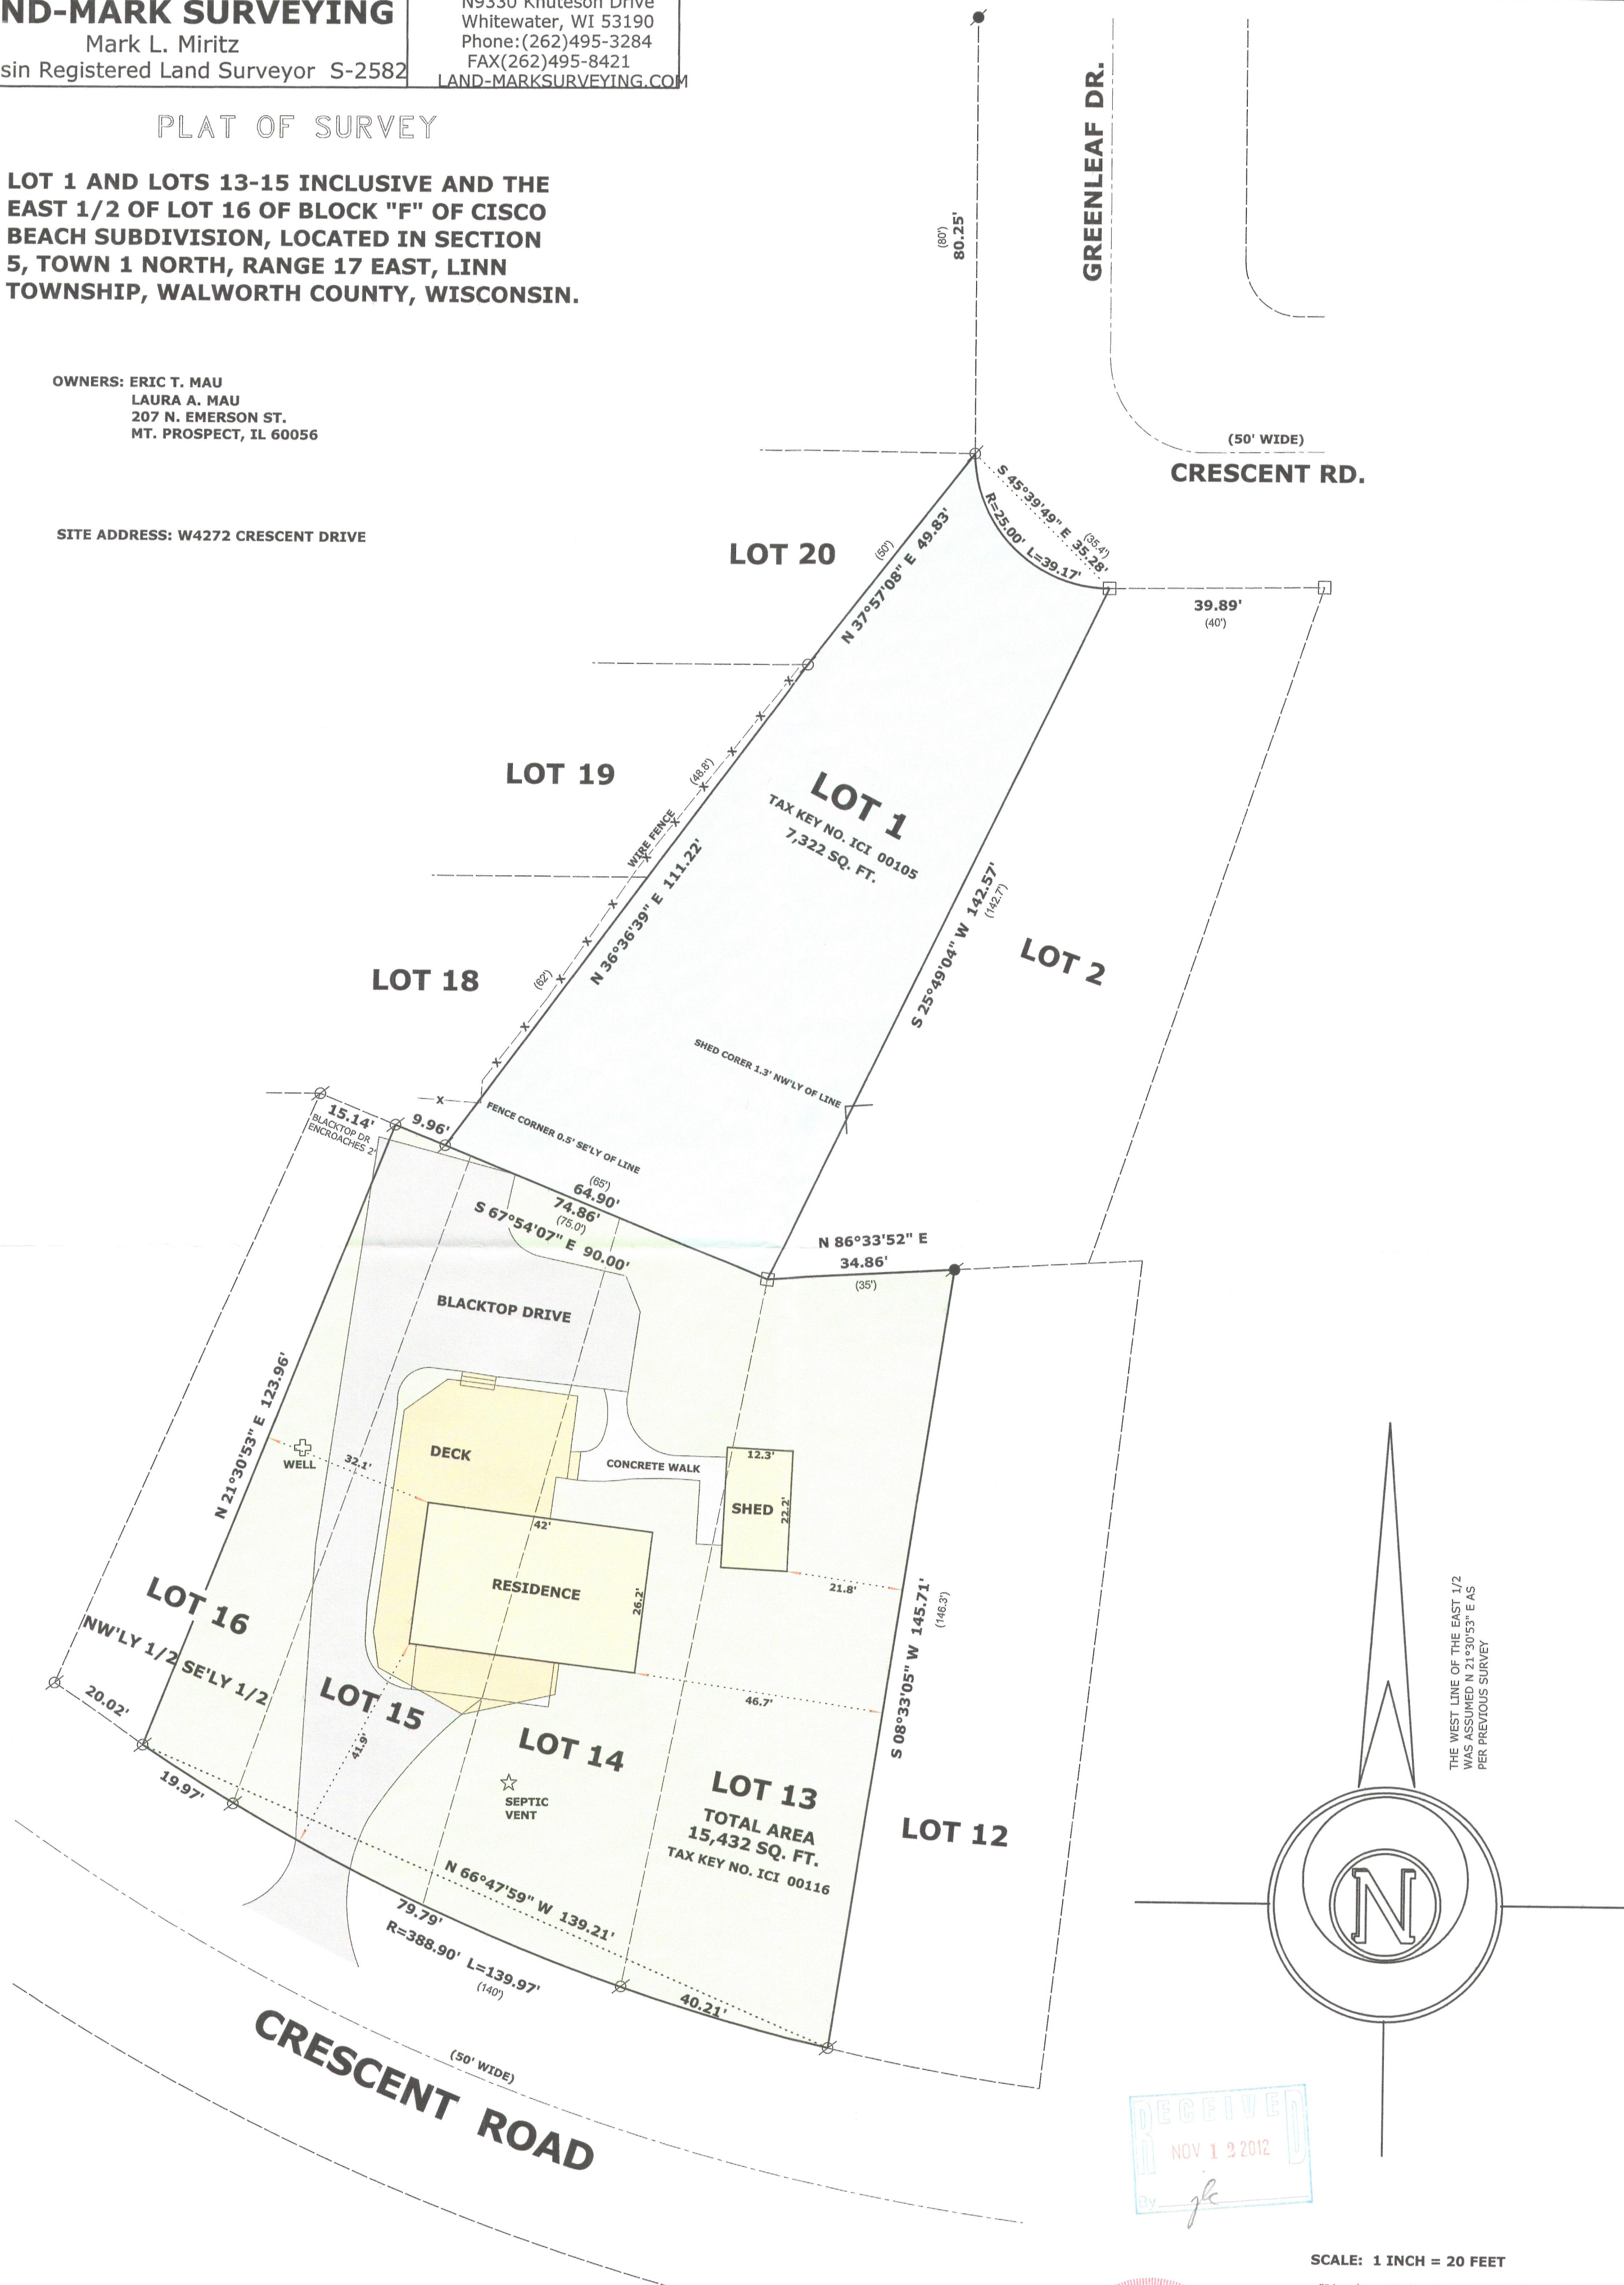

THE WEST LINE OF THE EAST 1/2
WAS ASSUMED N 21°30'53" E AS
PER PREVIOUS SURVEY

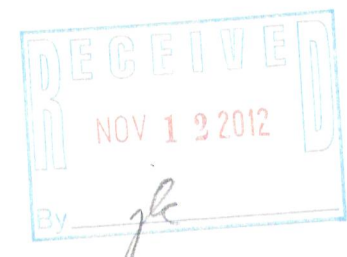

- LEGEND**
- FOUND IRON ROD
 - FOUND IRON PIPE
 - FOUND CONCRETE MONUMENT
 - (x x) RECORDED AS DIMENSION

ICI 00116

117-3468



SCALE: 1 INCH = 20 FEET

"I hereby certify that the above described property has been surveyed by me or under my direction and that the above map is a true representation thereof and shows the size and location of the property, its exterior boundaries, the location of all visible structures and dimensions of all principal buildings thereon, boundary fences, apparent easements, roadways and visible encroachments, if any."

"This survey is made for the use of the present owners of the property, and also those who purchase, mortgage, or guarantee the title thereto within one year from date hereof."

Mark L. Miritz
MARK L. MIRITZ
WISCONSIN REGISTERED
LAND SURVEYOR S-2582

REVISED AUGUST 23, 2012 TO SHOW LOT 1

DATE: DEC. 4, 2011

JOB NO. 11.1201