PREPARED FOR JOHN WENDT N1703 WOODDALE RD. LAKE GENEVA WI. 53147


## PLAT OF SURVEY

-OF-

KROTT SURVEYING INC.
N3705 WILLOW BEND LANE

N3705 WILLOW BEND LAN LAKE GENEVA WI. 53147 PHONE # (262)248-3697 FAX # (262)249-0639

LOTS 1 THRU 6 ALL INCLUSIVE, BLOCK 12, MAPLE HILLS "A" SUBDIVISION LOCATED IN SECTION 18, TOWN 1 NORTH RANGE 17 EAST, TOWN OF LINN, WALWORTH COUNTY, WISCONSIN

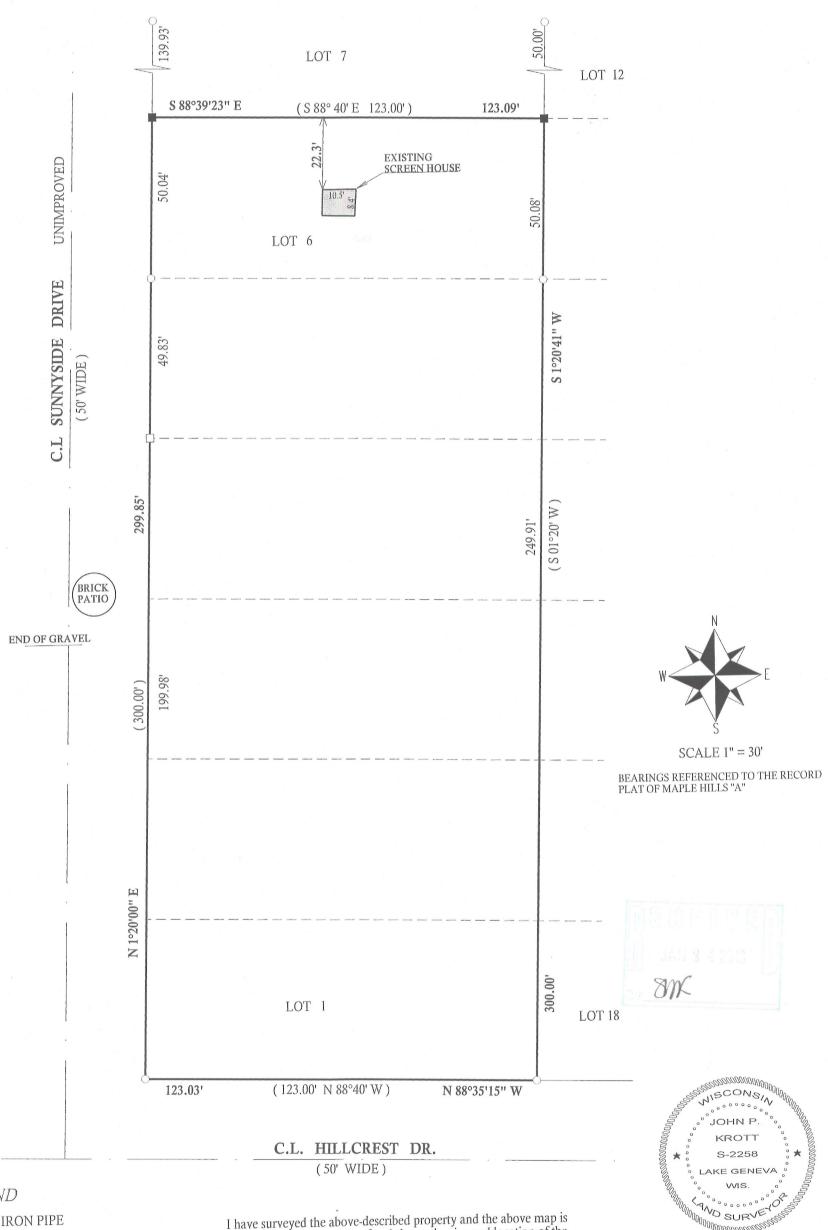

LEGEND

O FOUND IRON PIPE

☐ FOUND IRON BAR

SET IRON BAR

(XX) RECORDED AS

JOB # 13-003 TAX HD # IMH00246 & 248

I have surveyed the above-described property and the above map is a true representation thereof and shows the size and location of the property, its exterior boundaries, the location and dimensions of all structures thereon, fences apparent easements and roadways and visible encroachments. if any.

This survey is made for the exclusive use of the present owners of the property, and also those who puchase, mortgage, or insure the title therto within one (1) year from date hereof; and as to them I warrant the accuracy of said survey map.

DATED THIS 7th, DAY OF JANUARY, 2013

JOHN KROTT S - 2258 Wisconsin Registered Land Surveyor ( original if signed in red )

117-3495