

**FARRIS, HANSEN & ASSOC. INC.**


7 RIDGWAY COURT- P.O. BOX 437  
ELKHORN, WISCONSIN 53121  
PHONE (262) 723-2098  
FAX (262) 723-5886

ORDERED BY: FAIRWYN  
851 PARK DRIVE, SUITE 104  
LAKE GENEVA, WI. 53147

**PLAT OF SURVEY**  
**LOT 57, SHORE HAVEN**  
**A SUBDIVISION IN THE SW 1/4 OF THE NE 1/4**  
**SECTION 18, TOWN 1 NORTH, RANGE 17 EAST**  
**WALWORTH COUNTY, WISCONSIN**

Lot 57 in the subdivision known as Shore Haven, which is situated in the parcel of land known as Lot 2 in Section 18, T1N, R17E, Town of Linn, Walworth County, Wisconsin.

Tax Key No: ISA 00056

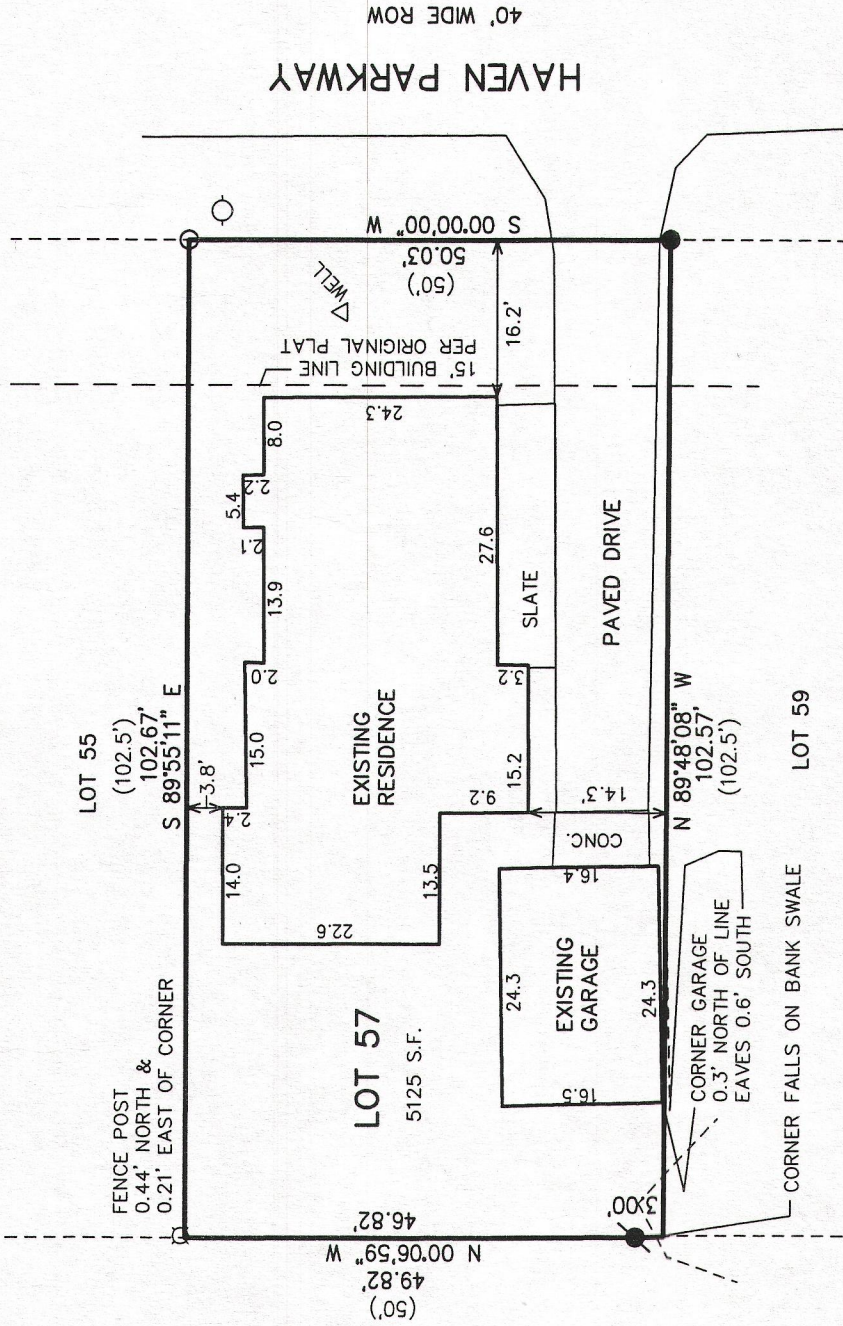

ASSIGNED WEST LINE HAVEN PARKWAY NORTH



- LEGEND**
- = FOUND IRON PIPE STAKE
  - = FOUND IRON REBAR STAKE
  - ⊙ = SET IRON REBAR STAKE
  - = UTILITY POLE
  - (XXX) = RECORDED AS

NOTE: COPIES OF THIS MAP TO WHICH THE FOLLOWING CERTIFICATE WILL APPLY SHOW THE SURVEYOR'S ORIGINAL SEAL AND SIGNATURE IN RED INK. COPIES BY ANY OTHER MEANS MAY HAVE ALTERATIONS WHICH DO NOT REPRESENT THE SURVEYOR'S WORK PRODUCT.


I HEREBY CERTIFY THAT THE ABOVE DESCRIBED PROPERTY HAS BEEN SURVEYED UNDER MY DIRECTION AND THAT THE ABOVE MAP IS A TRUE REPRESENTATION THEREOF AND SHOWS THE SIZE AND LOCATION OF THE PROPERTY, ITS EXTERIOR BOUNDARIES, THE LOCATION OF ALL VISIBLE STRUCTURES, AND DIMENSIONS OF ALL PRINCIPLE BUILDINGS THEREON, BOUNDARY FENCES, APPARENT EASEMENTS, ROADWAYS, AND VISIBLE ENCROACHMENTS, IF ANY. THIS SURVEY IS MADE FOR THE USE OF THE PRESENT OWNERS OF THE PROPERTY, AND ALSO THOSE WHO PURCHASE, MORTGAGE, OR GUARANTEE THE TITLE THERETO WITHIN ONE YEAR FROM THE DATE HEREOF.

DATED: MARCH 12, 2013

PETER S. GORDON



PROJECT NO. 8755  
DATED: 03-08-2013  
SHEET 1 OF 1 SHEETS

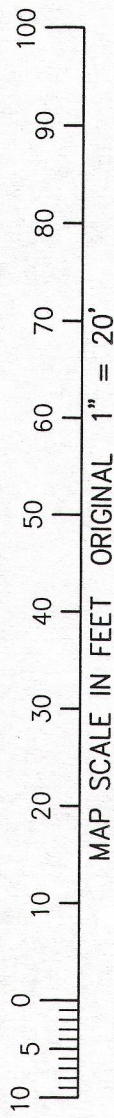

MAR 12 2013

ISA 00056

117-3509