

of


a subdivision located in the Southwest 1/4 of the Southwest 1/4 of Section 10,
Town 1 North, Range 17 East, Town of Linn, Walworth County, Wisconsin.

ALSO, A parcel of land described in an Abridgment of Judgment recorded in Vol. 593 on Page 271 as Document No. 243647, as shown below:

Beginning at the Northwest corner of Lot 1, Block 8, Genevista Subdivision; thence East 25 feet to the centerline of the vacated roadway; thence South 158 feet along the centerline of said roadway; thence East 25 feet; thence North 158 feet along the West line of said lot to the point of beginning.

Surveyed for: **Jean M. Barry Trust**


2729 North Dayton Street
Chicago, Illinois. 60614

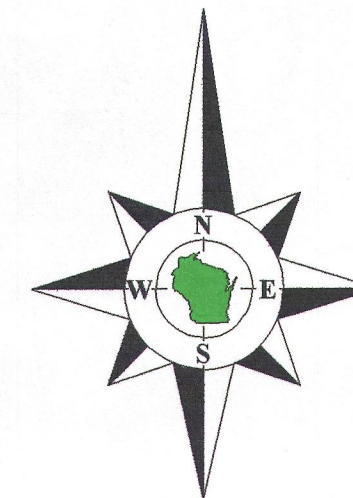

Bearings reference to previous surveys of record.

Note:

Elevations and contours shown are based upon site measurements taken prior to excavation for the new house and are no longer accurate in areas where grading has taken place.

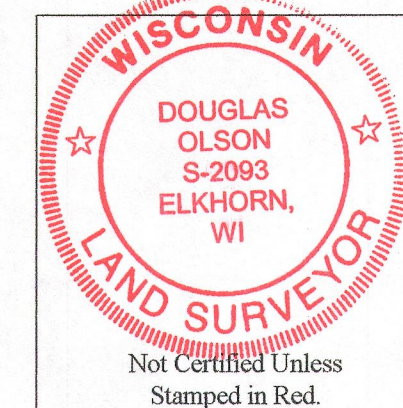

Notes:

- 1) This survey plat is not certified unless signed and sealed in red ink.
- 2) This survey is subject to Wisconsin lien laws. This Plat of Survey is the notice of intent to file lien. Lien waiver required.

Copyright 2012 by Jensen & Olson Land Surveying, LLC.

All rights reserved. No part of this survey plat may be reproduced or transmitted in any form by any means - graphic, electronic, or mechanical, including photocopying, tracing, or information storage and retrieval systems - without permission in writing from Douglas G. Olson, Jensen & Olson Land Surveying, LLC.

I, Douglas G. Olson, Wisconsin Registered Land Surveyor, do hereby certify that this survey was performed by me, or under my direction in full compliance with the owner's/agent's instructions and Chapter A-E 7 of the Wisconsin Administrative Code "Minimum Standards for Property Surveys"; and that this map is an accurate representation thereof to the best of my knowledge and belief.

Douglas G. Olson
Wisconsin Registered Land Surveyor - 2093

Survey Date: July 27, 2012.

Revisions: No. 1 - Set Lath
No. 2 - Proposed Hot Deck & Gars
No. 3 - House Staircase & Benchmark
No. 4 - Foundation

Scale in Feet
1" = 20'

A horizontal scale bar with alternating black and white segments. The segments are labeled 10', 20', and 40' from left to right. The 10' segment is divided into two 5' sub-segments, and the 20' segment is divided into four 5' sub-segments.

Jensen & Olson Land Surveying, LLC

45 South Wisconsin Street * P.O. Box 322 * Elkhorn, Wisconsin. 53121
Telephone: (262) 723-3434 * Facsimile: (262) 723-8044
E-mail: jensen_alison@earth.net

Email: jensen.olson@elknet.net

Legend

○	Found Iron Pipe	○	Concrete Cover
●	Set Iron Pipe Rod	●	Deciduous Tree
○	Found Iron Rod	●	Coniferous Tree
○	Set Iron Pipe, 1" dia.	○	Asphalt Surface
●	Set Wood Stake	○	Concrete Surface
○	Record Information	○	Gravel Surface
○	Utility Pole		
○	Septic Tank		

Sheet 1 of 1 Sheets

Drawing Name: thur17e-2012058-20120588Ple

Job Reference Number

2012.058

2012.058 /