


# Plat of Survey

of


## Lot 17 of Camp Sybil,

a subdivision located in the Northeast 1/4 of Section 18, Town 1 North, Range 17 East, Town of Linn, Walworth County, Wisconsin.

Surveyed for: **Cheri Moloznik**  
9 Sun Valley Court  
Lake in the Hills, Illinois. 60102

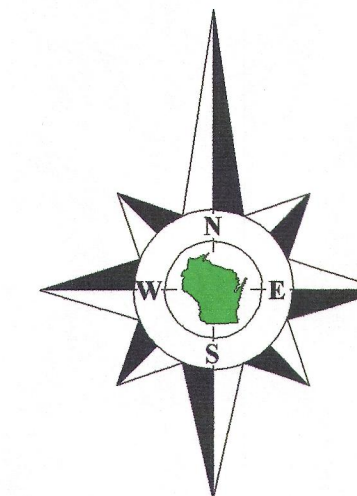

Bearings reference to the Wisconsin State Plane Coordinate System, South Zone.

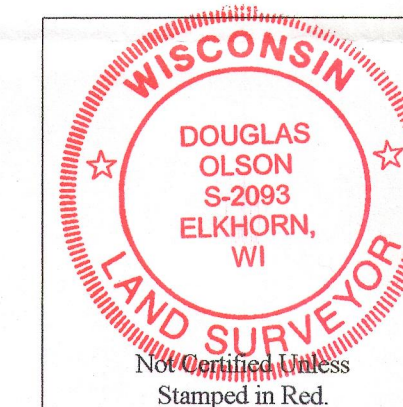


**Notes:**

- 1) This survey plat is not certified unless signed and sealed in red ink.
- 2) This survey is subject to Wisconsin lien laws. This Plat of Survey is the notice of intent to file lien. Lien waiver required.

Copyright 2012 by Jensen & Olson Land Surveying, LLC.

All rights reserved. No part of this survey plat may be reproduced or transmitted in any form by any means - graphic, electronic, or mechanical, including photocopying, tracing, or information storage and retrieval systems - without permission in writing from Douglas G. Olson, Jensen & Olson Land Surveying, LLC.

I, Douglas G. Olson, Wisconsin Registered Land Surveyor, do hereby certify that this survey was performed by me, or under my direction in full compliance with the owner's/agent's instructions and Chapter A-E 7 of the Wisconsin Administrative Code "Minimum Standards for Property Surveys"; and that this map is an accurate representation thereof to the best of my knowledge and belief.

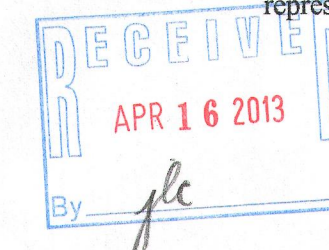

Douglas G. Olson  
Wisconsin Registered Land Surveyor - 2093

South 1/8 Corner of the Northeast 1/4 of Section 18-1-17.


East 1/4 Corner Section 18-1-17.  
N. 202,349.48  
E. 2,398,457.54

Center 1/4 Corner Section 18-1-17.  
N. 202,327.01  
E. 2,395,820.88


N89°23'02"E 803.62'

N89°30'42"E 2636.77'  
(N89°30'42"E 2636.77')State Plane

N89°30'42"E 2636.77'  
(N89°30'42"E 2636.77')State Plane

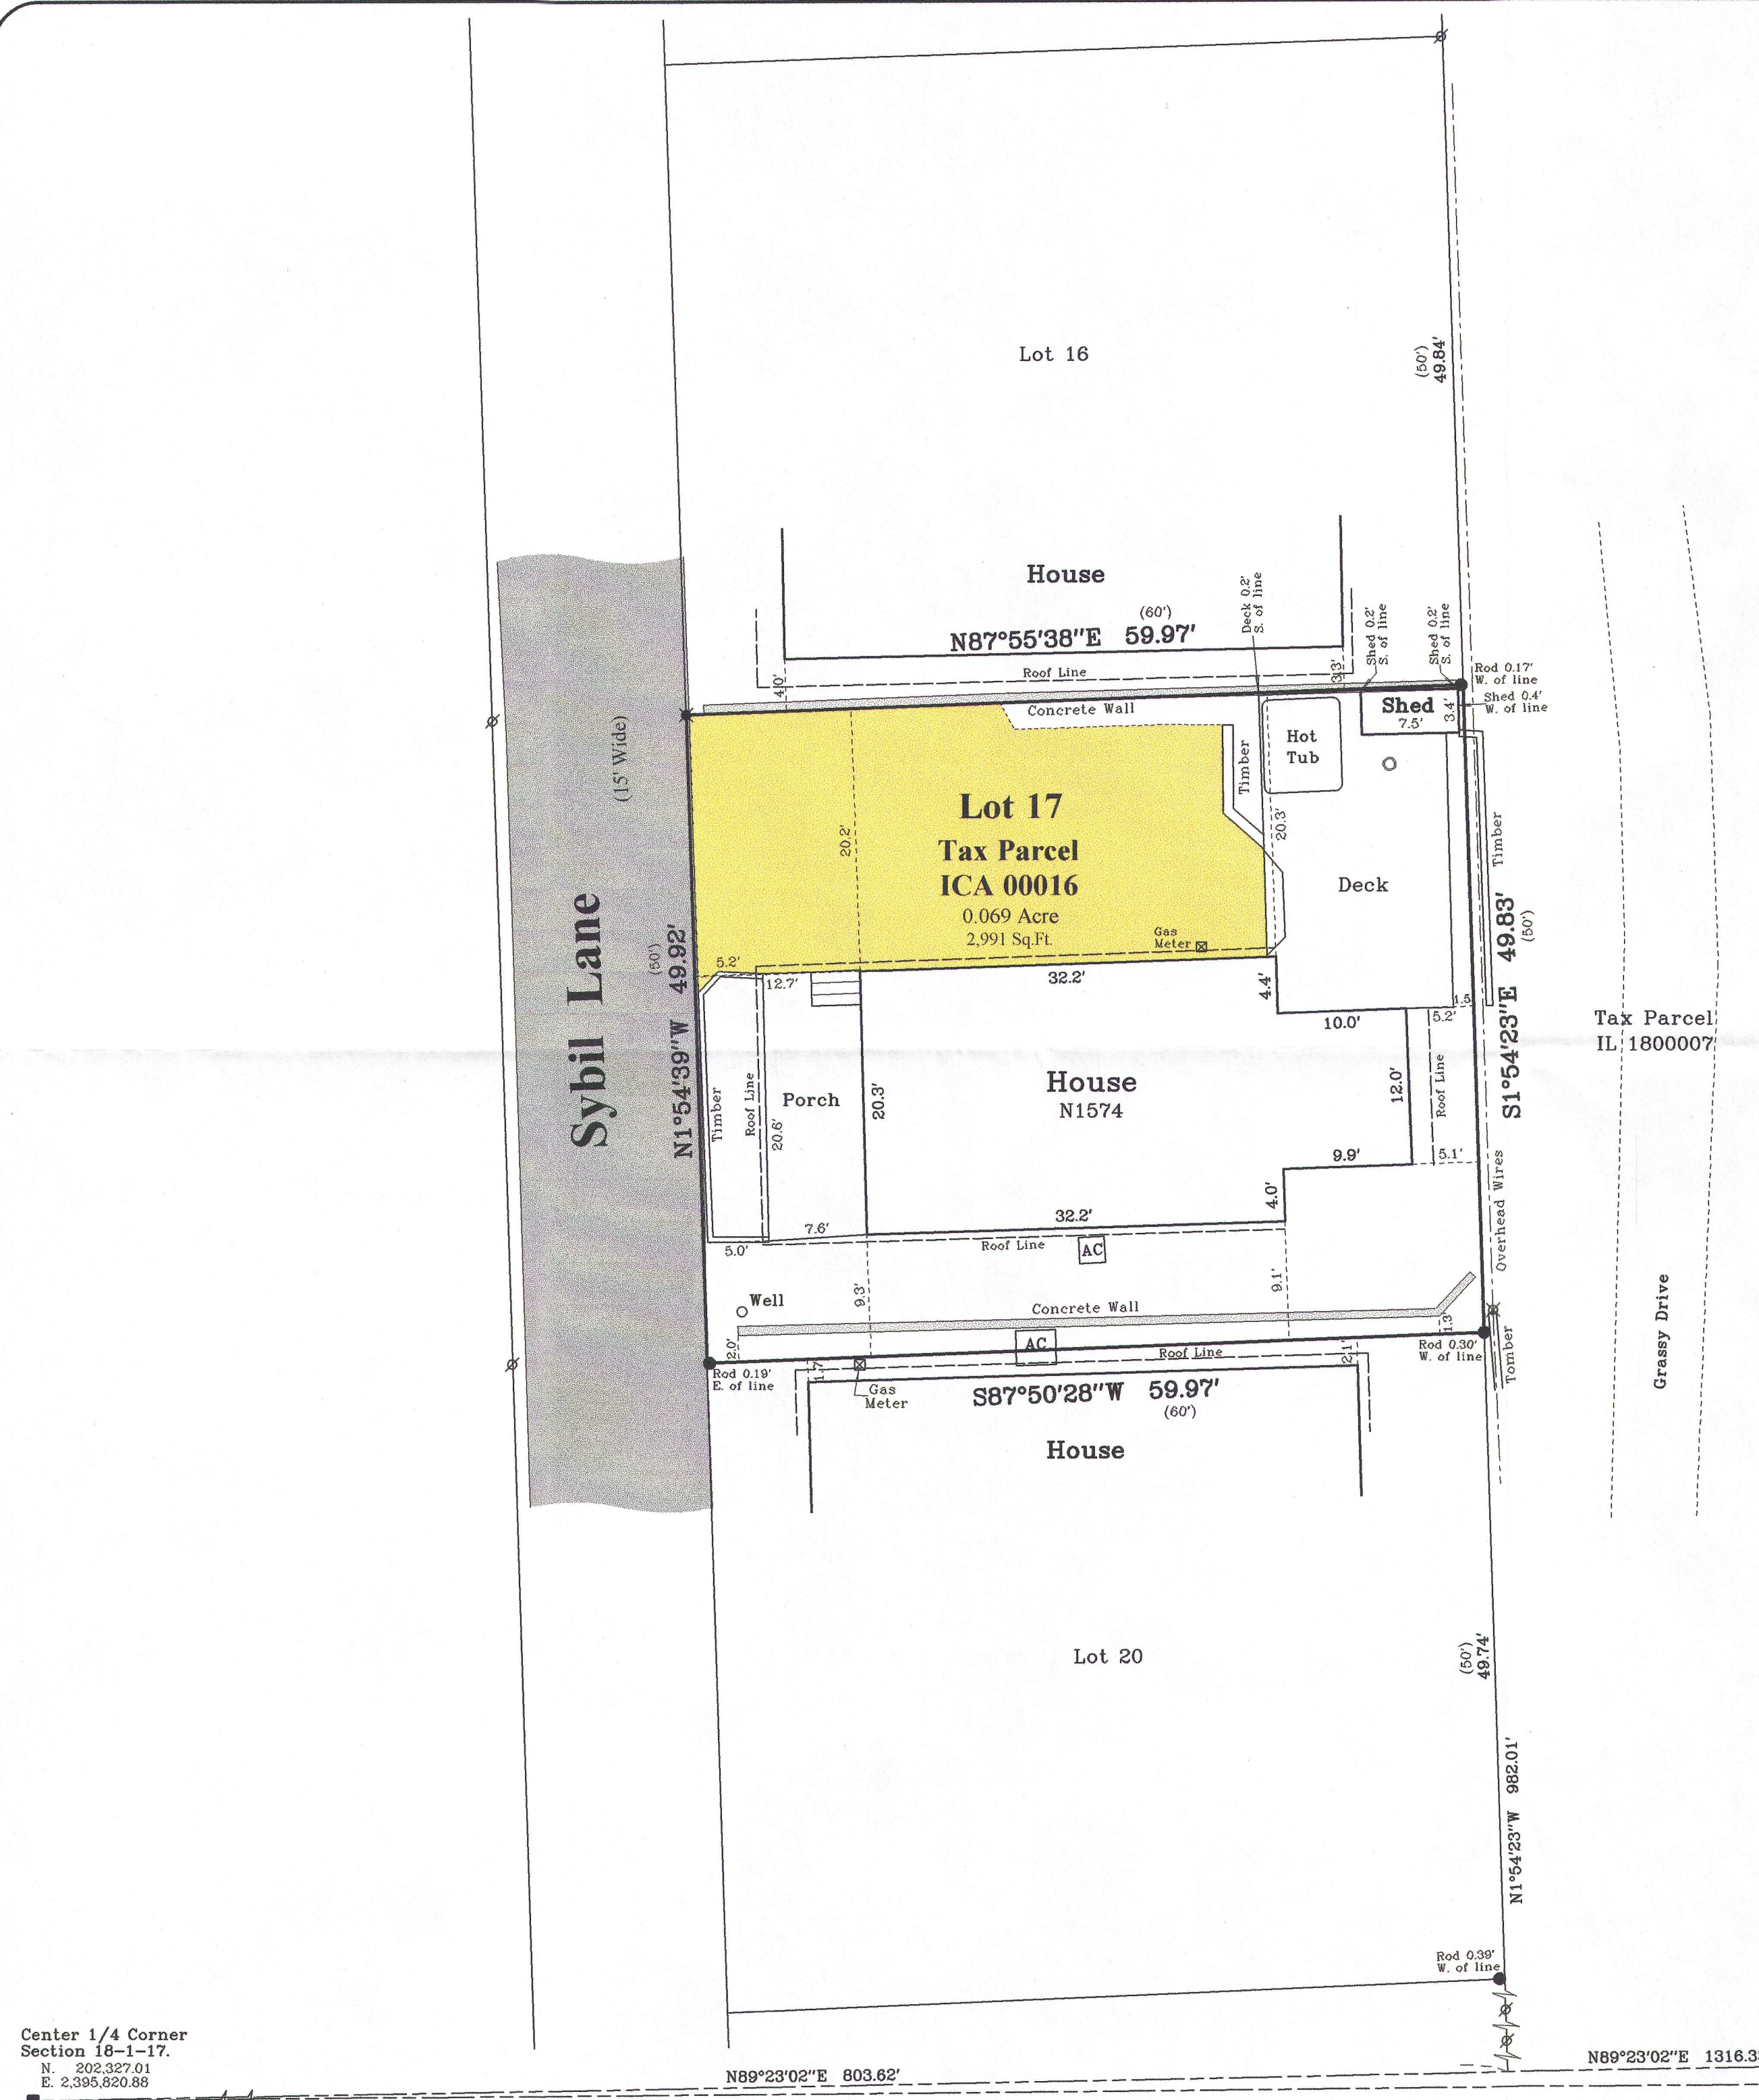

Survey Date: Sept. 14, 2012.  
Revisions: No. 1 - Misc. Info.

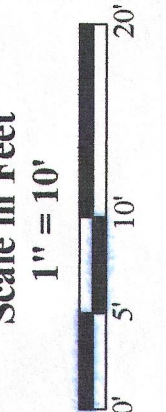

**Jensen & Olson Land Surveying, LLC**  
45 South Wisconsin Street \* P.O. Box 322 \* Elkhorn, Wisconsin. 53121  
Telephone: (262) 723-3434 \* Facsimile: (262) 723-8044  
Email: jensen.olson@elknet.net

- Legend**
- Found County Section Corner
  - Found Iron Pipe
  - Found Iron Rod
  - Set Mag Nail
  - Recorded Information
  - Utility Pedestal
  - Utility Pole
  - Asphalt Surface
  - Manhole
  - Concrete Surface
  - Gravel

Sheet 1 of 1 Sheets  
Drawing Name: 117-2012-06-2012(Plat)es  
Job Reference Number  
**2012.106**

**2012.106**

ICA 00016 117-3521