


Center 1/4 Corner
Section 18-1-17.
N. 202.327.01
E. 2,395,820.88

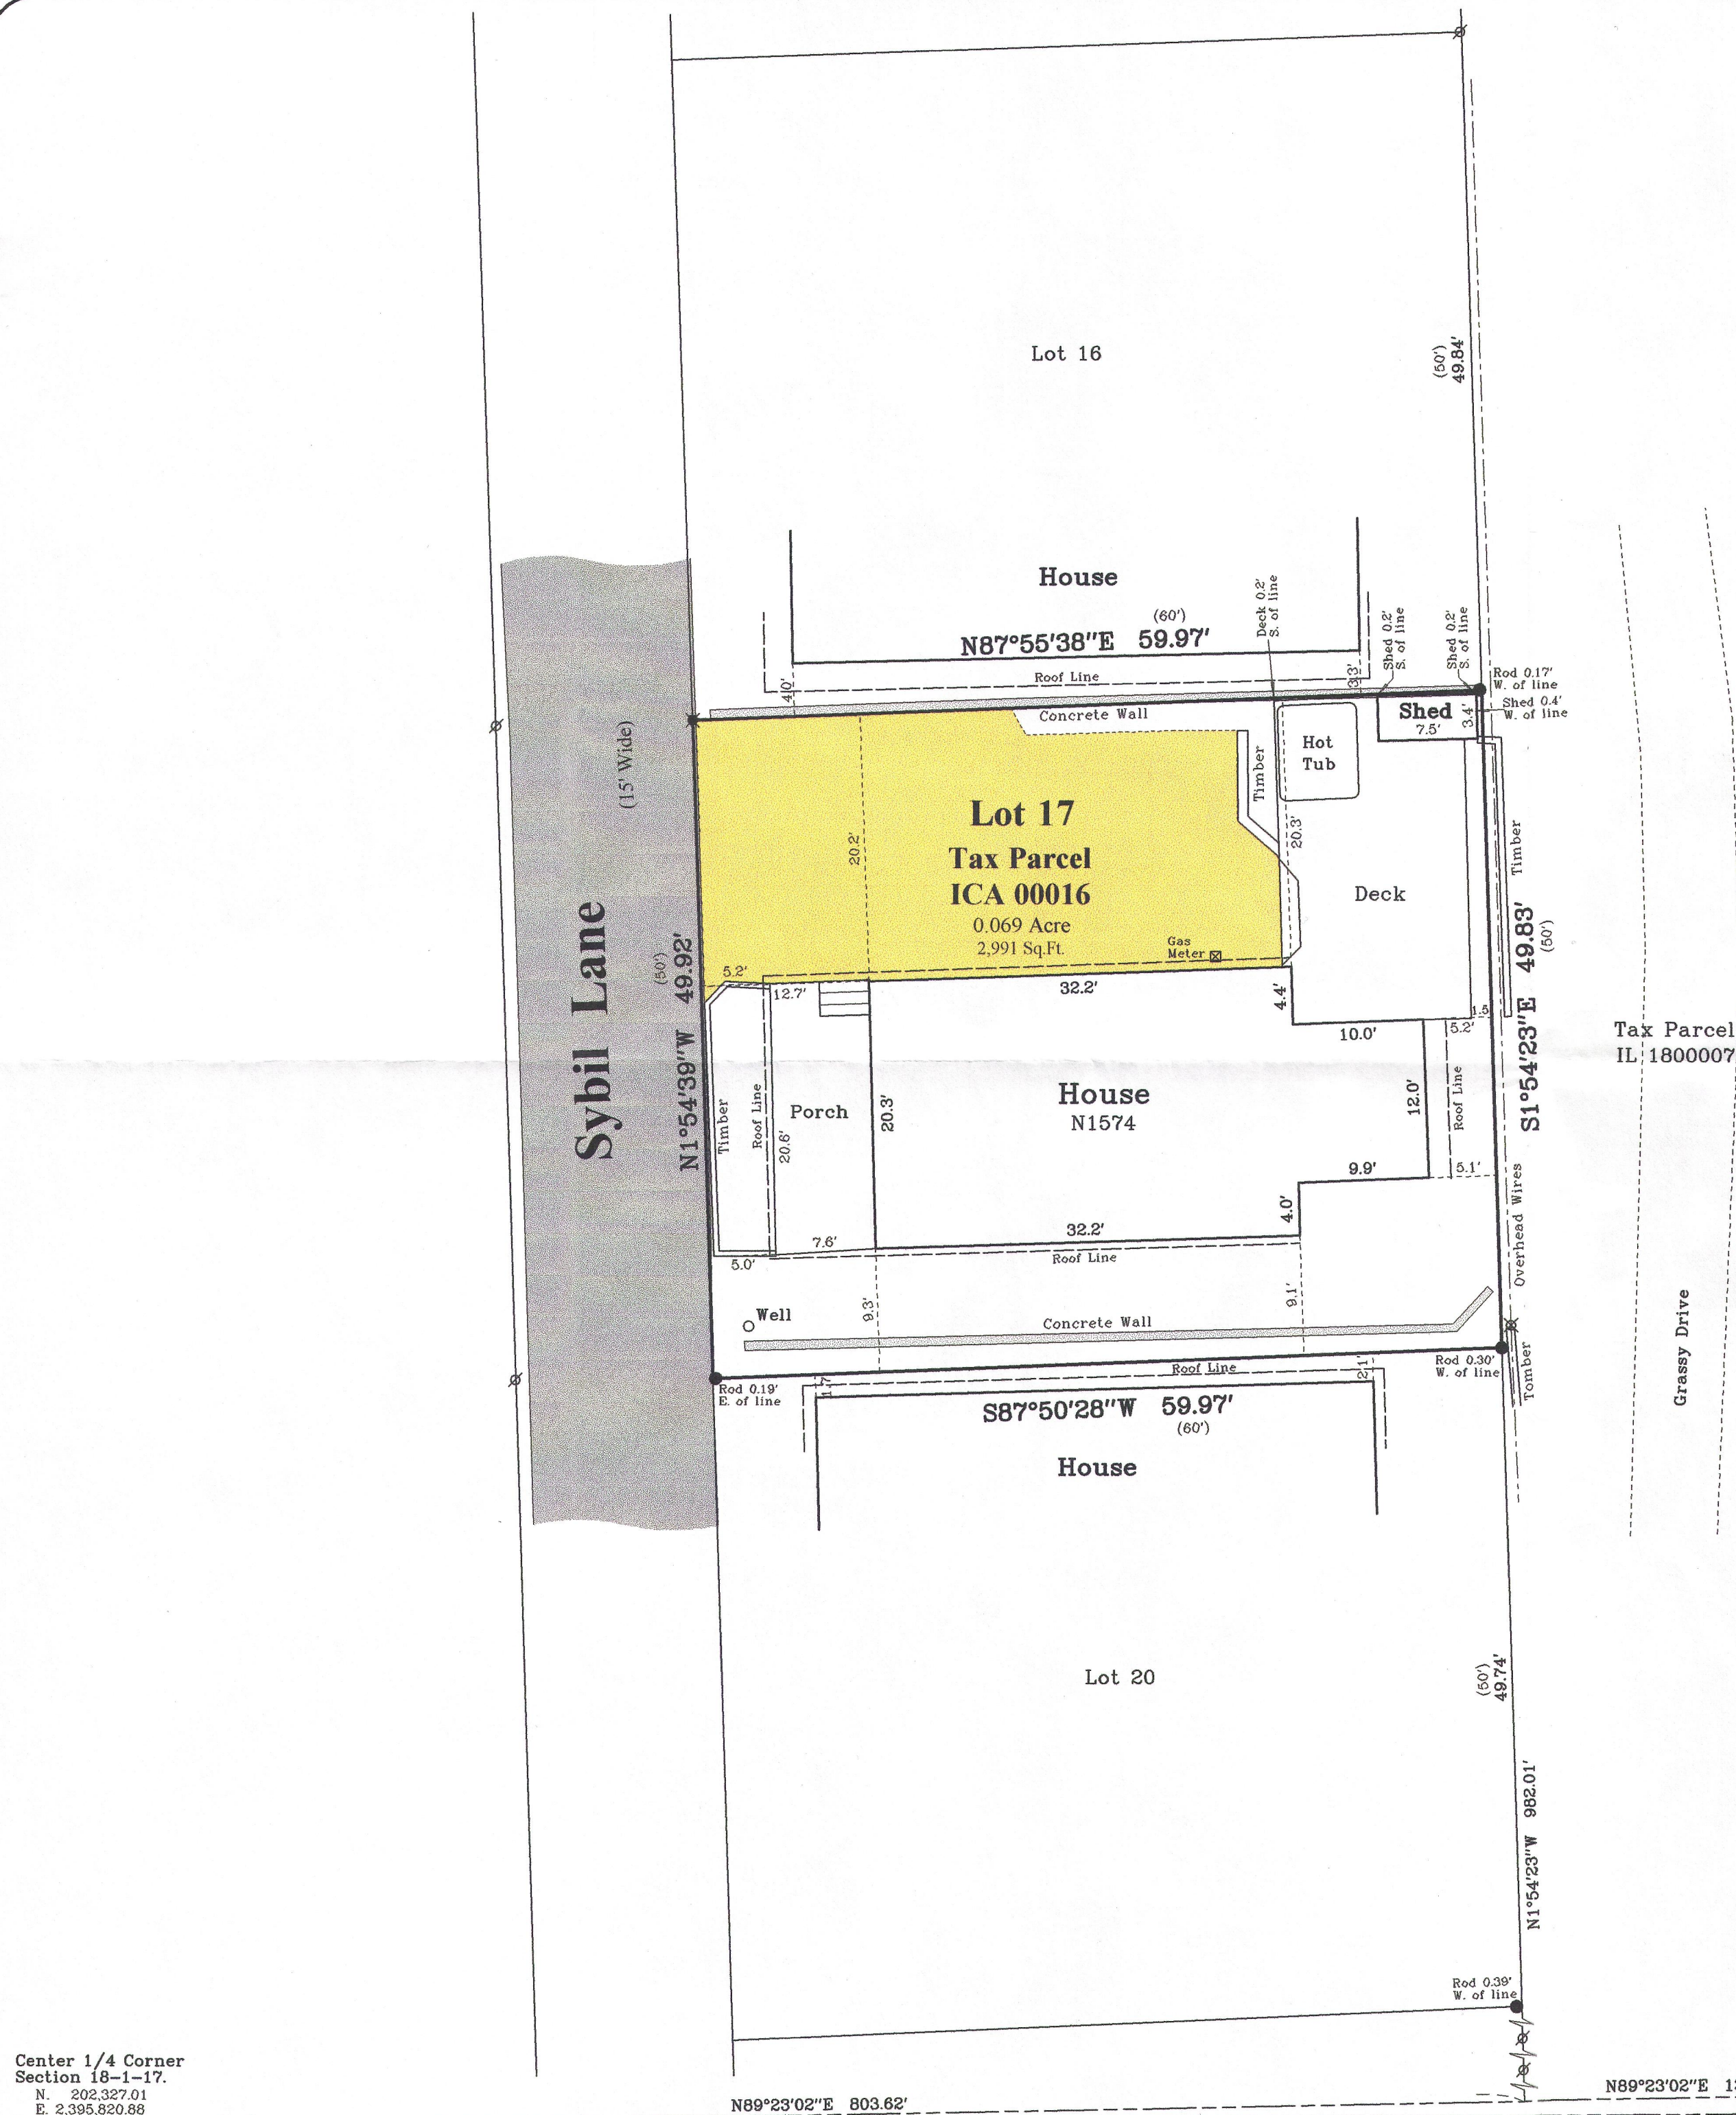

Plat of Survey

of


Lot 17 of Camp Sybil,

a subdivision located in the Northeast 1/4 of Section 18, Town 1 North,
Range 17 East, Town of Linn, Walworth County, Wisconsin.


Surveyed for:

Cheri Moloznik

9 Sun Valley Court
Lake in the Hills, Illinois. 60102

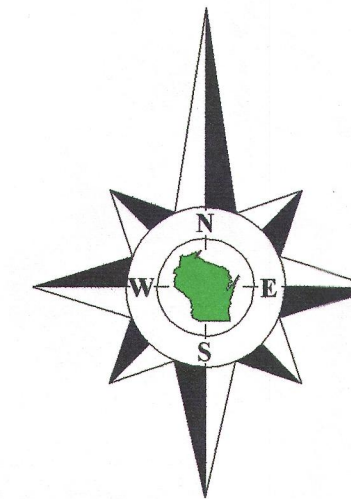

Bearings reference to the Wisconsin State
Plane Coordinate System, South Zone.

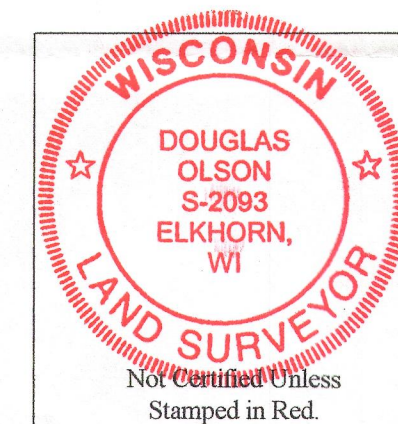


Notes:

- 1) This survey plat is not certified unless signed and sealed in red ink.
- 2) This survey is subject to Wisconsin lien laws. This Plat of Survey is the notice of intent to file lien. Lien waiver required.

Copyright 2012 by Jensen & Olson Land Surveying, LLC.

All rights reserved. No part of this survey plat may be reproduced or transmitted in any form by any means - graphic, electronic, or mechanical, including photocopying, tracing, or information storage and retrieval systems - without permission in writing from Douglas G. Olson, Jensen & Olson Land Surveying, LLC.

I, Douglas G. Olson, Wisconsin Registered Land Surveyor, do hereby certify that this survey was performed by me, or under my direction in full compliance with the owner's/agent's instructions and Chapter A-E 7 of the Wisconsin Administrative Code "Minimum Standards for Property Surveys"; and that this map is an accurate representation thereof to the best of my knowledge and belief.

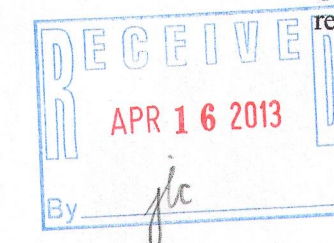


Douglas G. Olson
Wisconsin Registered Land Surveyor - 2093

South 1/8 Corner of
the Northeast 1/4 of
Section 18-1-17.

East 1/4 Corner
Section 18-1-17.
N. 202.349.48
E. 2,398,457.54

N89°30'42"E 2636.77'
(N89°30'42"E 2636.77') State Plane

Survey Date: Sept. 14, 2012.
Revisions:

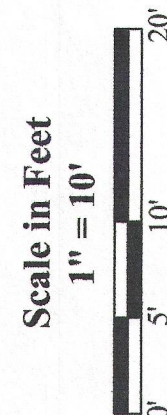

Jensen & Olson Land Surveying, LLC

45 South Wisconsin Street * P.O. Box 322 * Elkhorn, Wisconsin. 53121
Telephone: (262) 723-3434 * Facsimile: (262) 723-8044
Email: jensen.olson@elknet.net

Legend

- Found County Section Corner
- Found Iron Pipe
- Found Iron Rod
- Set Mag Nail
- Recorded Information
- Utility Pole
- Asphalt Surface
- Concrete Surface
- Gravel

Sheet 1 of 1 Sheets

Drawing Name: t1r17e-2012106-2012106Plat.scf

Job Reference Number
2012.106

2012.106

ICA 00016 117-3 524