
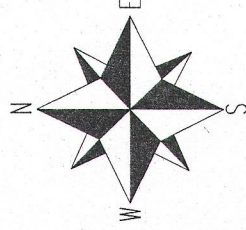
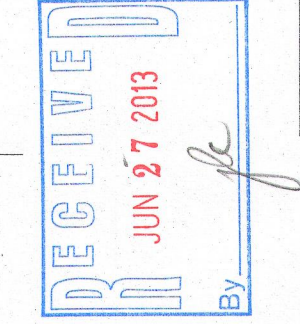


KROTT SURVEYING INC.

N3705 WILLOW BEND LANE  
LAKE GENEVA WI. 53147  
PHONE # (262) 248-3697  
FAX # (262) 249-0639

-OF-

LOT 31 AND THE NORTH 5 FEET OF LOT 33 OF LAKE GENEVA CLUB, A SUBDIVISION OF SECTION 18, TOWN 1 NORTH, RANGE 17 EAST, TOWN OF LINN, WALWORTH COUNTY, WISCONSIN

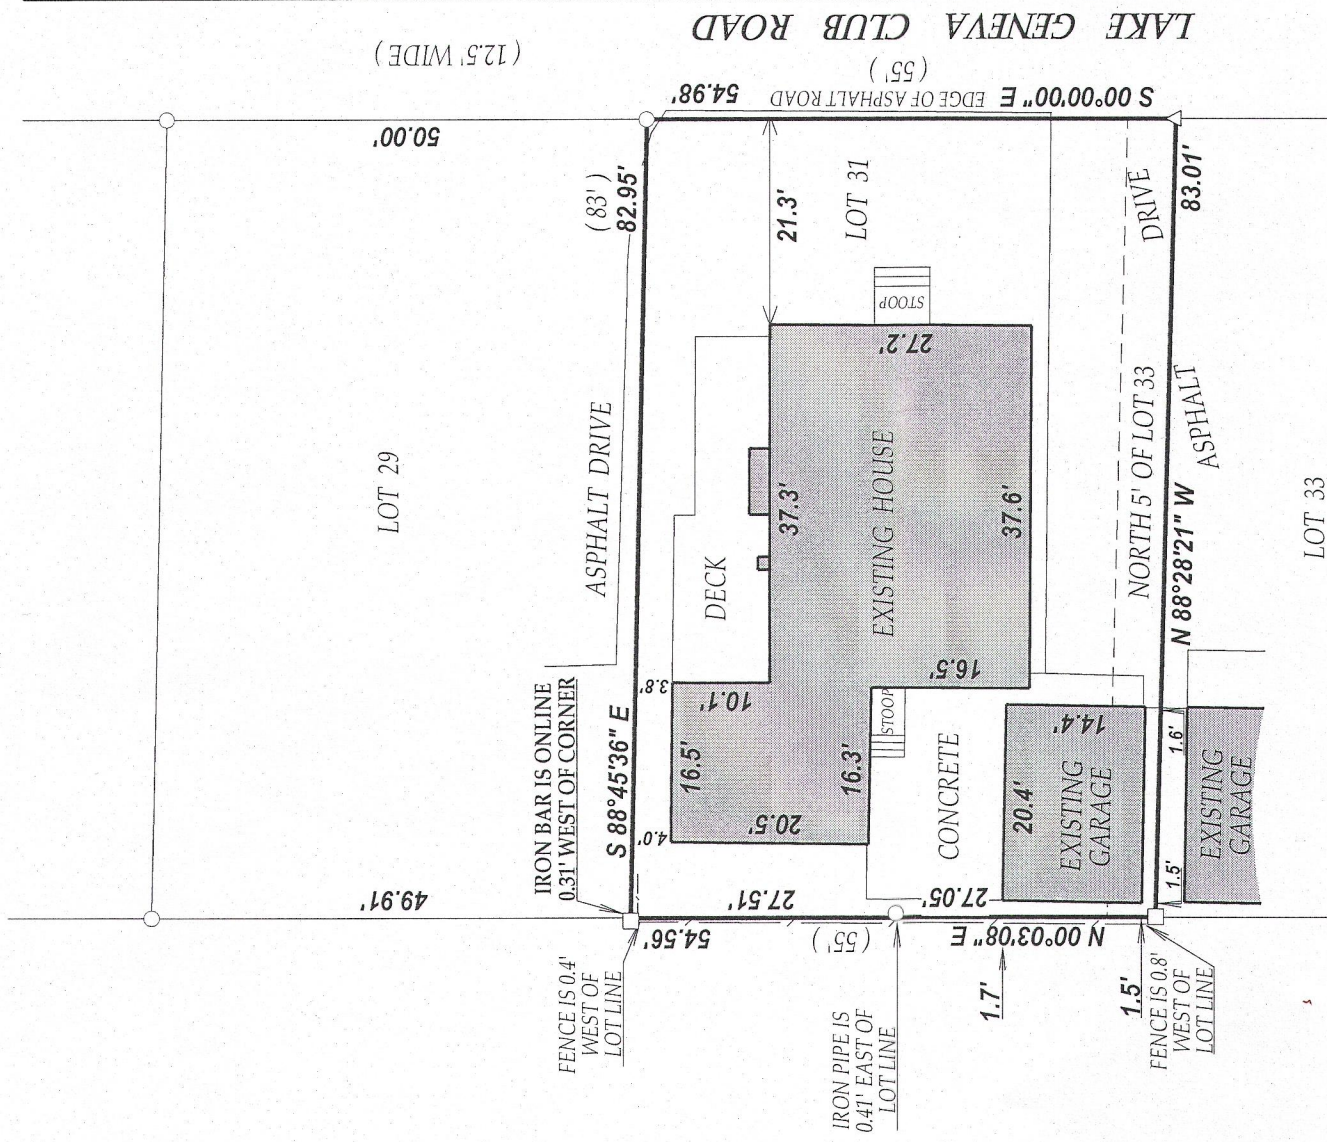

**SCALE 1" = 20'**

## LEGEND

- FOUND IRON PIPE  
□ FOUND IRON BAR  
△ FOUND MAG NAIL

NOTE: BEARINGS ARE REFERENCED TO PREVIOUS SURVEY RECORDS


*I have surveyed the above-described property and the above map is a true representation thereof and shows the size and location of the property, its exterior boundaries, the location and dimensions of all structures thereon, fences apparent easements and roadways and visible encroachments, if any.*

(XX) RECORDED AS

*This survey is made for the exclusive use of the present owners of the property, and also those who purchase, mortgage or insure the title thereto within one (1) year from date hereof; and as to them I warrant the accuracy of said survey map.*

TAX ID # ILGC00029

JOB # 13-075

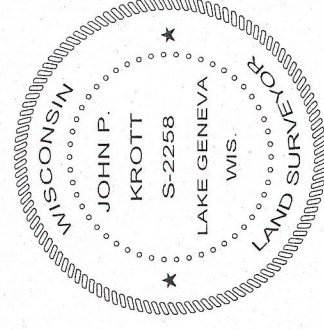

DATED THIS 31st DAY OF MAY 2013

John C. Beck

JOHN KROTT S - 2258  
Wisconsin Registered Land Surveyor  
(original if signed in red)

117-3535