

PREPARED FOR

KENT APINSKI

SHOREWEST REALTORS

623 MAIN STREET

LAKE GENEVA WL 53147

PLAT OF SURVEY

-OF-

LOT 4 IN BLOCK "F" IN CISCO BEACH, A SUBDIVISION IN SECTION 5,
TOWN 1 NORTH, RANGE 17 EAST, TOWN OF LINN, WALWORTH
COUNTY, WISCONSIN.


KROTT SURVEYING INC.

N3705 WILLOW BEND LANE

LAKE GENEVA WI. 53147

FAX # (262) 249-0639

C.L. CRESCENT ROAD
(50' WIDE)

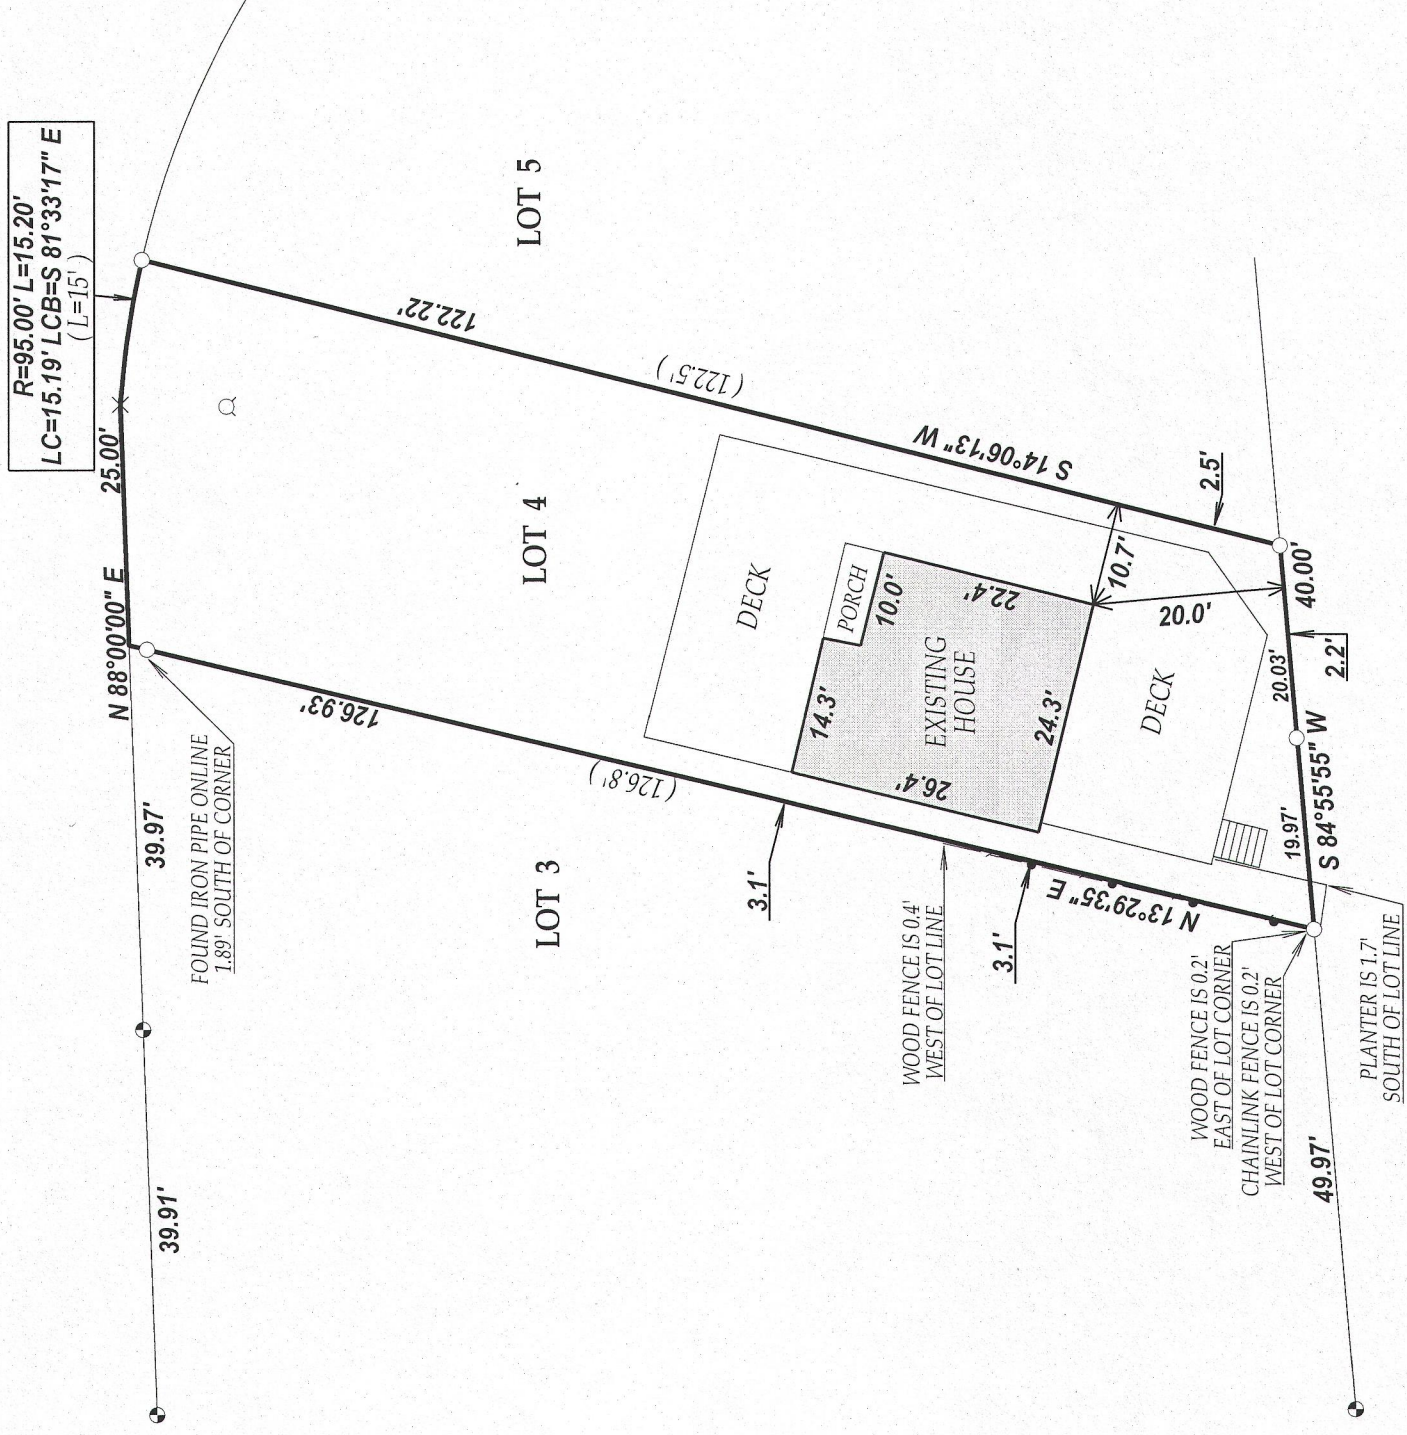

LEGEND


- FOUND IRON PIPE
□ FOUND IRON BAR
● FOUND CONCRETE MONUMENT
× CUT CROSS IN CONCRETE

Q. WELL

(XX) RECORDED AS

TAX ID# IC100108

IOB # 13-021

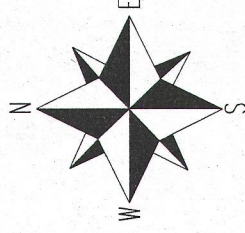

SCALE 1" = 20'



I have surveyed the above-described property and the above map is a true representation thereof and shows the size and location of the property, its exterior boundaries, the location and dimensions of all structures thereon, fences apparent easements and roadways and visible encroachments, if any.

This survey is made for the exclusive use of the present owners of the property, and also those who purchase, mortgage or insure the title thereto within one (1) year from date hereof; and as to them I warrant the accuracy of said survey map.

DATED THIS 13th DAY OF FEBRUARY 2013

JOHN KROTT S - 2258
Wisconsin Registered Land Surveyor
(original if signed in red)

117-3539