

PREPARED FOR:
NANCY EVANS
512 N KNIGHT AVE
PARK RIDGE IL. 60068

PLAT OF SURVEY



-OF-

PATHFINDER SURVEYING INC.
(formerly)
J.K. SURVEYING INC.
P.O BOX 322
LAKE GENEVA, WI. 53147
WWW.PATHFINDERSURVEYING.NET
262-248-8303

LOT 30 LAKE GENEVA HIGHLANDS, A SUBDIVISION BY TAYLOR AND POWERS OF THE EAST 1/3, EXCEPT THE EAST 100 FEET OF THE NORTH 1/2 OF THE SE FRACTIONAL 1/4 OF SECTION 8, TOWN 1 NORTH, RANGE 17 EAST OF THE FOURTH PRINCIPAL MERIDIAN, ALL IN WALWORTH COUNTY AND THE STATE OF WISCONSIN.

LAKEVIEW ROAD

(platted as 50' wide)

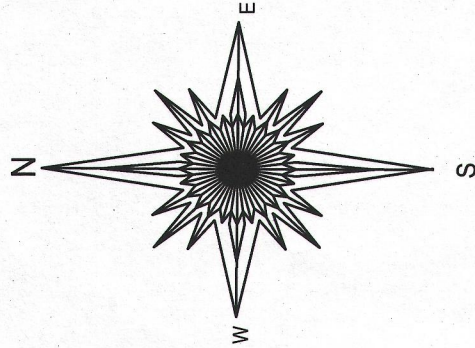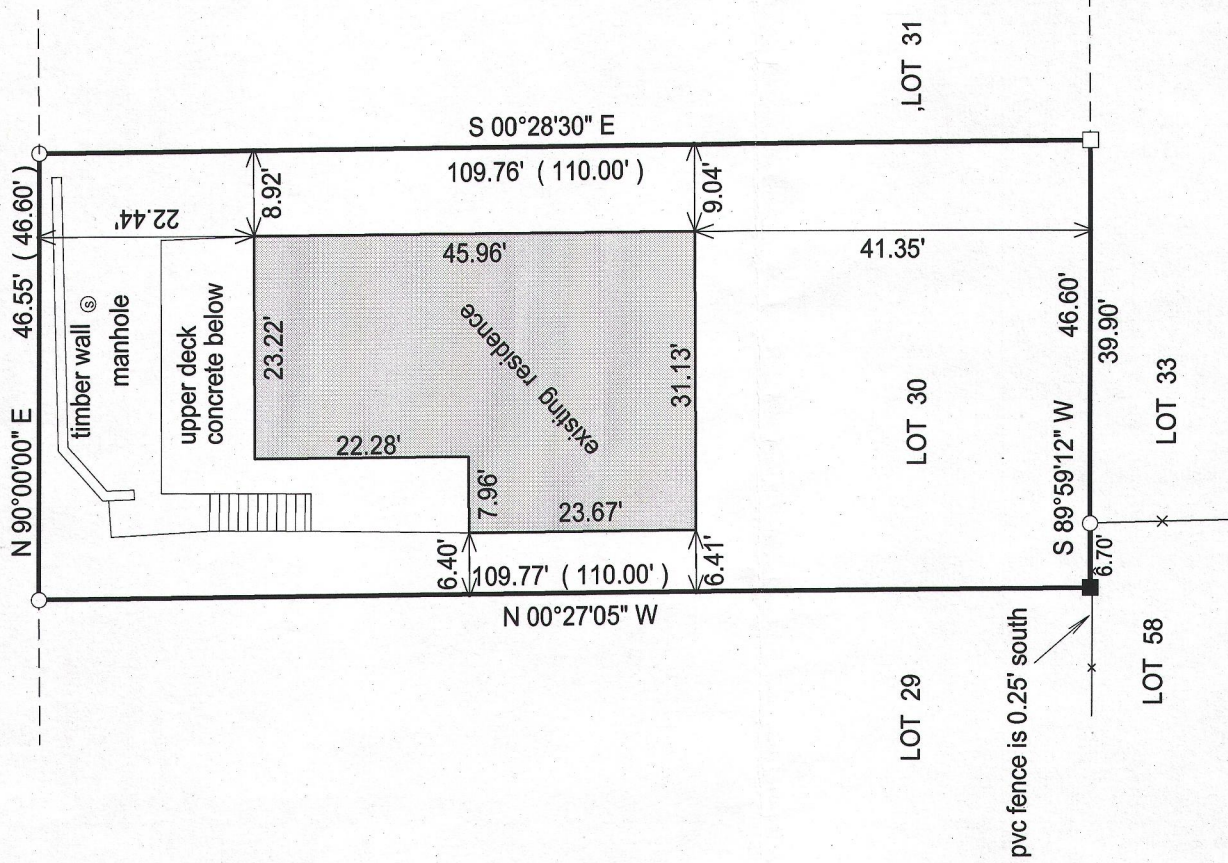

- () = RECORDED AS
- = FOUND IRON BAR
- = FOUND IRON PIPE
- = SET IRON PIPE
- = SET IRON BAR

SCALE: 1" = 20'

JOB #: 13-24


TAX ID #: ILGH 00029



20	0	20	40	60

BASIS OF BEARING OF THIS PLAT: THE SOUTH LINE OF LAKEVIEW ROAD WAS ASSUMED TO BEAR EAST / WEST.

"I hereby certify that the above described property was surveyed under my supervision and that the above map, to the best of my knowledge and belief, is a true representation thereof and shows the size and location of all visible structures, apparent easements and encroachments if any." This survey is made for the present owners of the property, and those who purchase, mortgage, or guarantee the title thereto, within one year from the date hereof.

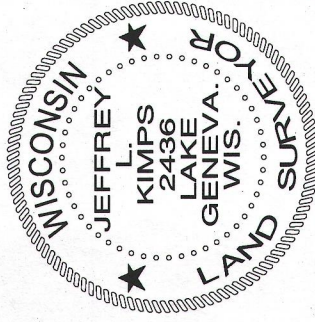

JEFFREY L. KIMPS S-2436
Wisconsin Registered Land Surveyor
(original if signed in red)

DATED TH IS 27TH DAY OF MARCH, 2013.

ILGH -29

117-3540