

FOR: JOHN V. AND KATHLEEN M. AMATO
LEGAL DESCRIPTIONS:



(Per Title Policy 439082 date March 17, 2011 from Chicago Title Company)
Lots 2 and 3 in Block 6 in Lawrence's Addition to Genevista in the South West 1/4 of the South West 1/4 of Section 10, T1N, R17E, in the County of Walworth, State of Wisconsin.
Tax Key No: IGV. 00028 and IGV. 00029.

(Per Title Policy 000447169 date April 1, 2013 from Chicago Title Company)
Lots 4 and 5 in Block 6 in Lawrence's Addition to Genevista in the South West 1/4 of the South West 1/4 of Section 10, T1N, R17E, in the County of Walworth, State of Wisconsin.
Tax Key No: IGL 00030.

• - Iron pipes found or set as part of the survey.


REFERENCE BEARING: All bearing are referenced to grid north of the Wisconsin State Coordinate System south Zone, wherein the South Line of the Southwest 1/4 of Section 10-1-17 was taken to bear North 88° 21' 35" East.

NOTE:
Shed encroachment on west line of Lot-2 Block-6 as shown.

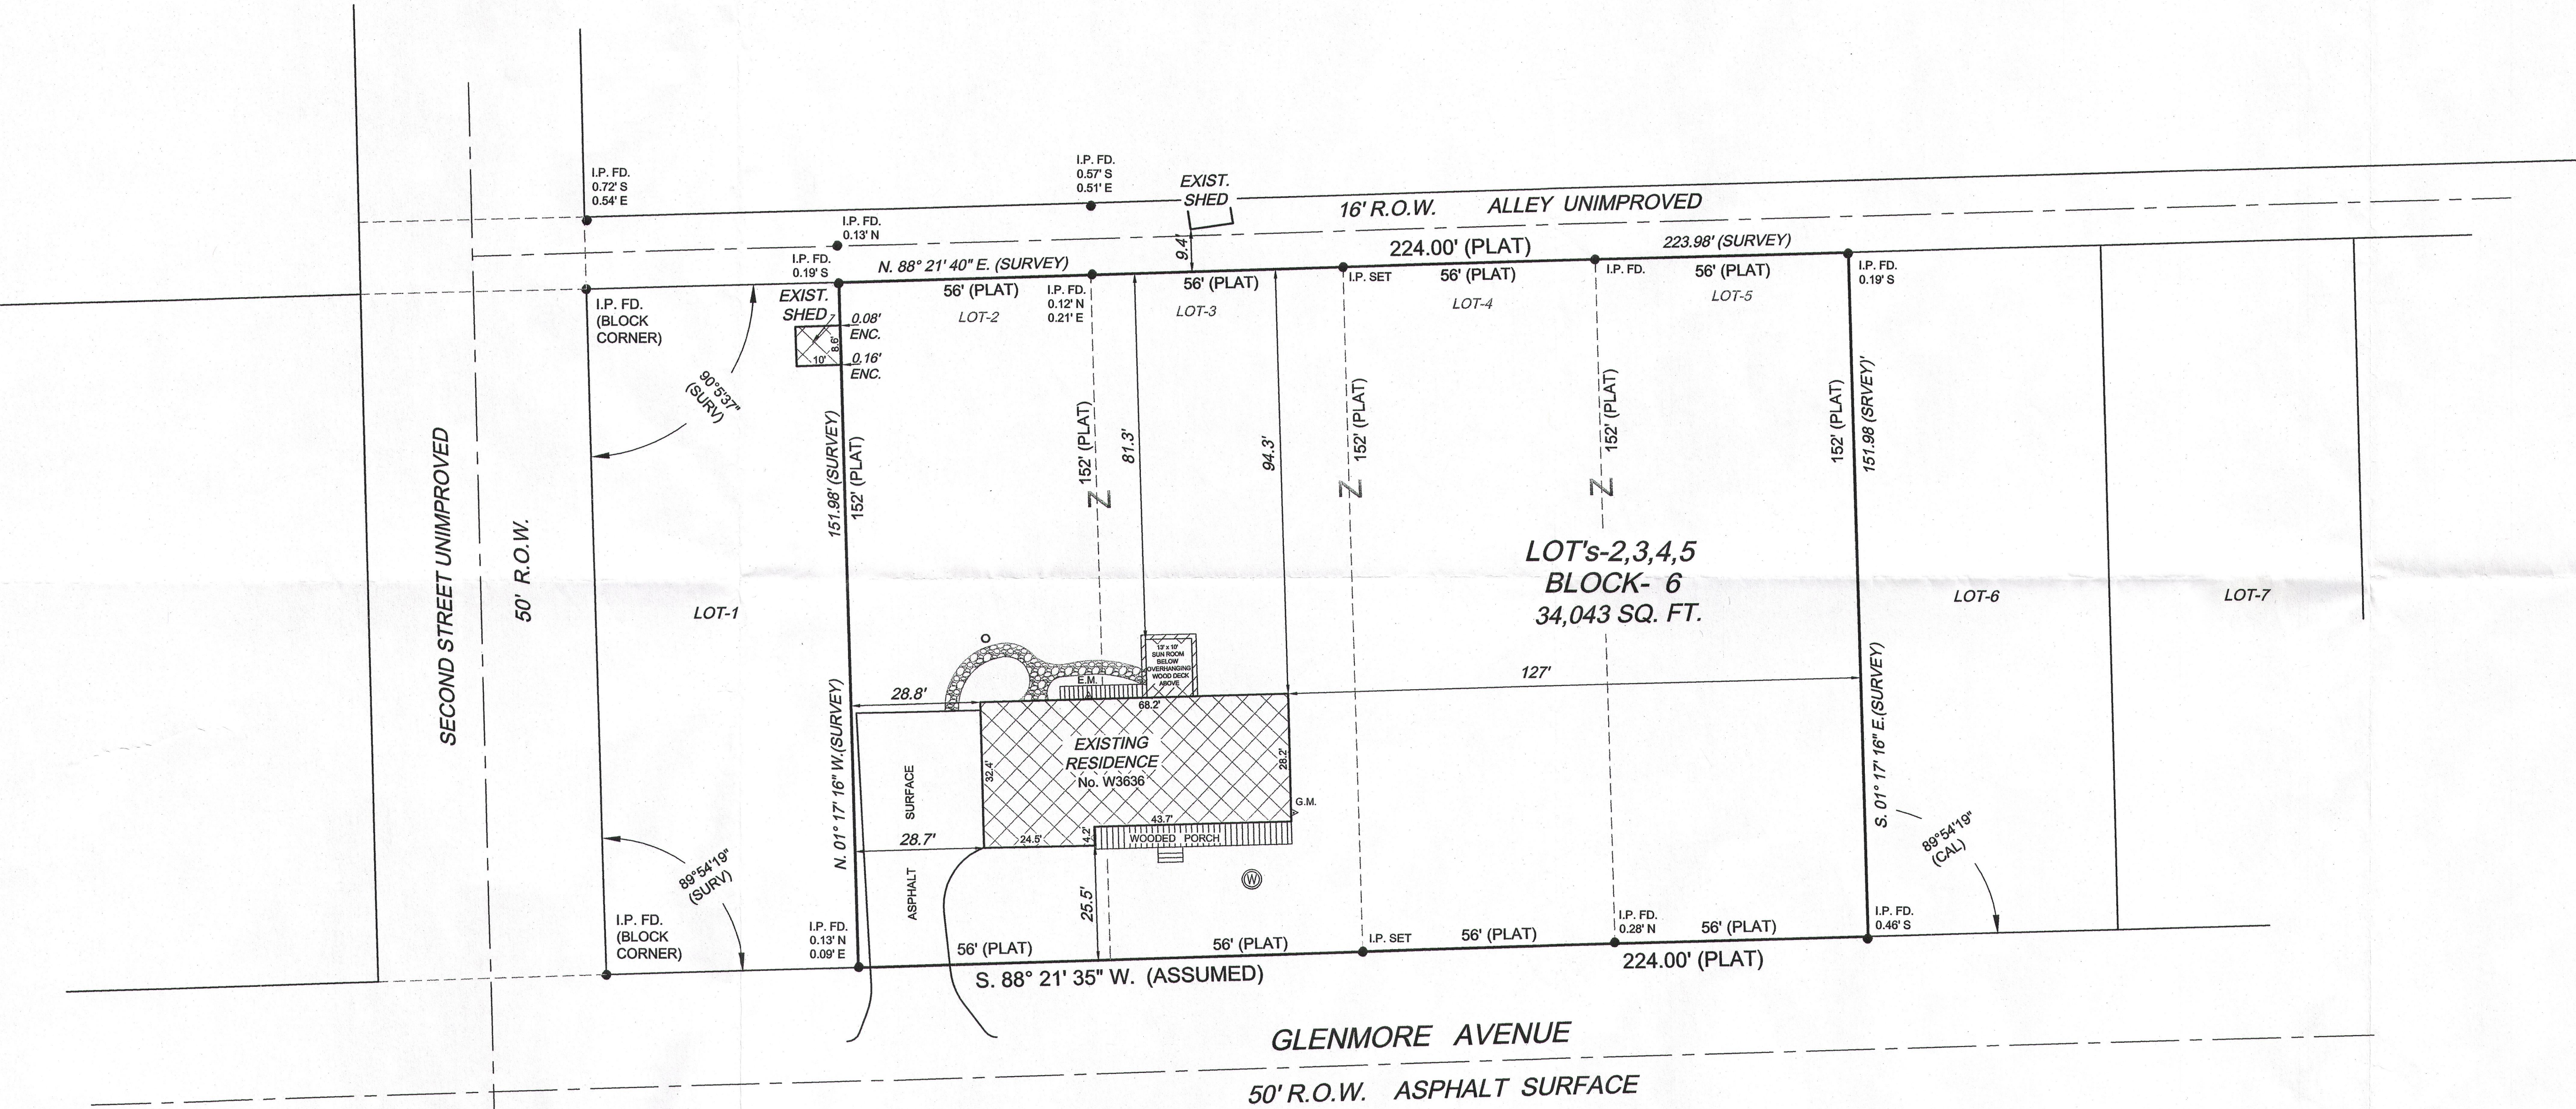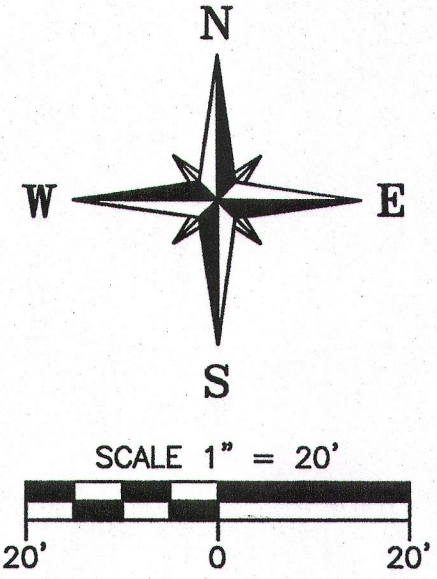

LEGEND

- (PLAT) PLATTED DISTANCE
(SURVEY) SURVEYED ANGLE, DISTANCE AND OR BEARING
○ SEPTIC VENT
△ E.M. ELECTRIC METER
G.M. GAS METER
⊙ WELL

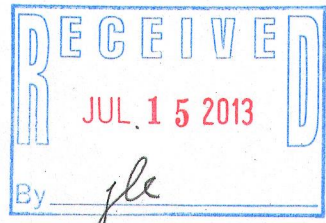

STATE OF WISCONSIN
COUNTY OF WAUKESHA
We Jahnke & Jahnke Associates Inc. do hereby certify that we have made this survey and that the information as shown on the above Plat of Survey is a true and correct representation thereof.

JOHN W. JAHNKE - Wis. Reg. No. S-917

If this seal is not red in color, this plan is a copy that should be assumed to contain unauthorized alterations. The certification contained on this document shall not apply to any copies.

PLAT OF SURVEY FOR: JOHN AND KATHY AMATO LOT'S 2-5, BLOCK-6 LAWRENCE'S ADDITION TO GENEVISTA TOWN OF LINN, WALWORTH COUNTY, WISCONSIN	
JAHNKE & JAHNKE ASSOCIATES INC. PLANNERS & PROFESSIONAL ENGINEERS 711 W. MORELAND BLVD.-WAUKESHA, WI 53188 TEL.No.(262) 542-5797 FAX (262) 542-7698 (E-MAIL pmuehl@jahnkeandjahnke.com)	
SCALE: 1"=20'	DATE: APRIL 19, 2013
DRAWN BY: P.M.	CHECKED BY: J.W.J.
BOOK NO.: WALWORTH 13 pg 13	FILE NO.: WALWORTH-102
IGVL - 28	117-3545