
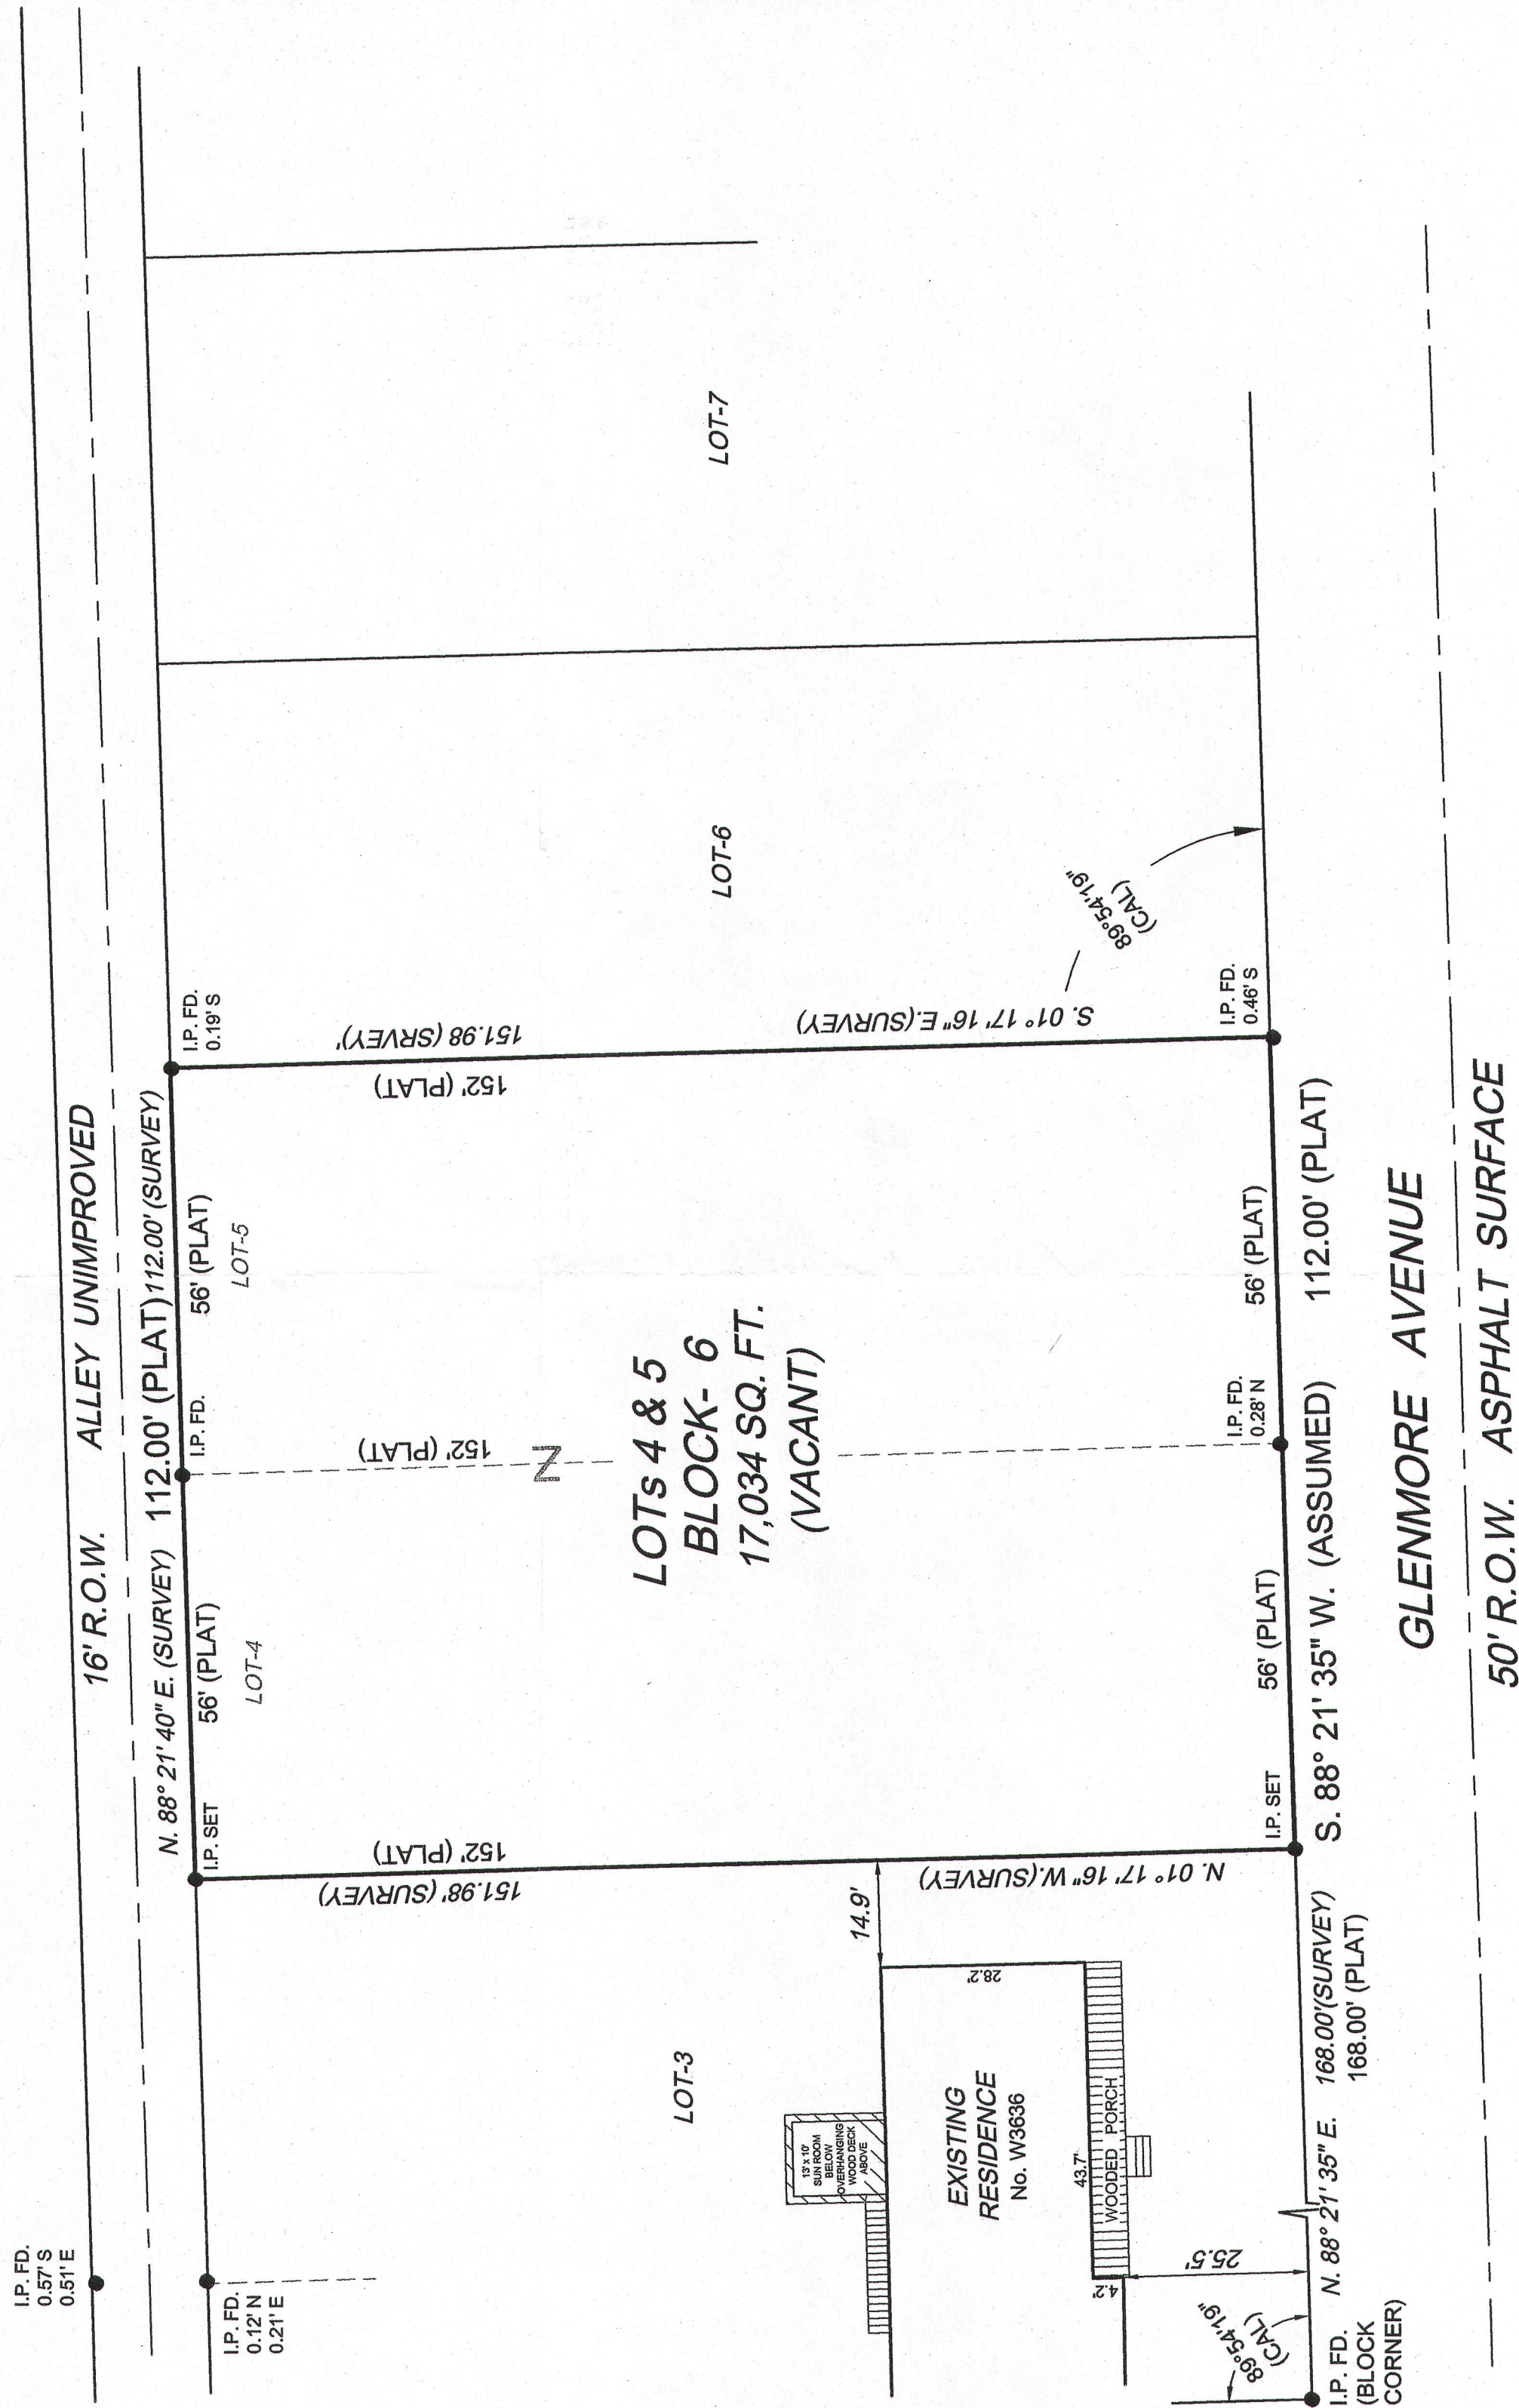


FOR: JOHN V. AND KATHLEEN M. AMATO
LEGAL DESCRIPTIONS:

(Per Title Policy 000447169 date April 1, 2013 from Chicago Title Company)
Lots 4 and 5 in Block 6 in Lawrence's Addition to Genevista in the South West 1/4 of the South West 1/4 of Section 10, T1N, R17E, in the County of Walworth, State of Wisconsin.
Tax Key No: IGL 00030.

● - Iron pipes found or set as part of the survey.

REFERENCE BEARING: All bearing are referenced to grid north of the Wisconsin State Coordinate System south Zone, wherein the South Line of the Southwest 1/4 of Section 10-1-17 was taken to bear North 88° 21' 35" East.

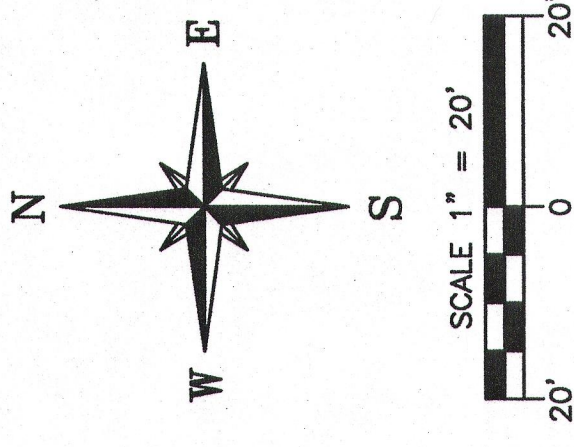

LEGEND

(PLAT) PLATTED DISTANCE

(SURVEY) SURVEYED ANGLE, DISTANCE AND OR BEARING

STATE OF WISCONSIN
COUNTY OF WAUKESHA
We Jahnke & Jahnke Associates Inc. do hereby certify that we have made this survey and that the information as shown on the above Plat of Survey is a true and correct representation thereof.

JOHN W. JAHNKE - Wis. Reg. No. S-917

PLAT OF SURVEY
FOR: JOHN AND KATHY AMATO
LOTS 4 & 5, BLOCK-6 LAWRENCE'S ADDITION TO GENEVISTA
TOWN OF LINN, WALWORTH COUNTY, WISCONSIN

JAHNKE & JAHNKE ASSOCIATES INC.

PLANNERS & PROFESSIONAL ENGINEERS
711 W. MORELAND BLVD.-WAUKESHA, WI 53188
TEL No. (262) 542-5787 FAX (262) 542-7688 (E-MAIL pmuehl@jahnkeandjahnke.com)

SCALE: 1"=20' DATE: APRIL 19, 2013
DRAWN BY: P.M. CHECKED BY: J.W.J. FILE NO.: WALWORTH-102-LOTS 4 & 5
BOOK NO.: WALWORTH 13 pg 13 SHEET 1 OF 1



If this seal is not red in color, this plan is a copy that should be assumed to contain unauthorized alterations. The certification contained on this document shall not apply to any copies.