


FARRIS, HANSEN & ASSOC. INC.

7 RIDGWAY COURT- P.O. BOX 437
ELKHORN, WISCONSIN 53121
PHONE (262) 723-2098
FAX (262) 723-5886


PLAT OF SURVEY
LOTS 45 & 47 OF LAKE GENEVA CLUB, A SUBDIVISION
LOCATED IN THE SE 1/4 OF THE NW 1/4 SECT. 18
TOWN 1 NORTH, RANGE 17 EAST
WALWORTH COUNTY, WI.

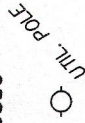

Lots 45 and 47 of Lake Geneva Club, a subdivision in Section 18, T1N, R17E, lying and being in the Town of Linn, Walworth County, Wisconsin, the plat thereof being recorded in the office of the Register of Deeds for Walworth County, Wisconsin.

Tax Key No: ILGC 00039

ORDERED BY: GENEVA LAKEFRONT REALTY
49 WEST GENEVA STREET
WILLIAMS BAY, WI. 53191

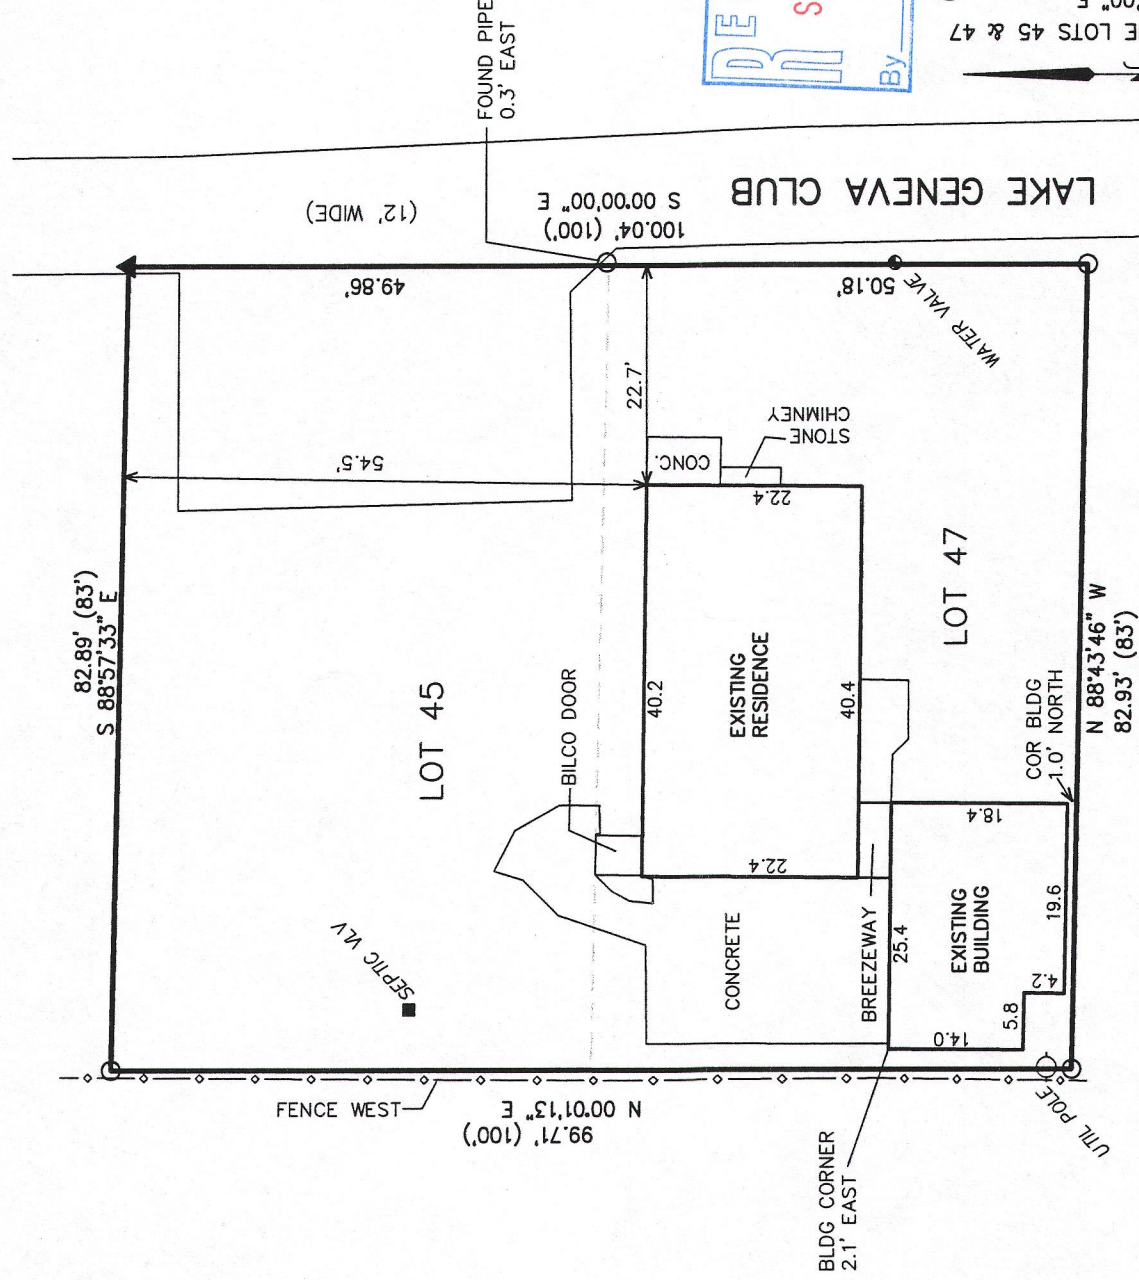

LEGEND

- = FOUND IRON PIPE STAKE
- ▲ = SET MAG NAIL IN PAVEMENT (METAL DETECTED BELOW)
- (XXX) = RECORDED AS



OVERALL AREA = 8280 S.F.

NOTE: COPIES OF THIS MAP TO WHICH THE FOLLOWING CERTIFICATE WILL APPLY SHOW THE SURVEYOR'S ORIGINAL SEAL AND SIGNATURE IN RED INK. COPIES BY ANY OTHER MEANS MAY HAVE ALTERATIONS WHICH DO NOT REPRESENT THE SURVEYOR'S WORK PRODUCT.


I HEREBY CERTIFY THAT THE ABOVE DESCRIBED PROPERTY HAS BEEN SURVEYED UNDER MY DIRECTION AND THAT THE ABOVE MAP IS A TRUE REPRESENTATION THEREOF AND SHOWS THE SIZE AND LOCATION OF THE PROPERTY, ITS EXTERIOR BOUNDARIES, THE LOCATION OF ALL VISIBLE STRUCTURES, AND DIMENSIONS OF ALL PRINCIPLE BUILDINGS THEREON, BOUNDARY FENCES, APPARENT EASEMENTS, ROADWAYS, AND VISIBLE ENCROACHMENTS, IF ANY. THIS SURVEY IS MADE FOR THE USE OF THE PRESENT OWNERS OF THE PROPERTY, AND ALSO THOSE WHO PURCHASE, MORTGAGE, OR GUARANTEE THE TITLE THERETO WITHIN ONE YEAR FROM THE DATE HEREOF.

DATED: JULY 26, 2013

PETER S. GORDON

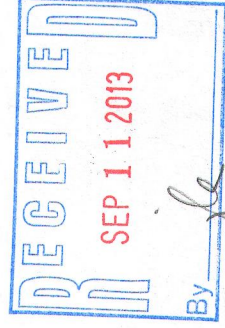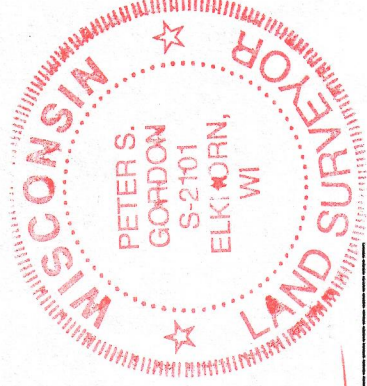

ASSIGNED EAST LINE LOTS 45 & 47
S 00°00'00\"/>

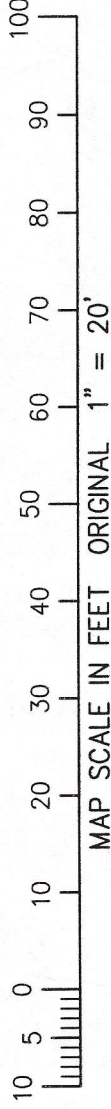

PROJECT NO. 8854
DATED: 07-26-2013
SHEET 1 OF 1 SHEETS

JUL 29 2013

ILGC -39

117-3554