


of
Lot 14 of Camp Sybil,

Surveyed for: **Peter Bazos**
1112 Crane Drive
Sleepy Hollow, Illinois. 60118

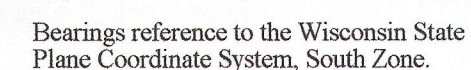

- 1) This survey plat is not certified unless signed and sealed in red ink.
- 2) This survey is subject to Wisconsin lien laws. This Plat of Survey is the notice of intent to file lien. Lien waiver required.

Copyright 2012 by Jensen & Olson Land Surveying, LLC.

All rights reserved. No part of this survey plat may be reproduced or transmitted in any form by any means - graphic, electronic, or mechanical, including photocopying, tracing, or information storage and retrieval systems - without permission in writing from Douglas G. Olson, Jensen & Olson Land Surveying, LLC.

I, Douglas G. Olson, Wisconsin Registered Land Surveyor, do hereby certify that this survey was performed by me, or under my direction in full compliance with the owner's/agent's instructions and Chapter A-E 7 of the Wisconsin Administrative Code "Minimum Standards for Property Surveys"; and that this map is an accurate representation thereof to the best of my knowledge and belief.

Douglas G. Olson
Wisconsin Registered Land Surveyor - 2093

South 1/8 Corner of
the Northeast 1/4 of
Section 18-1-17.

N89°30'42"E 2636.77'
(N89°30'42"E 2636.77') State Plane

East 1/4 Corner
Section 18-1-17.
N. 202,349.48
E. 2,398,457.54

Survey Date: Sept. 14, 2012.
Revisions: No. 1 – Deck Under Construction

Scale in Feet
1" = 10'

Jensen & Olson Land Surveying, LLC

Wisconsin Street * P.O. Box 322 * Elkhorn, Wisconsin. 53121

(262) 723-3434 * Facsimile: (262) 723-8044
Email: jensen.olson@elknet.net

Legend

- Found County Section Corner
- Found Iron Pipe
- Found Iron Rod
- ✕ Set Chiseled Cross
-) Recorded Information
- Utility Pole
- ⊗ Utility Pedestal unless noted
- Asphalt Surface
- Concrete

Sheet 1 of 1 Sheets

Job Reference Number

2012.077

2012.077

117-3560