




PREPARED FOR
AKEMANN FAMILY TRUST
410 HOXIE CR.
ELGIN, IL. 60123-3220

PLAT OF SURVEY


- OF -

PATHFINDER SURVEYING INC.
(formerly)
J.K. SURVEYING INC.
P.O BOX 322
LAKE GENEVA, WI. 53147
WWW.PATHFINDERSURVEYING.NET
262-248-8303

LOT 4 AND LOT 5, EXCEPT THE SOUTHERLY 3 FEET LOF LOT 5,
CAMP SYBIL A SUBDIVISION LOCATED IN SECTION 18, TOWN 1
NORTH, RANGE 17 EAST, TOWN OF LINN, WALWORTH COUNTY,
WISCONSIN.

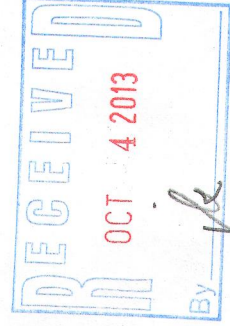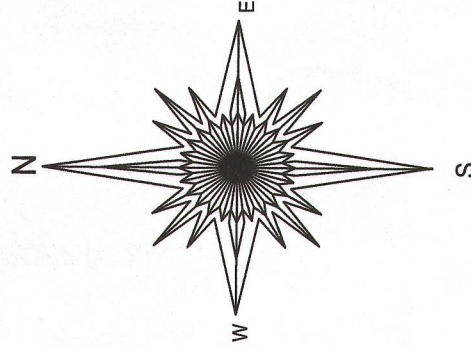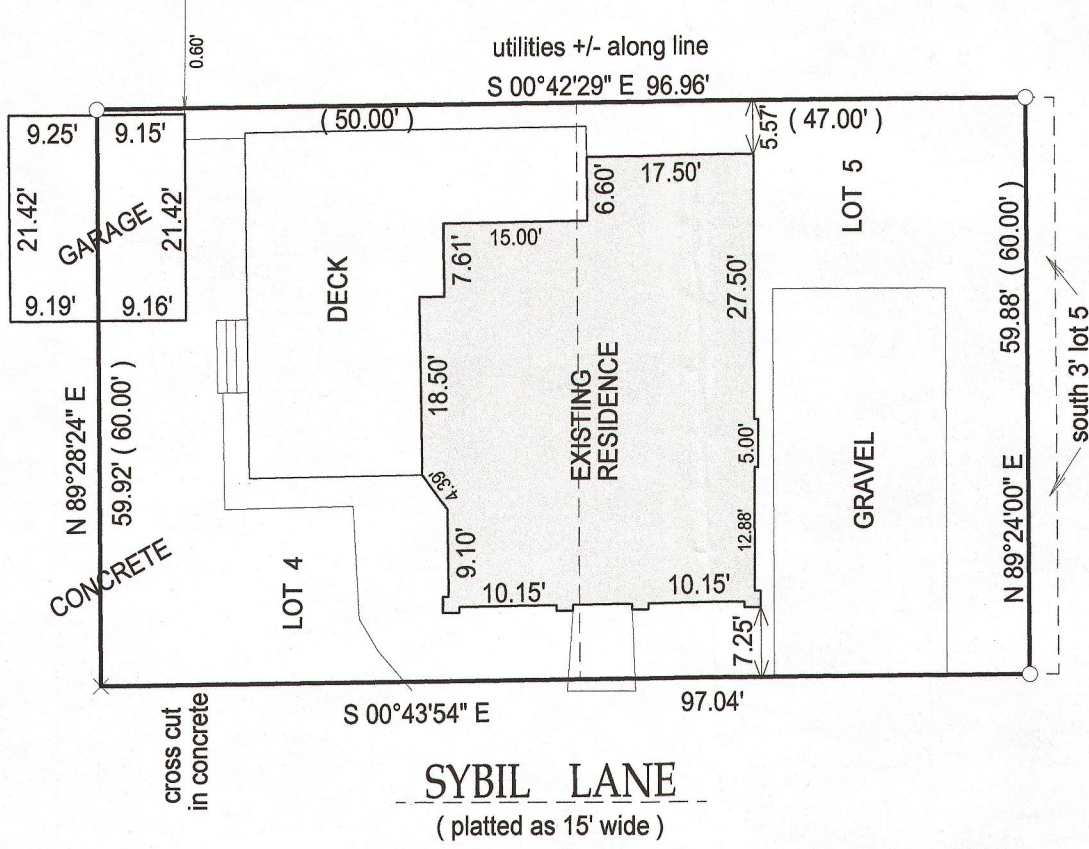

- () = recorded as
- = found iron bar
 - = found iron pipe
 - = set iron pipe
 - = set iron bar
- SCALE 1" = 20'

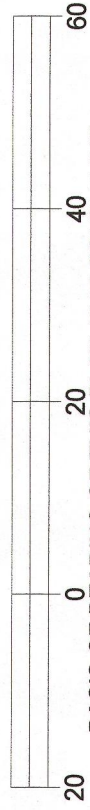

BASIS OF BEARING OF THIS PLAT: THE SOUTH LINE
OF THE PARCEL SURVEYED WAS ASSUMED TO BEAR
N 89°24' E.

I hereby certify that I have surveyed the above-described property and the above map is a true representation thereof and shows the size and location of the property, its exterior boundaries, the location and dimensions of all structures thereon, fences, apparent easements and roadways and visible encroachments if any.

JOB # 13-141

TAX ID # ICA00004

This survey is made for the present owners of the property, and those who purchase, mortgage, or guarantee the title thereto, within one year from the date hereof.

DATED THIS 20th day of August, 2013.

JEFFREY L KIMPS S-2436
Wisconsin Registered Land Surveyor
(original if signed in red)



117-3568