


PREPARED FOR
SCOTT ECKBURG
1728 NATIONAL AVE.
ROCKFORD IL 61103

PLAT OF SURVEY OF

LOT 66 IN ROBINSON'S SECOND SUBDIVISION OF A PART OF SECTIONS
11 AND 14, TOWN 1 NORTH, RANGE 17 EAST, BEING IN THE TOWN OF
LINN ACCORDING TO THE PLAT OF ROBINSON'S 2nd SUBDIVISION OF
RECORD IN THE OFFICE OF THE REGISTER OF DEEDS FOR WALWORTH
COUNTY, WISCONSIN.

KROTT SURVEYING INC.
(262) 248-3697
N 3705 WILLOW BEND LANE
LAKE GENEVA WI. 53147

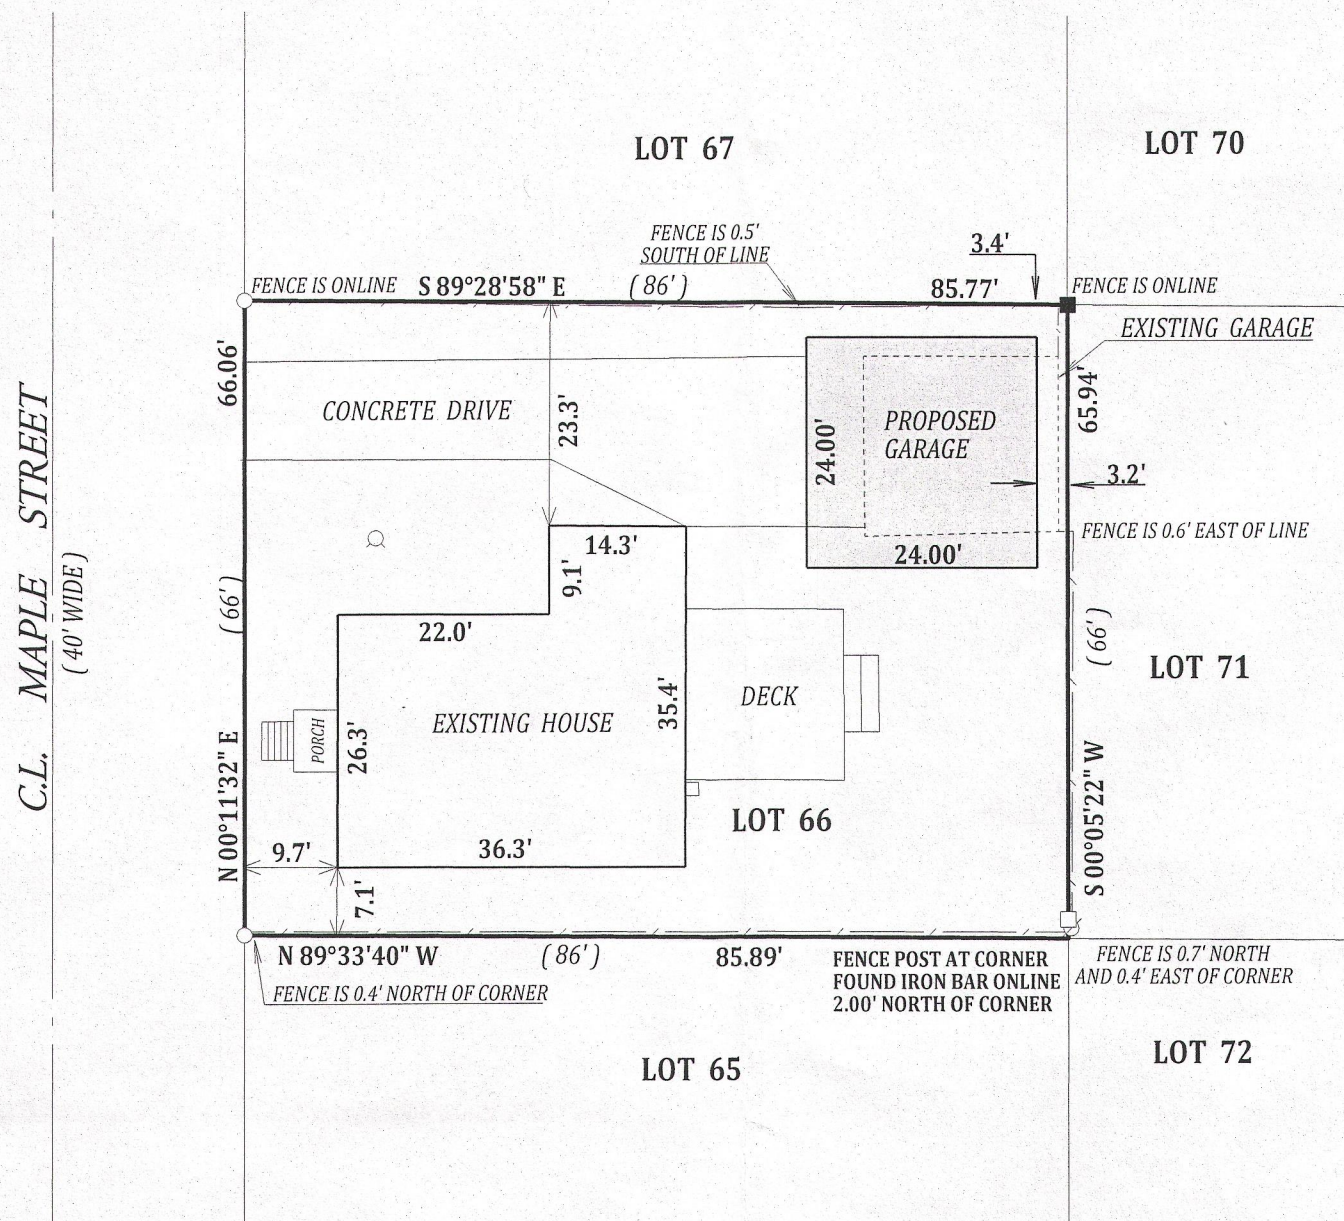



LEGEND

- FOUND IRON PIPE
- FOUND IRON BAR
- SET IRON BAR
- WELL
- ⊗ UTILITY POLE
- WOOD FENCE

(XX) RECORDED AS
TAX ID # IRB200050
JOB # 13-152

I have surveyed the above-described property and the above map is a true representation thereof and shows the size and location of the property, its exterior boundaries, the location and dimensions of all structures thereon, fences apparent easements and roadways and visible encroachments, if any.

This survey is made for the exclusive use of the present owners of the property, and also those who purchase, mortgage, or insure the title thereto within one (1) year from date hereof; and as to them I warrant the accuracy of said survey map.

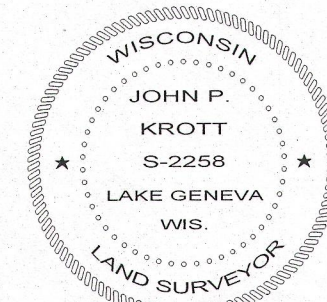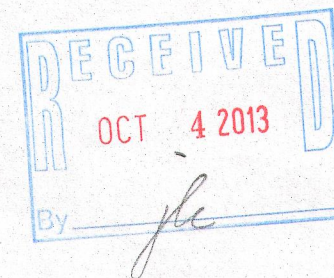

DATED THIS 2nd DAY OF OCTOBER 2013

John P. Krott

JOHN P. KROTT S-2258
WISCONSIN REGISTERED LAND SURVEYOR
(NOTE: THIS IS NOT A CERTIFIED COPY
UNLESS SIGNED IN RED INK)

117-3578