




PREPARED FOR:
CINDY MECUM
N1990 N. LAKE SHORE
FONTANA, WI 53125

PLAT OF SURVEY

KROTT SURVEYING INC.
N3705 WILLOW BEND LANE
LAKE GENEVA WI. 53147
PHONE # (262)248-3697
FAX # (262)249-0639

-OF-

LOT 2 WOODSTONE SUBDIVISION, A SUBDIVISION LOCATED IN THE NORTHWEST 1/4 OF THE
NORTHEAST 1/4 AND PART OF THE SOUTHWEST 1/4 AND SOUTHEAST 1/4 OF THE NORTHEAST
1/4 OF SECTION 16, TOWN 1 NORTH, RANGE 17 EAST OF THE FOURTH PRINCIPAL MERIDIAN,
LYING AND BEING IN THE TOWN OF LINN, COUNTY OF WAL WORTH, AND STATE OF
WISCONSIN.

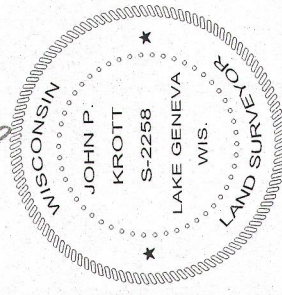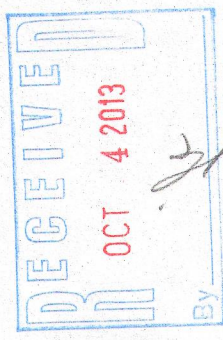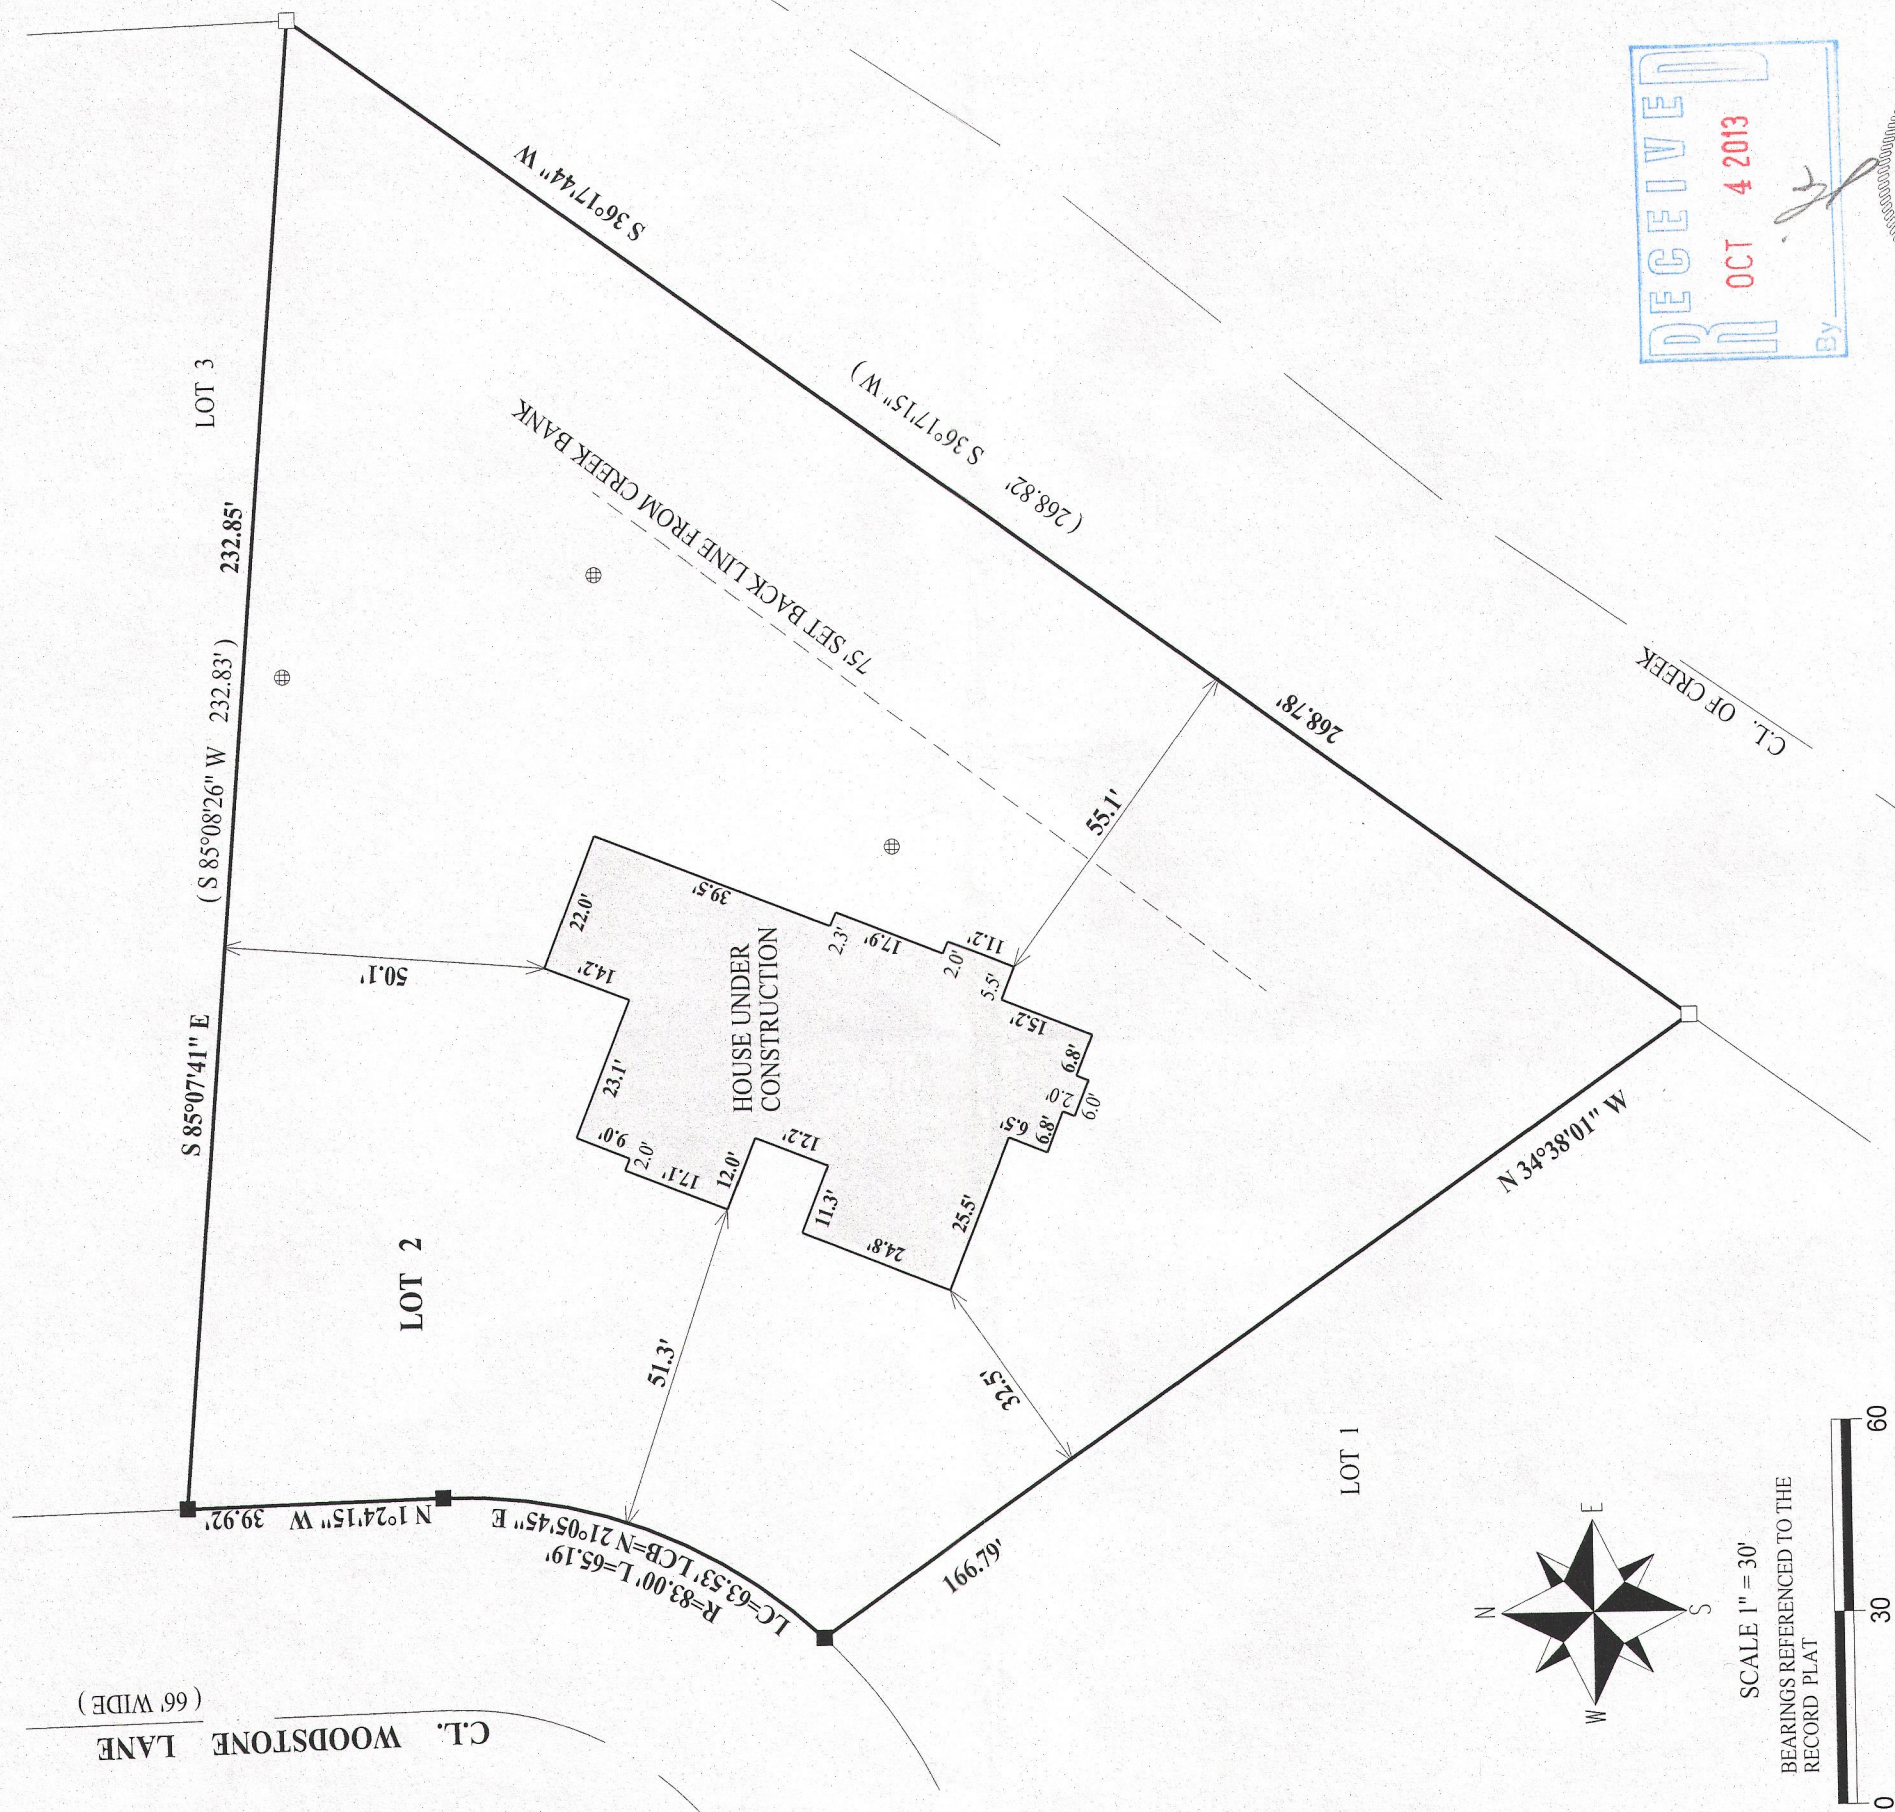

LEGEND

- ⊕ SOIL BORING
- FOUND IRON BAR
- SET IRON BAR

(XX) RECORDED AS

TAX ID # IWO 00002
JOB # 12-114AB

I have surveyed the above-described property and the above map is a true representation thereof and shows the size and location of the property, its exterior boundaries, the location and dimensions of all structures thereon, fences apparent easements and roadways and visible encroachments, if any.

This survey is made for the exclusive use of the present owners of the property, and also those who purchase, mortgage, or insure the title thereto within one (1) year from date hereof; and as to them I warrant the accuracy of said survey map.

DATED THIS 21st, DAY OF AUGUST, 2012
DATE OF LAST REVISION: 9 / 04 / 2013

John P. Krott
JOHN KROTT S - 2258
Wisconsin Registered Land Surveyor
(original if signed in red)

117-3579