


PREPARED FOR
MARIANE WEIGLEY
2398 PACIFIC AVE.
APT. 207
SAN FRANCISCO CA. 94115


PLAT OF SURVEY OF

LOTS 6 THRU 11 AND THE SOUTH 10 FEET OF LOT 12 BLOCK 1,
EXCEPT THE SOUTH 30 FEET OF LOT 6 BLOCK 1 ALL IN LAKE
VIEW PARK SUBDIVISION, LOCATED IN THE NORTHEAST 1/4 OF
THE NORTHEAST OF SECTION 16, TOWN 1 NORTH, RANGE 17 EAST,
WALWORTH COUNTY, WISCONSIN.

KROTT SURVEYING INC.
(262) 248-3697
N 3705 WILLOW BEND LANE
LAKE GENEVA WI. 53147

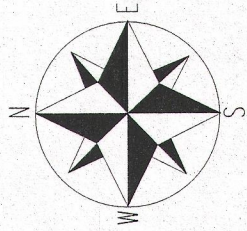

SCALE 1" = 20'
NOTE: BEARINGS ARE REFERENCED TO THE RECORD PLAT.

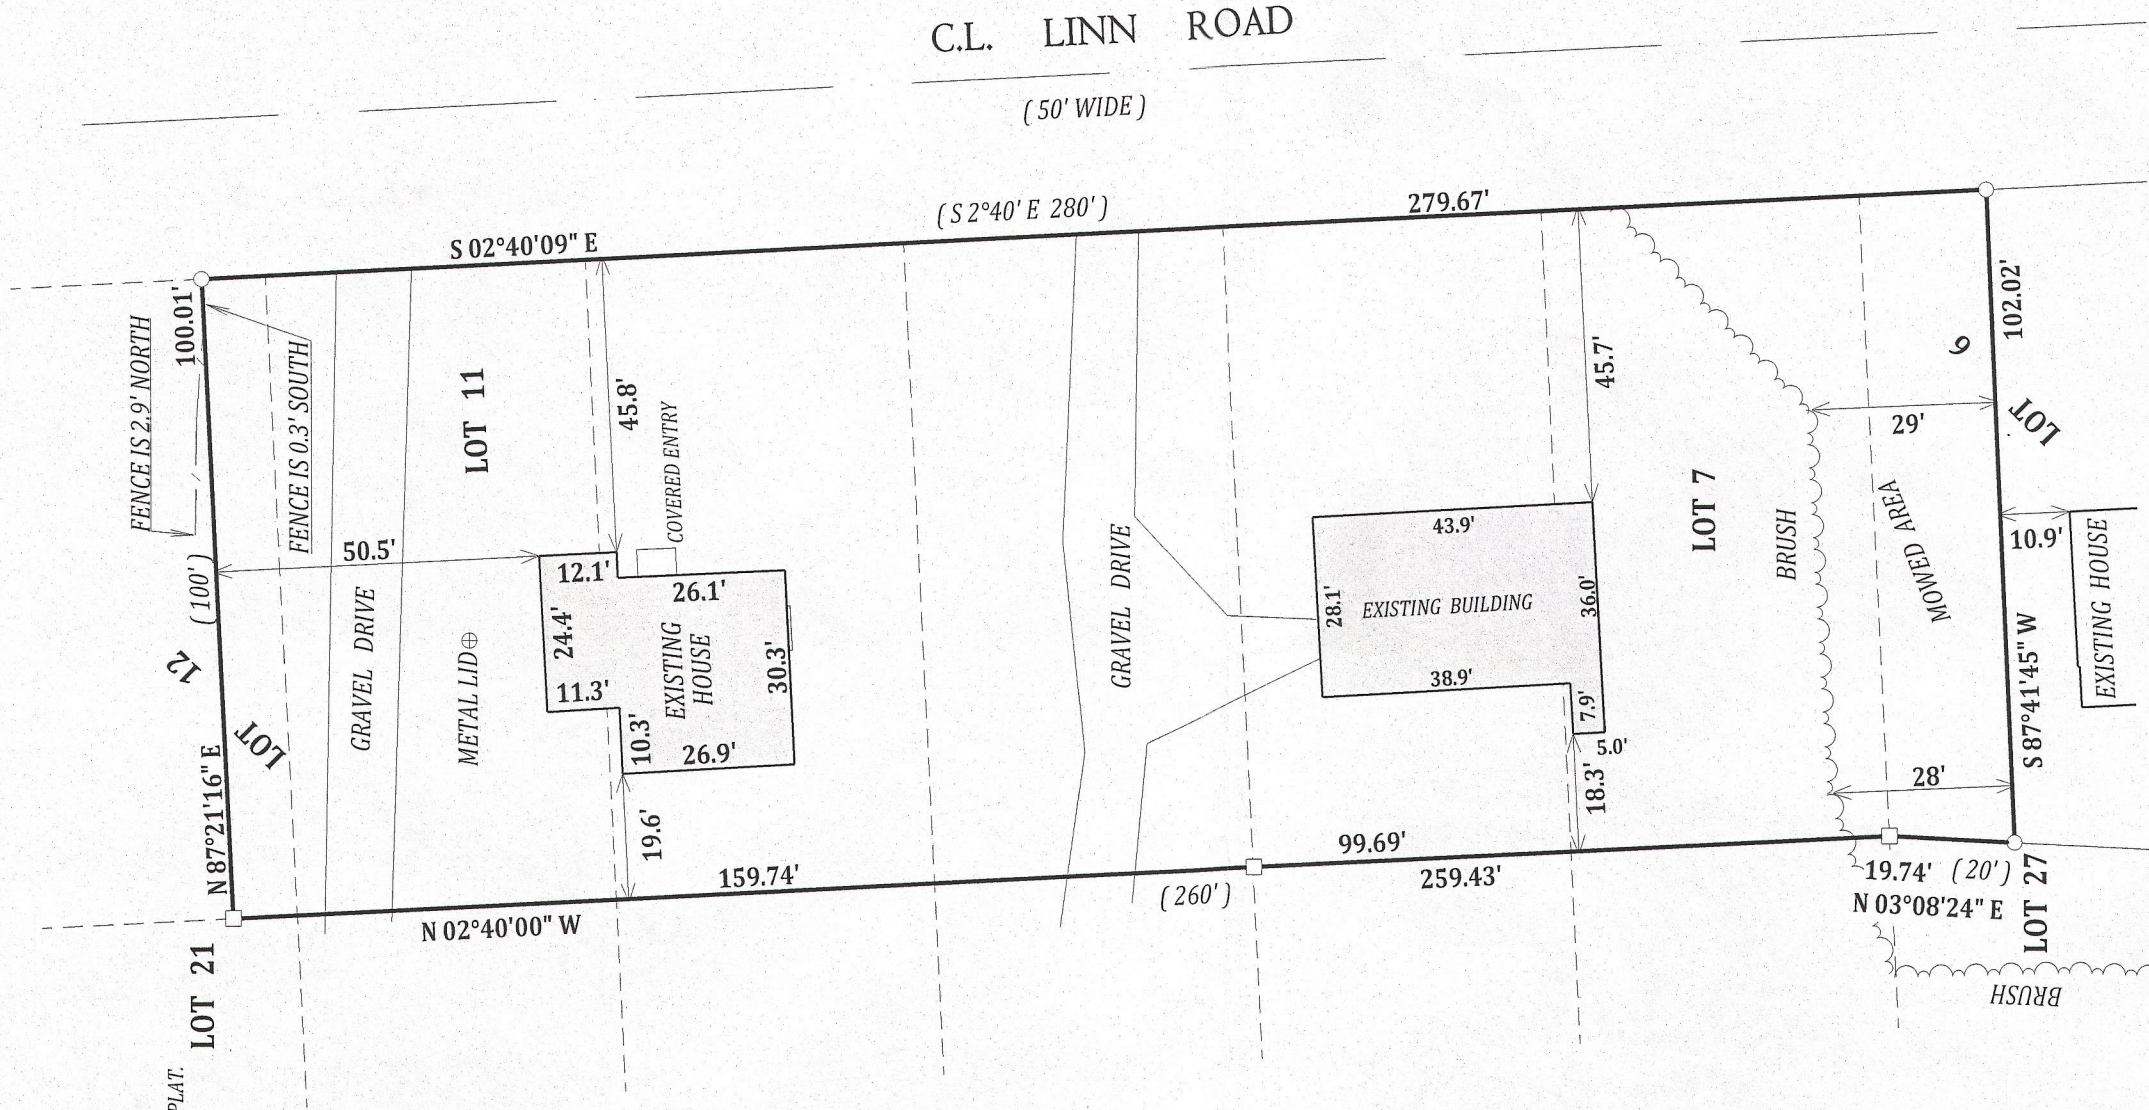

LEGEND


- FOUND IRON PIPE
- FOUND IRON BAR
- / — WOOD FENCE
- (XX) RECORDED AS

TAX ID # ILVP00001A2

JOB # 13-132

I have surveyed the above-described property and the above map is a true representation thereof and shows the size and location of the property, its exterior boundaries, the location and dimensions of all structures thereon, fences apparent easements and roadways and visible encroachments, if any.

This survey is made for the exclusive use of the present owners of the property, and also those who purchase, mortgage, or insure the title thereto within one (1) year from date hereof; and as to them I warrant the accuracy of said survey map.

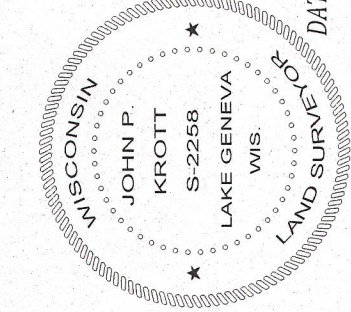

DATED THIS 4th DAY OF SEPTEMBER 2013

John P. Krott
JOHN P. KROTT S-2258

WISCONSIN REGISTERED LAND SURVEYOR
(NOTE: THIS IS NOT A CERTIFIED COPY
UNLESS SIGNED IN RED INK)

117-3581