
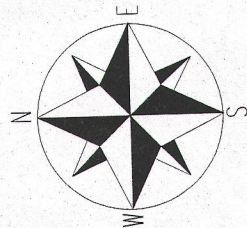


KROTT SURVEYING INC.
(262) 248-3697
N 3705 WILLOW BEND LANE
LAKE GENEVA WI. 53147

PLAT OF SURVEY OF

LOTS 10, 11 AND 14 IN BLOCK 5 IN LAKE GENEVA TERRACE, ACCORDING
TO THE PLAT THEREOF OF RECORD IN THE OFFICE OF THE REGISTER OF
DEEDS FOR WALWORTH COUNTY, WISCONSIN.

PREPARED FOR
BECKY MERWIN
THE RAULAND AGENCY
PO. BOX 159
WALWORTH WI. 53184

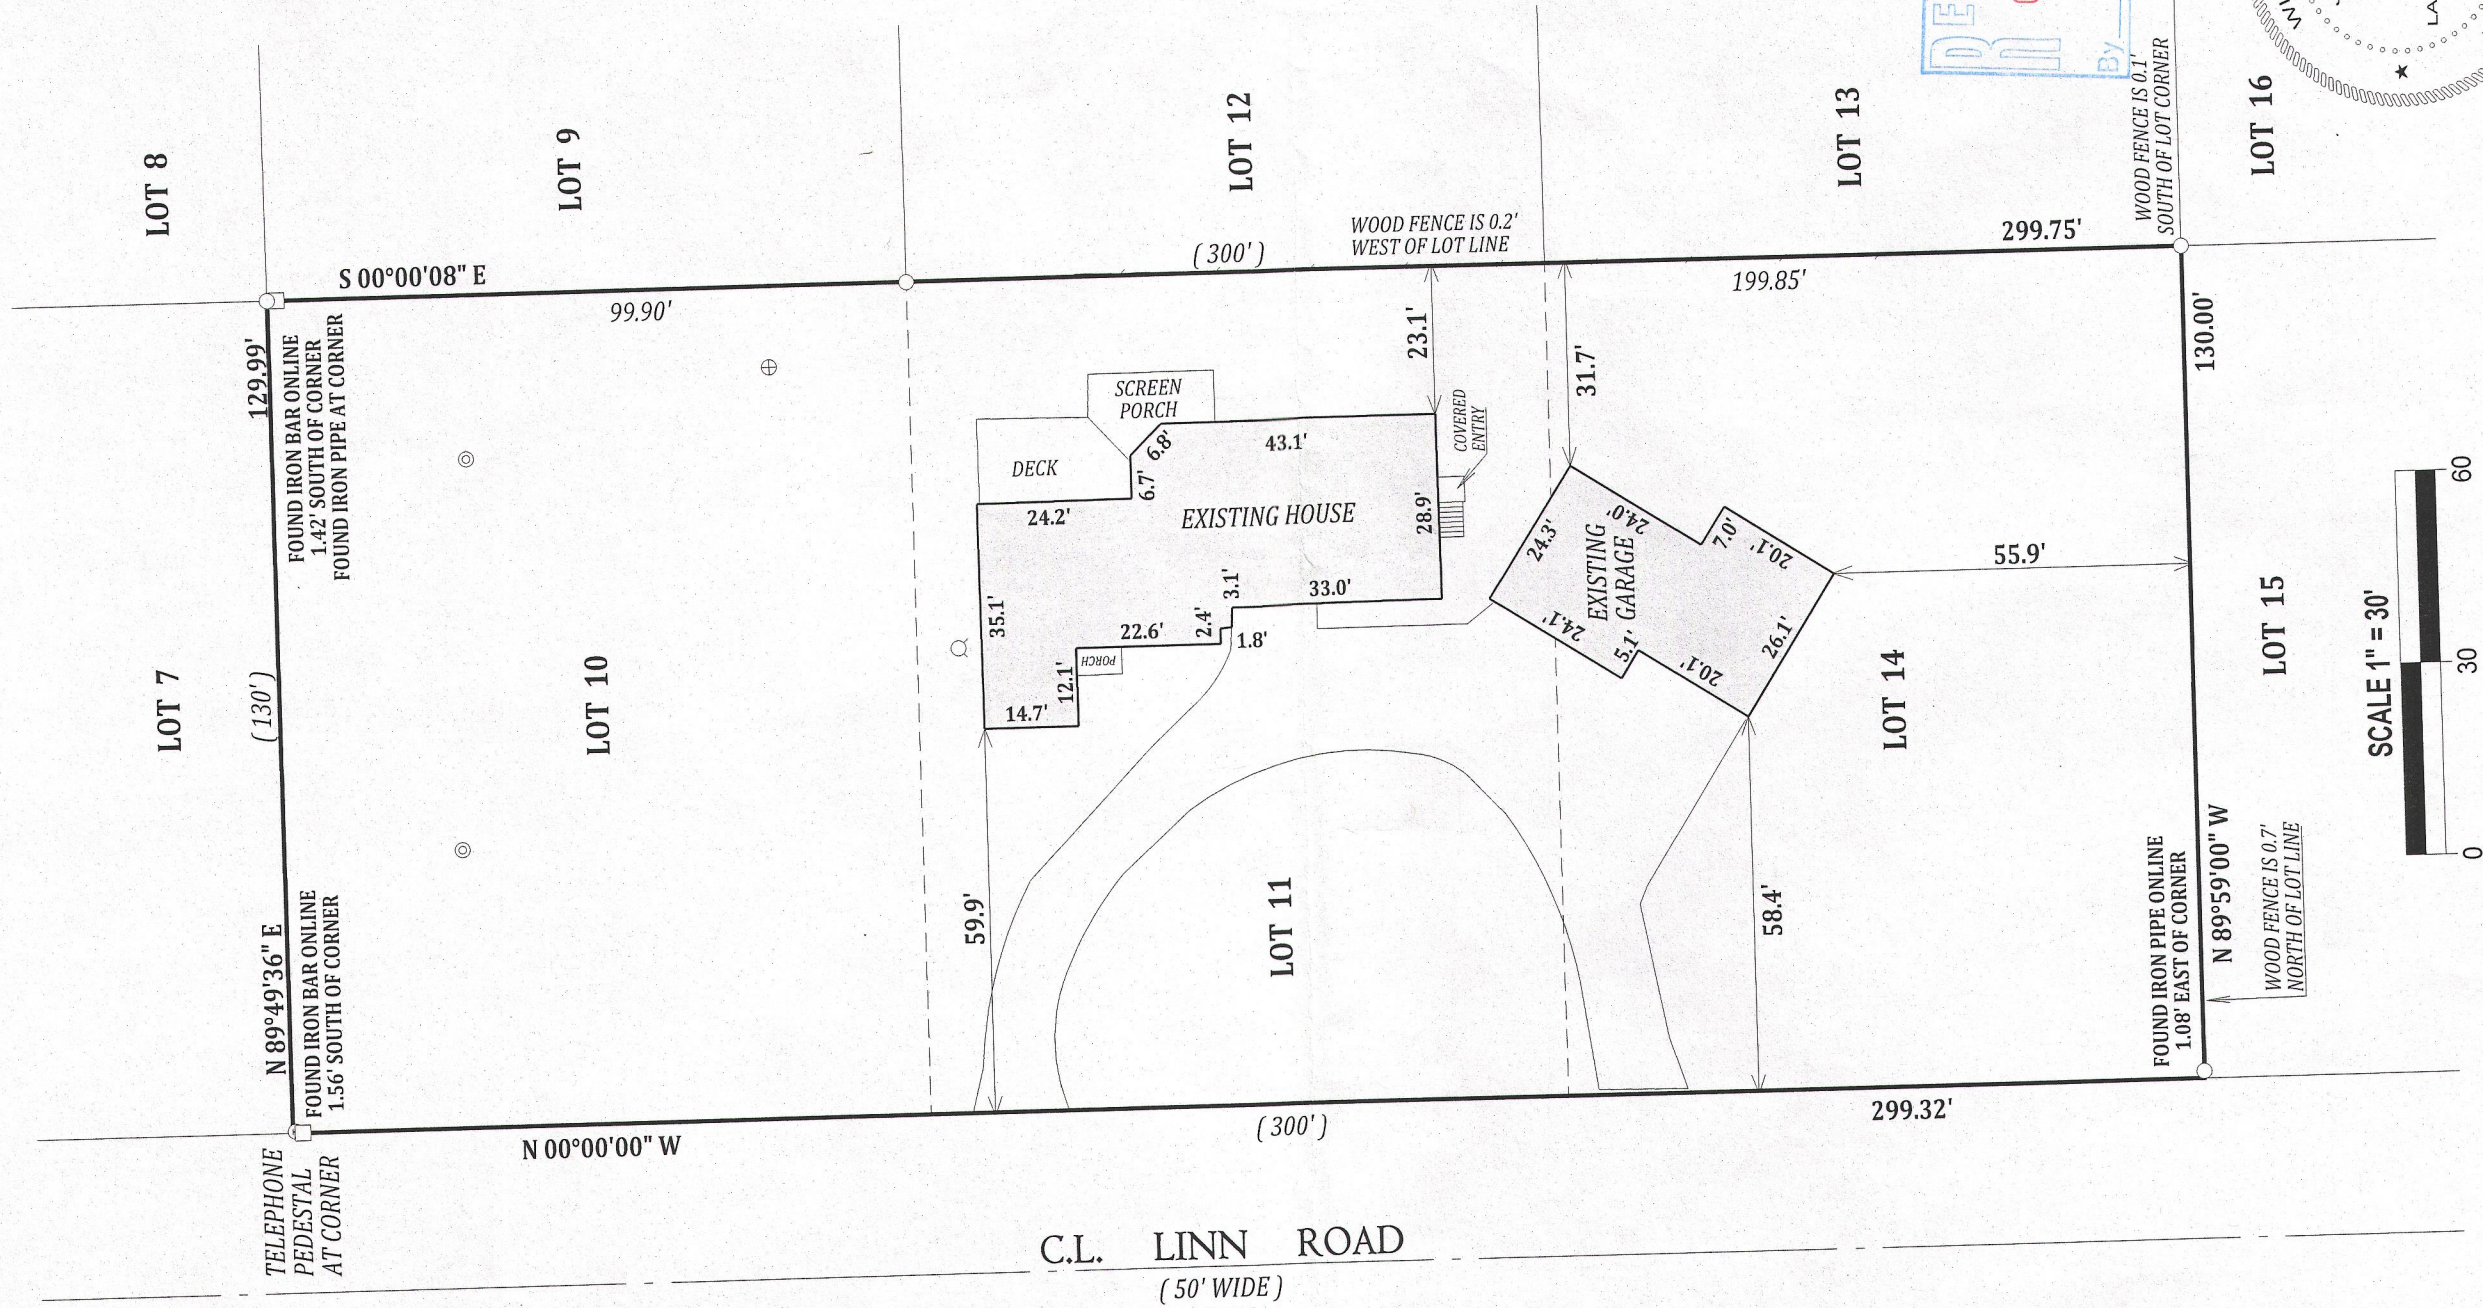

NOTE: BEARINGS ARE REFERENCED TO THE RECORD PLAT.

LEGEND

- FOUND IRON PIPE
- FOUND IRON BAR
- ⊕ CONCRETE ACCESS COVER
- ⊙ WELL
- ⊙ 4" DIA. P.V.C. PIPE



(XX) RECORDED AS

TAX ID # ILGT00020C

JOB # 13-141

I have surveyed the above-described property and the above map is a true representation thereof and shows the size and location of the property, its exterior boundaries, the location and dimensions of all structures thereon, fences apparent easements and roadways and visible encroachments, if any.

This survey is made for the exclusive use of the present owners of the property, and also those who purchase, mortgage, or insure the title thereto within one (1) year from date hereof; and as to them I warrant the accuracy of said survey map.

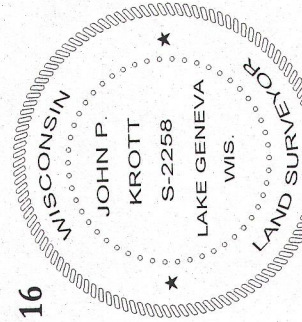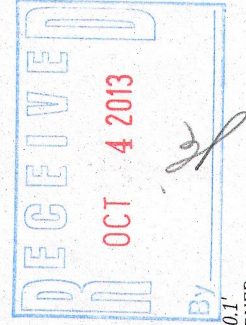

DATED THIS 17th DAY OF SEPTEMBER 2013

JOHN P. KROTT S-2258
WISCONSIN REGISTERED LAND SURVEYOR
(NOTE: THIS IS NOT A CERTIFIED COPY
UNLESS SIGNED IN RED INK)

117-3582